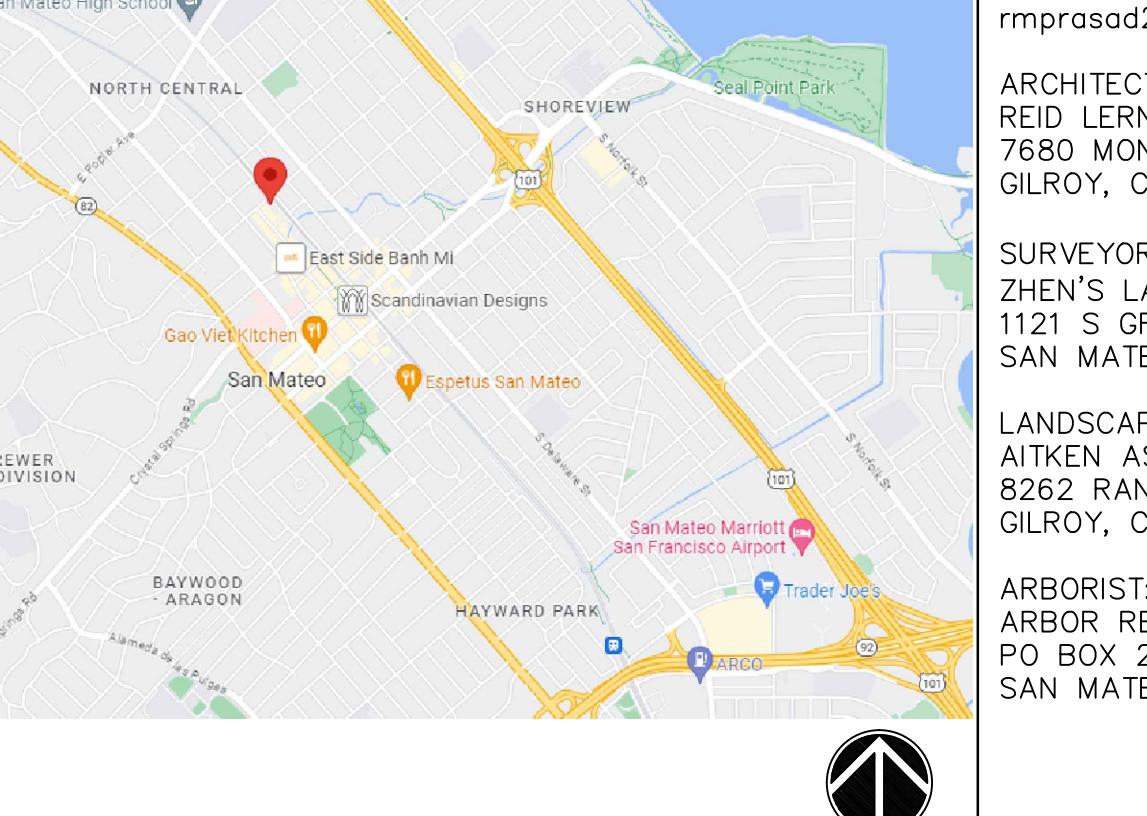
 
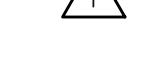
 


Site Address: 328 TILTON AVE, SAN MATEO		
APN: 032-323-010		
Zoning Classification: C1-2/R5		
Lot Size (Sq. Ft.): 5,600		
Permitted Floor Area Ratio: 3.0		
Maximum Permitted Floor Area (Sq. Ft.): 16,800		
	<i>Existing:</i>	<i>Proposed:</i>
<i>Floor Area (Sq. Ft.):¹</i>		
Main Structure(s):	2,569	5,782
Detached Accessory Structures:	510	0
Exemptions: ²		
Total Floor Area:	3,079	5,782
Total Floor Area for Parking Requirements: ³		
Total Covered Parking Stalls:		
Total Uncovered Parking Stalls:		
Total Bicycle Parking Spaces		
Total Long-Term Bicycle Parking Spaces		
Total Short-Term Bicycle Parking Spaces		
Total Number of Units	4	
Unit Type(s)	No.	Proposed Size
Studio	0	0
1-bedroom	2	690
4-bedroom	2	1,360
List of All Trees on Site including Species and Size:	MAPLE TREE, 24" DBH	
Total area of new and rehabilitated landscape area (Sq. Ft.):	968	
Cubic Yards of Soil Disturbance: <i>(required in order to determine if a Stormwater Pollution Prevention Construction Permit is required)</i>	CUT: 120 FILL: 35 TOTAL EARTHWORK: 85	

328 TILTON AVENUE
SAN MATEO, CA 94401

TILTON APARTMENTS
NEW MULTI-FAMILY APARTMENTS

VICINITY MAP (NO SCALE)	PROJECT DIRECTORY	PROJECT DATA	SCOPE OF WORK	DRAWINGS INDEX
	<p>PROPERTY OWNER/APPLICANT: ANDRIKA PRASAD 328 TILTON AVENUE SAN MATEO, CA 94401 rmprasad27@yahoo.com</p> <p>ARCHITECT: REID LERNER ARCHITECTS 7680 MONTEREY STREET, SUITE 105 GILROY, CA 95020</p> <p>SURVEYOR/CIVIL ENGINEER: ZHEN'S LAND SURVEYING CORP. 1121 S GRANT STREET SAN MATEO, CA 94402</p> <p>LANDSCAPE ARCHITECT: AITKEN ASSOCIATES LANDSCAPE ARCHITECTS 8262 RANCHO REAL GILROY, CA 95020</p> <p>ARBORIST: ARBOR RESOURCES PO BOX 25295 SAN MATEO, CA 94402</p>	<p>APN: 032-323-010 LOT AREA: 5,600 SF (50'X112')</p> <p>OCCUPANCY GROUP: 'R-2' (MULTIFAMILY) & 'U' (CARPORT)</p> <p>TYPE OF CONSTRUCTION: VB (SPRINKLERED)</p> <p>No. OF STORIES: 2 (TWO) </p> <p>BUILDING HEIGHT: 26'-0" </p> <p>ZONING: C1-2/R5</p> <p>FLOOD ZONE:</p> <p>PARKING PROPOSED: 2 STALLS (SEE PARKING ANALYSIS) </p>	<p>1. BUILD 5,782 SQUARE FEET BUILDING INCLUDING 2,891 SQUARE FEET CARPORT (2) & MULTIFAMILY UNIT (1) WITH PATIO ON GROUND FLOOR AND 2,891 SQUARE FEET MULTIFAMILY UNITS (3) WITH BALCONIES ON UPPER FLOOR. THE UNIT ON THE GROUND FLOOR SHALL BE ADAPTABLE PER CBC-11A.</p> <p>2. ON-SITE IMPROVEMENTS INCLUDE BUILDING CARPORT, DRIVEWAY, ACCESSIBLE RAMP, PAVED YARD, WALKWAYS, FENCES, LANDSCAPE, AND MINOR GRADING.</p> <p>3. OFF-SITE IMPROVEMENTS INCLUDE INSTALLING NEW DRIVEWAY APPROACH, NEW SIDEWALK, NEW ADA RAMPS, AND JOINT TRENCH FOR UPGRADING UTILITY SERVICES TO PROPOSED BUILDING.</p> <p>ANY WORK IN PUBLIC RIGHT OF WAY REQUIRE A PERMIT FROM PUBLIC WORKS DEPARTMENT.</p> <p>NOTE: ALL EXISTING STRUCTURES, INCLUDING EXISTING HOUSE AND GARAGE, TO BE DEMOLISHED UNDER SEPARATE PERMITS.</p>	<p><u>ARCHITECTURAL</u></p> <p>A0 COVER SHEET A1 PROPOSED SITE PLAN A1.1 EXISTING SITE PLAN A2 PROPOSED GROUND FLOOR PLAN A3 PROPOSED 2ND FLOOR PLAN A3.1 EXISTING FLOOR PLAN @ SINGLE FAMILY HOME A3.2 EXISTING FLOOR PLAN @ GARAGE & MULTIFAMILY UNITS A4 PROPOSED ROOF PLAN A5 PROPOSED ELEVATIONS A6 PROPOSED ELEVATIONS A7 BUILDING SECTIONS A8 FLOOR AREA CALCULATION DIAGRAM A9 EXISTING ELEVATIONS A10 EXISTING ELEVATIONS A11 STREETSCAPE ELEVATIONS  A12 STREETSCAPE ELEVATIONS  A13 WINDOW LOCATION & PRIVACY DIAGRAM  A14 WINDOW SCHEDULE</p> <p><u>ARBORIST REPORT</u></p> <p>T-1 ARBORIST REPORT  T-2 ARBORIST REPORT & TREE PLANTING FORM</p> <p><u>LANDSCAPE</u></p> <p>L-1 PLANTING & LIGHTING PLAN L-2 IRRIGATION PLAN L-3 IRRIGATION & PLANTING DETAILS</p> <p><u>SURVEY</u></p> <p>1 TOPOGRAPHIC SURVEY </p> <p><u>CIVIL</u></p> <p>C1 GRADING & DRAINAGE PLAN C2.0 STORMWATER CONTROL PLAN C2.1 STORMWATER CONTROL PLAN C3 STORM DRAIN & UTILITY PLAN</p>
DEFERRED SUBMITTAL	APPLICABLE CODES & REQUIREMENTS	ALLOWABLE HEIGHT & AREA ANALYSIS	PARKING ANALYSIS	
1. FIRE SPRINKLER & FIRE ALARM SYSTEM DESIGN	<p>ALL WORK SHALL COMPLY WITH APPLICABLE CODES AND STANDARDS INCLUDING:</p> <p>2022 CALIFORNIA BUILDING CODE (CBC)</p> <p>2022 CALIFORNIA GREEN BUILDING STANDARDS CODE (CGBSC)</p> <p>2022 CALIFORNIA MECHANICAL CODE (CMC)</p> <p>2022 CALIFORNIA PLUMBING CODE (CPC)</p> <p>2022 CALIFORNIA ELECTRICAL CODE (CEC)</p> <p>2022 CALIFORNIA ENERGY CODE (CEnc)</p> <p>2022 CALIFORNIA FIRE CODE WITH CITY & COUNTY AMENDMENTS</p> <p>CITY OF SAN MATEO MUNICIPAL CODE</p> <p>OBTAIN PERMITS AND INSPECTION AS REQUIRED</p>		<p><u>VEHICLE PARKING:</u> REQUIRED: 0 THE SUBJECT SITE IS LOCATED WITHIN $\frac{1}{2}$ MILE OF A MAJOR TRANSIT STOP (CALTRAIN SAN MATEO STATION). PER AB2097, THE SUBJECT SITE IS EXEMPT FROM PARKING REQUIREMENT. </p> <p>PROPOSED: 2 COVERED STALLS</p> <p><u>BICYCLE PARKING:</u> REQUIRED: 6 (PER SMMC 27.64.262)  SHORT TERM: 1 (0.15 PER UNIT) LONG TERM: 5 (1.5 PER UNIT)</p> <p>PROPOSED: 6 SHORT TERM: 1 LONG TERM: 5</p>	


NO.	REVISION	DATE	BY
1	△	PLANCHET COMMENTS	03-25-24
2	△	PLANCHET COMMENTS	06-25-24
3	△	PLANCHET COMMENTS	11-22-24
4	△		
5	△		
TILTON APARTMENTS
NEW MULTI-FAMILY APARTMENTS
328 TILTON AVENUE
SAN MATEO, CA 94401

COVER SHEET



Drawn	MM
Checked	RL
Date	10/17/23
Scale	AS NOTED
For	PLANNING REVIEW
Sheet	

A0

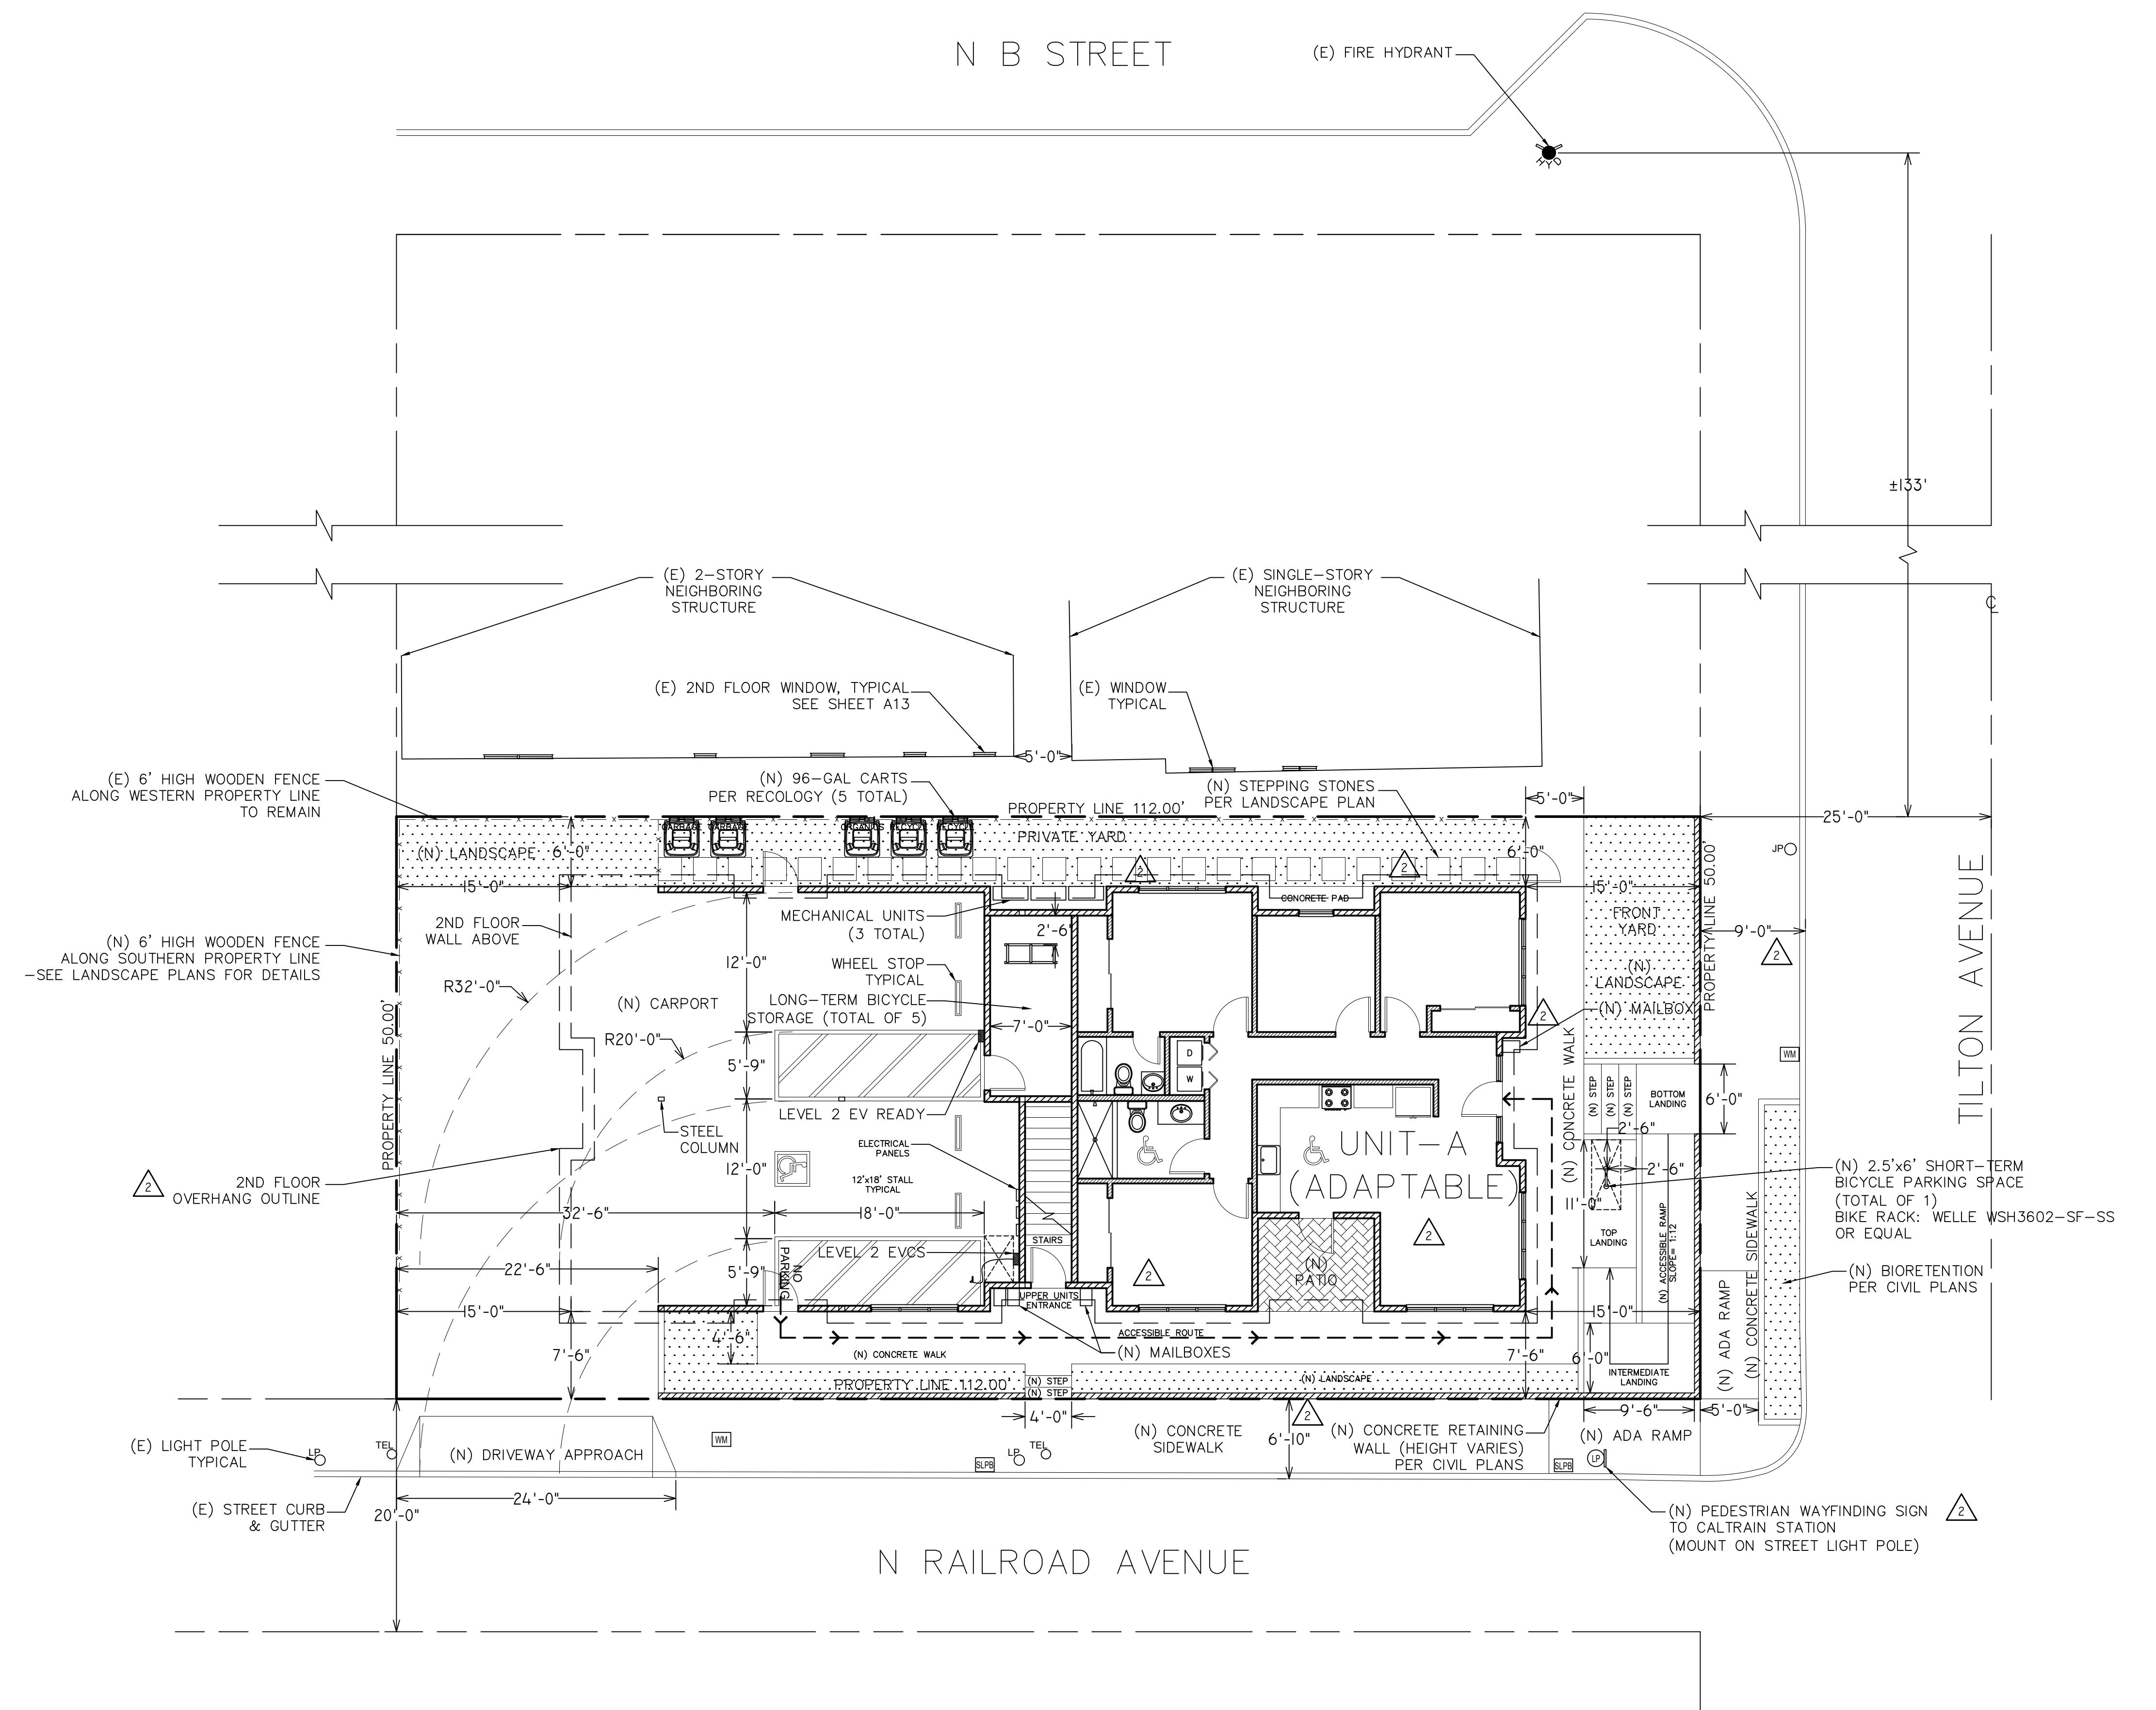

PROPOSED SITE PLAN

SCALE: 1/8" = 1'-0"

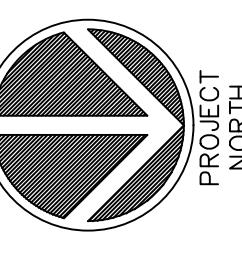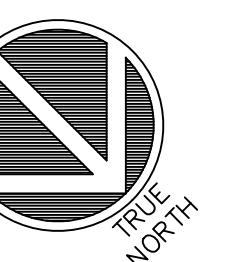

A'


Drawn	MM
Checked	RL
Date	10/17/23
Scale	AS NOTED
For	PLANNING REVIEW

TILTON APARTMENTS
NEW MULTI-FAMILY APARTMENTS
328 TILTON AVENUE
SAN MATEO, CA 94401

PROPOSED SITE PLAN

REID LERNER ARCHITECTS
PHONE 408-842-9942
REIDLERNER@YAHOO.COM
7680 MONTEREY ST #105
GILROY, CA 95020



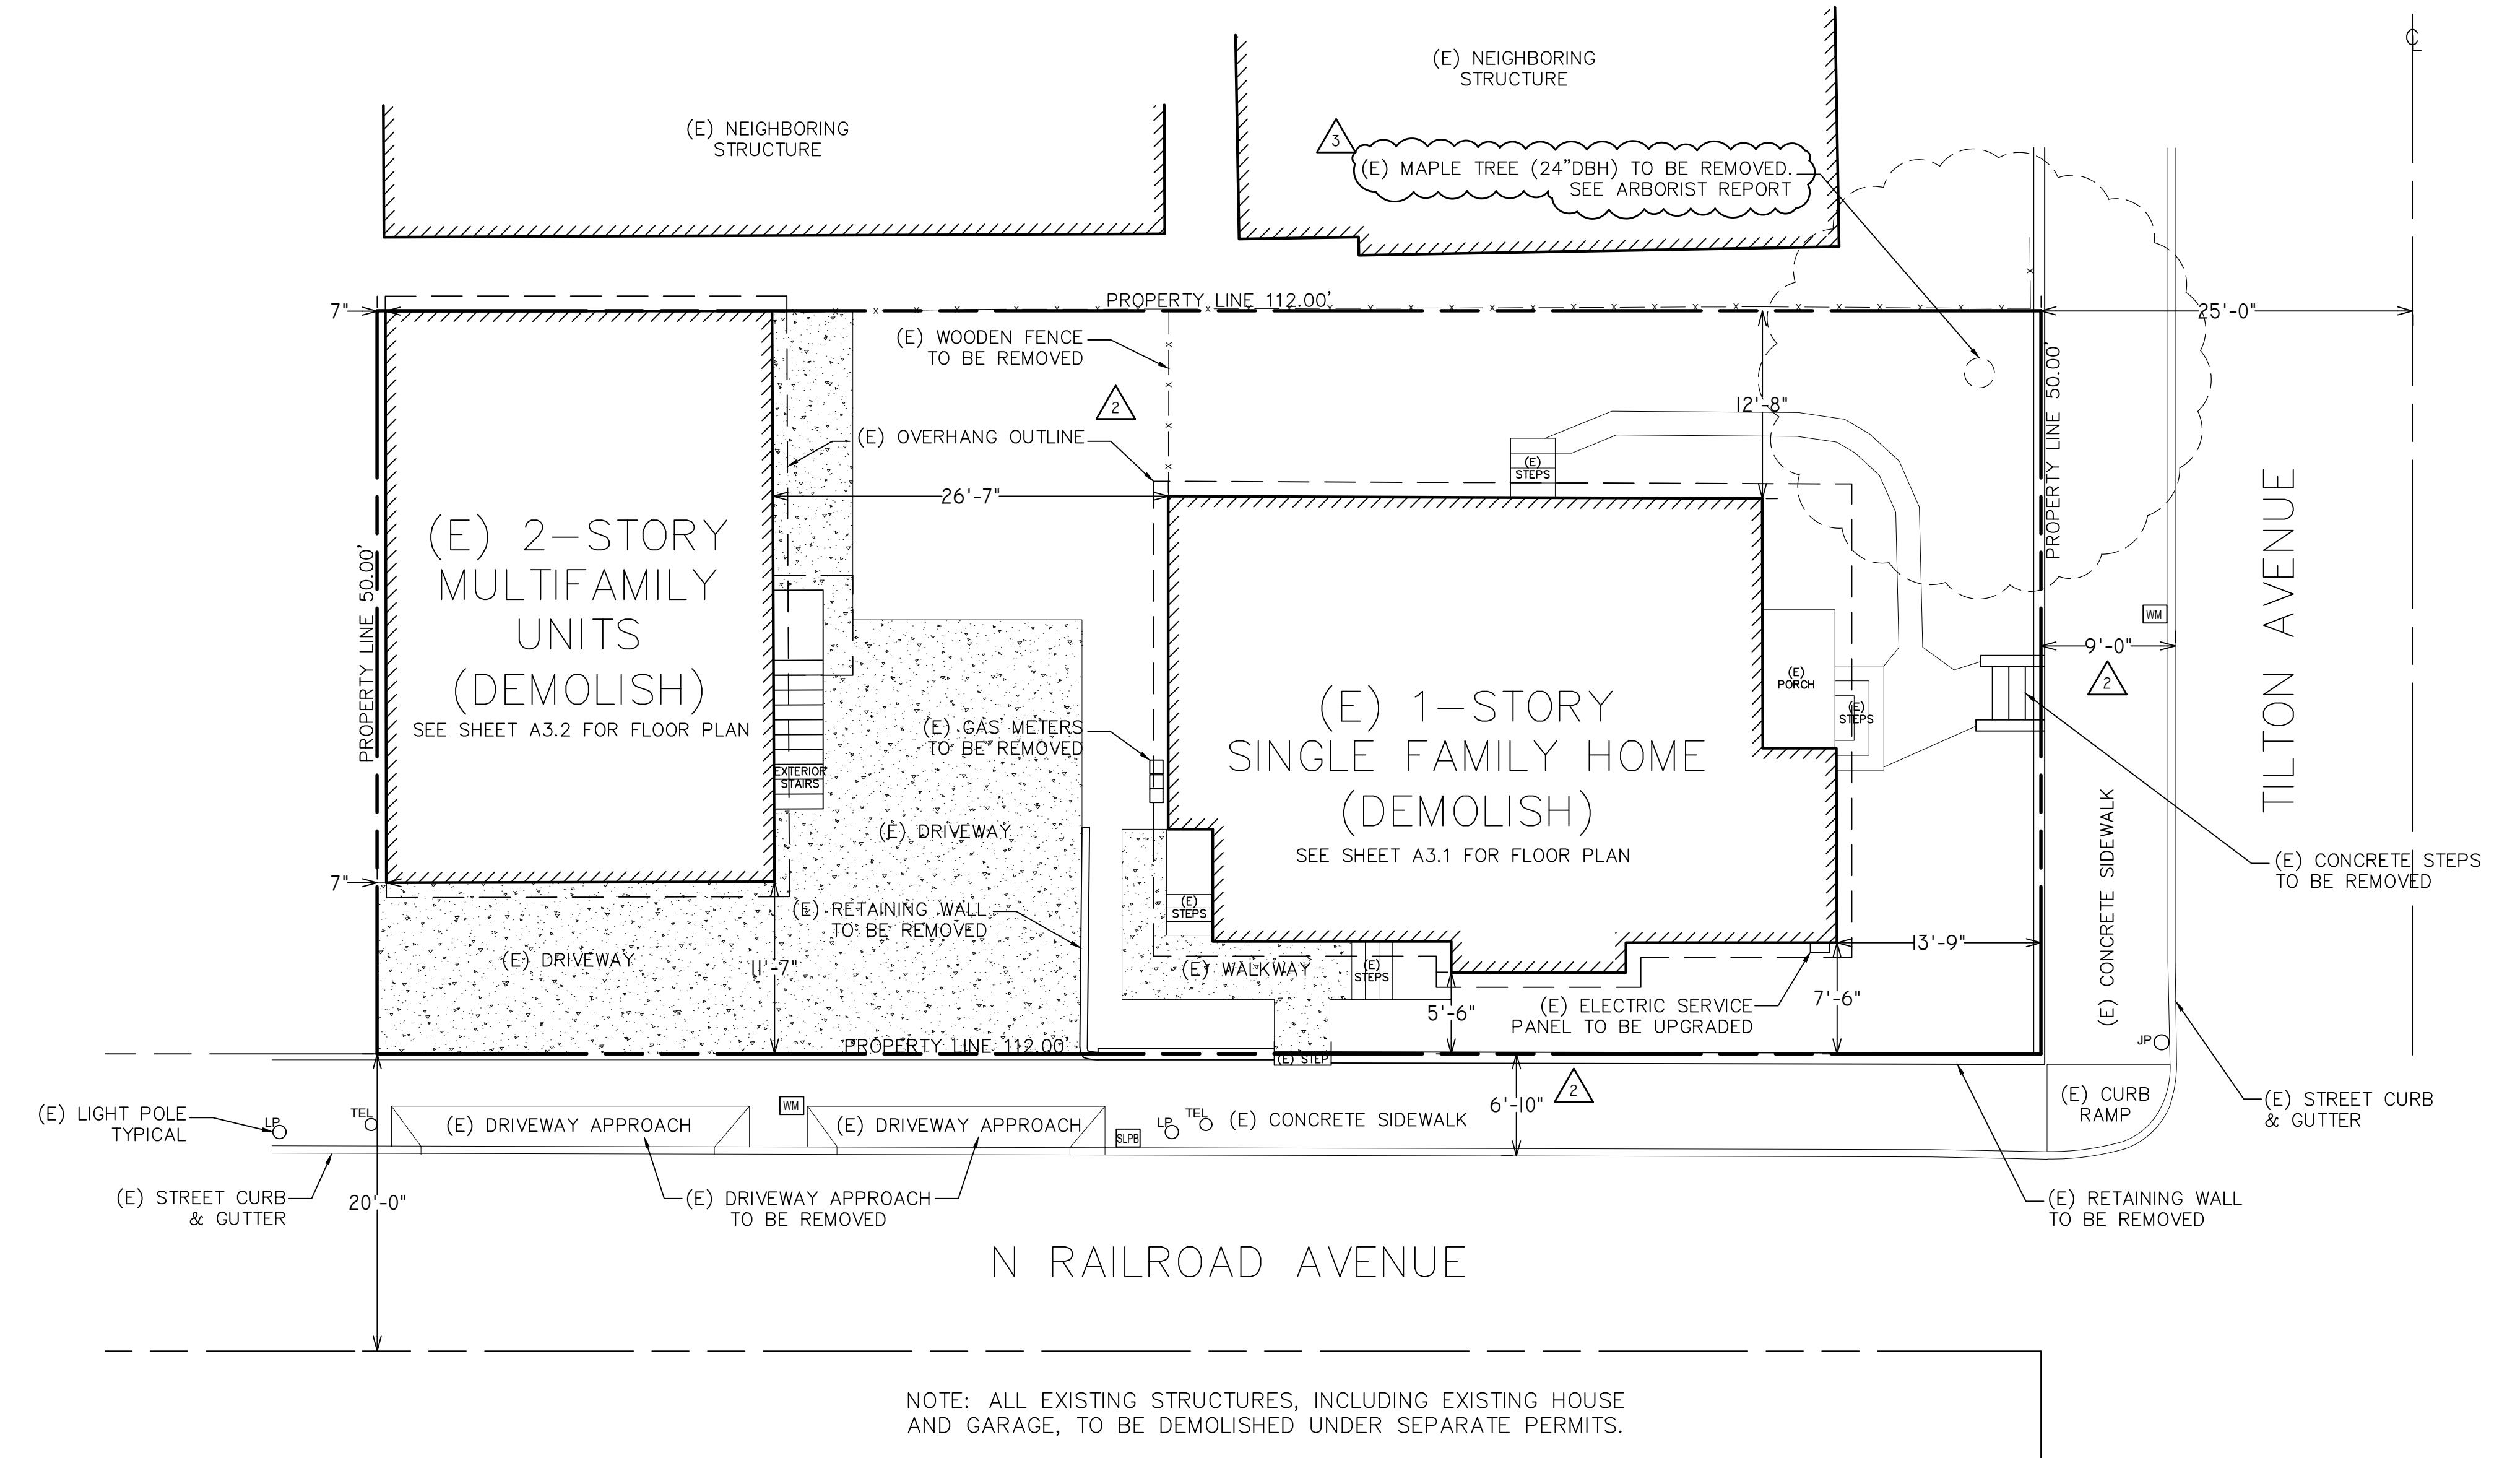

EXISTING SITE PLAN

SCALE: 1/8" = 1'-0"

0 8' 16'

Drawn	MM
Checked	RL
Date	10/17/23
Scale	AS NOTED
For	PLANNING REVIEW
Sheet	




REID LERNER ARCHITECTS
PHONE 408-542-9942
REIDLERNER@GMAIL.COM
7660 MONTEREY ST #105
GILROY, CA 95020

TILTON APARTMENTS
NEW MULTI-FAMILY APARTMENTS
328 TILTON AVENUE
SAN MATEO, CA 94401

EXISTING SITE PLAN

A1.1

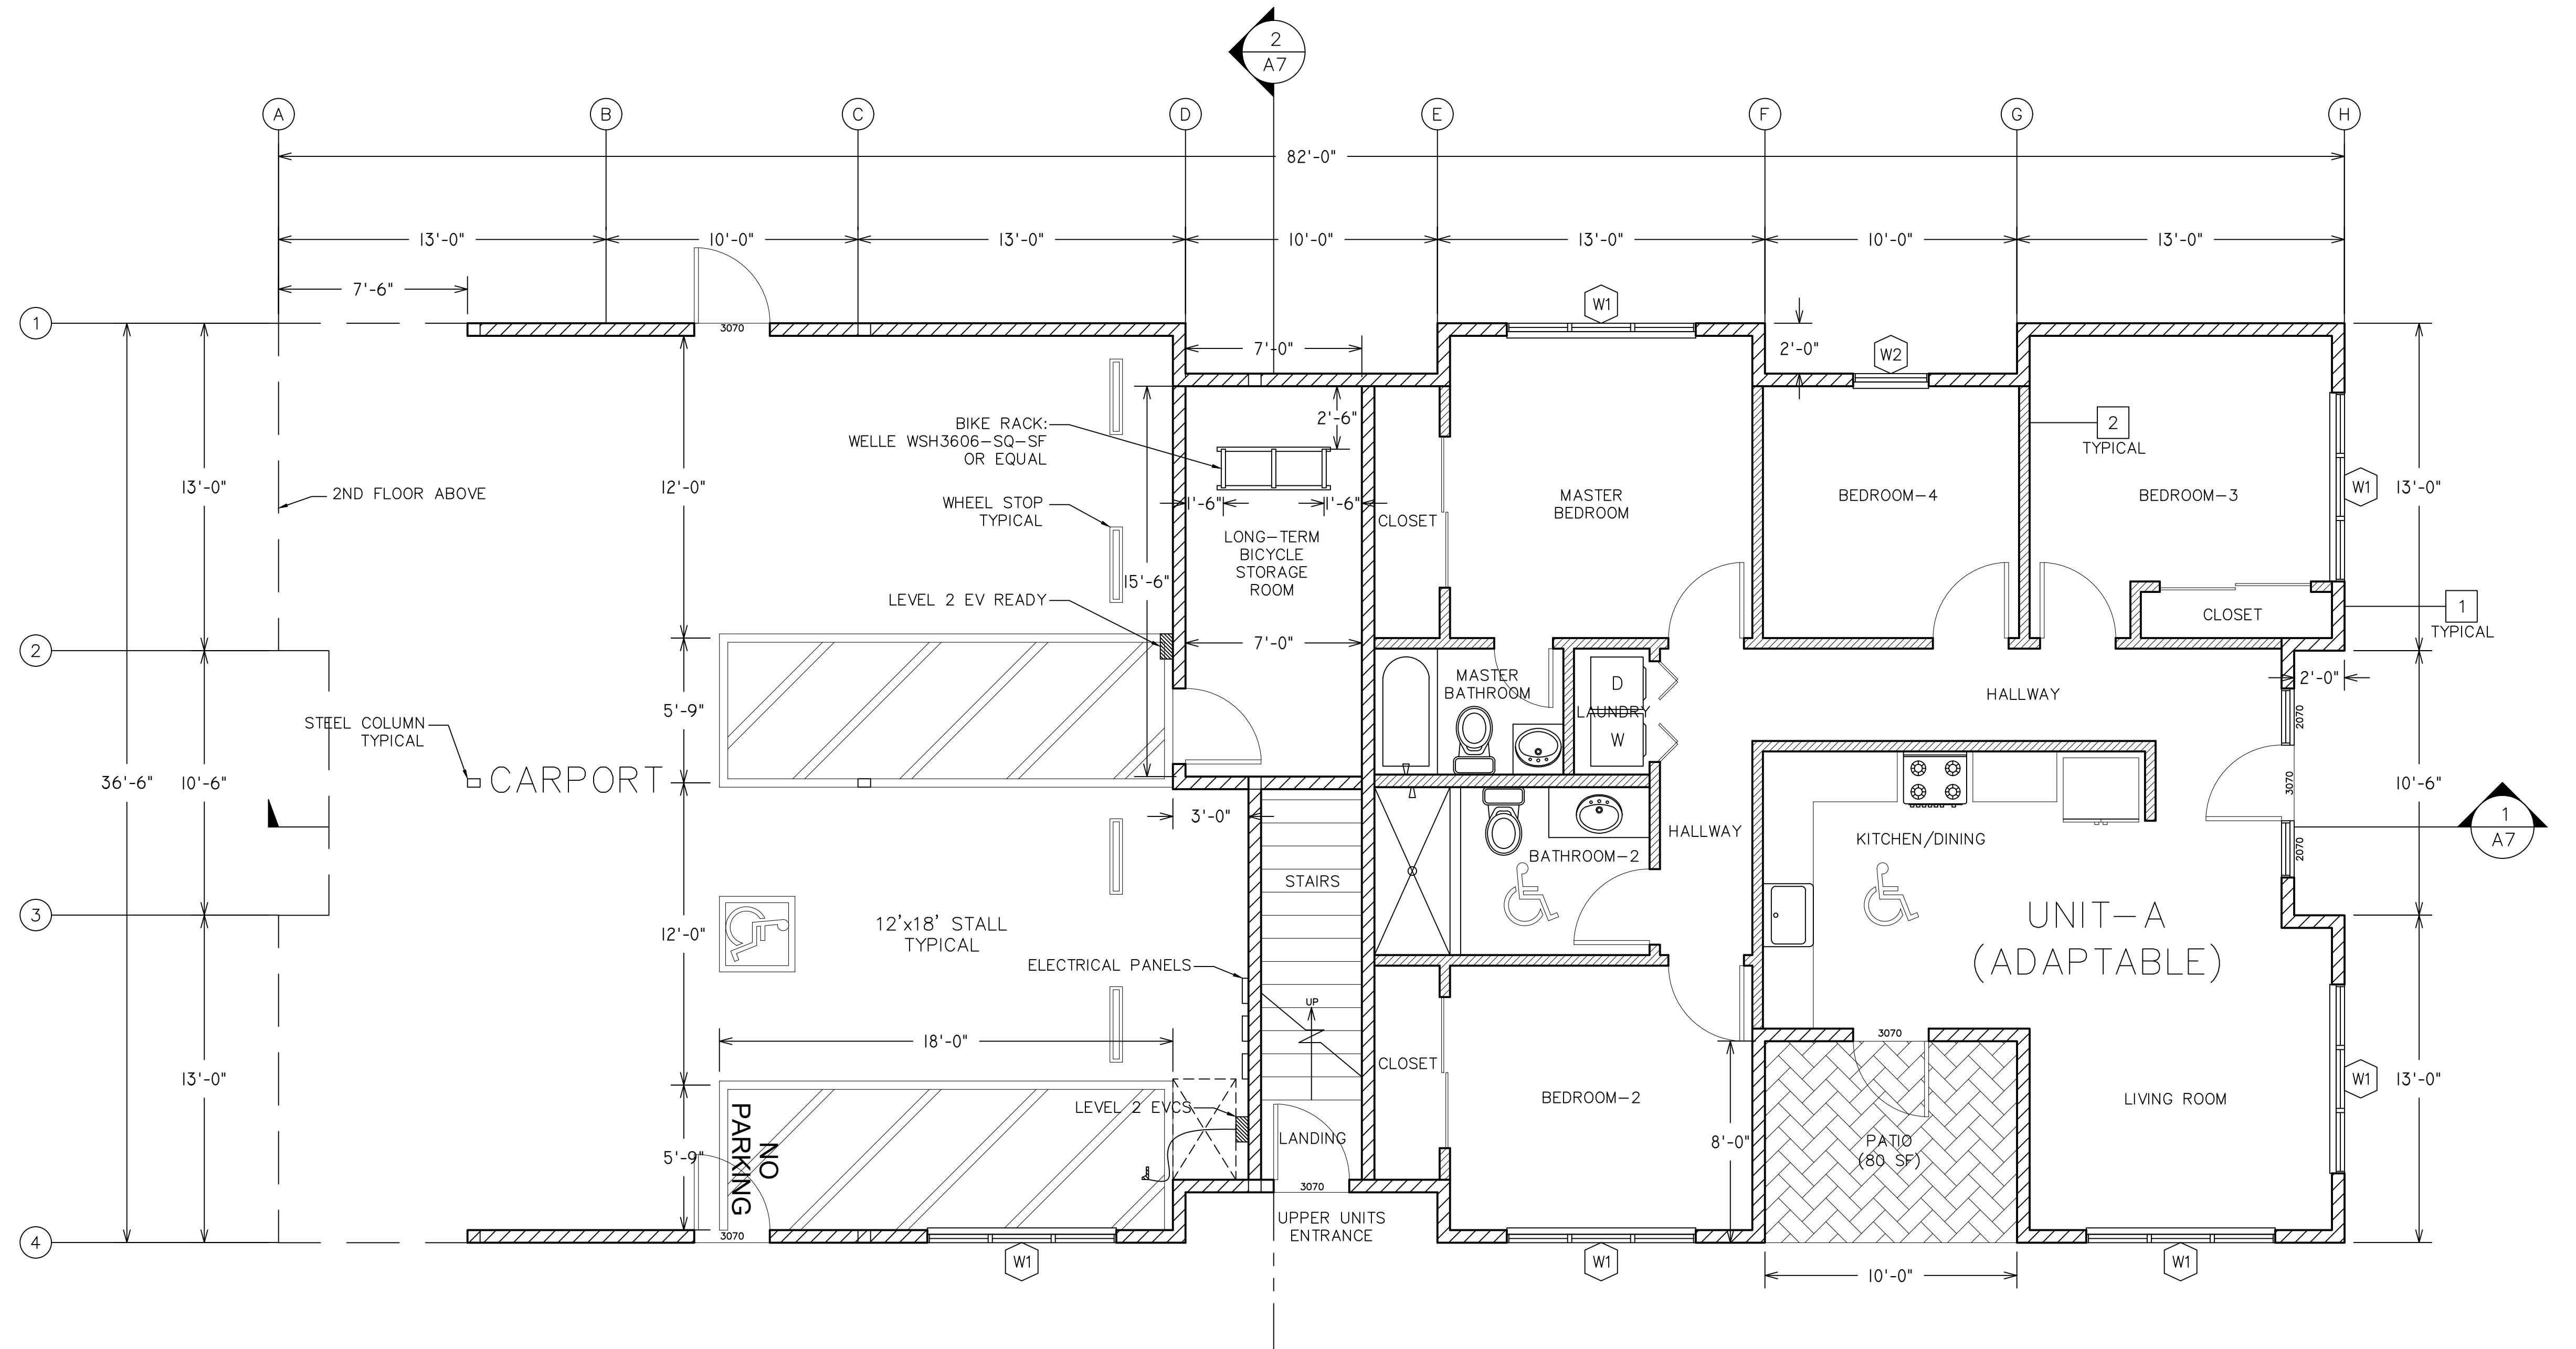

NOTE:
SEE WINDOW SCHEDULE SHEET A14.

WALL SCHEDULE

WALL SCHEDULE	
LEGEND	DESCRIPTION
1 	NEW EXTERIOR WALL: 2X WOOD STUDS WITH GYPSUM WALLBOARD INTERIOR SIDE & WOOD SIDING EXTERIOR SIDE
2 	NEW INTERIOR WALL: 2X WOOD STUDS WITH GYPSUM WALLBOARD BOTH SIDES

PROPOSED GROUND FLOOR PLAN

SCALE: 1/4" = 1'-0"

0 4' 8

Drawn	MM
Checked	RL
Date	10/17/23
Scale	AS NOTED
For	PLANNING REVIEW

A2

TILTON APARTMENTS
NEW MULTI-FAMILY APARTMENTS
328 TILTON AVENUE
SAN MATEO, CA 94401

PROPOSED GROUND FLOOR PLAN

REID LERNER ARCHITECTS

PHONE 408-842-9942

REIDLERNER@YAHOO.COM

7680 MONTEREY ST #105

GILROY, CA 95020

REID LERNER
LICENCED ARCHITECT
REIDLERNER
STATE OF CALIFORNIA
No. C 19293
REN: 31 AUG 2025


NO.	REVISION	DATE	BY
	PLANCHETTE CORPENS	10/23/23	



REID LERNER ARCHITECTS
PHONE 408-42-9942
REIDLERNER@GMAIL.COM
7680 MONTEREY ST #105
GILROY, CA 95020

TILTON APARTMENTS
NEW MULTI-FAMILY APARTMENTS
328 TILTON AVENUE
SAN MATEO, CA 94401

PROPOSED 2ND
FLOOR PLAN

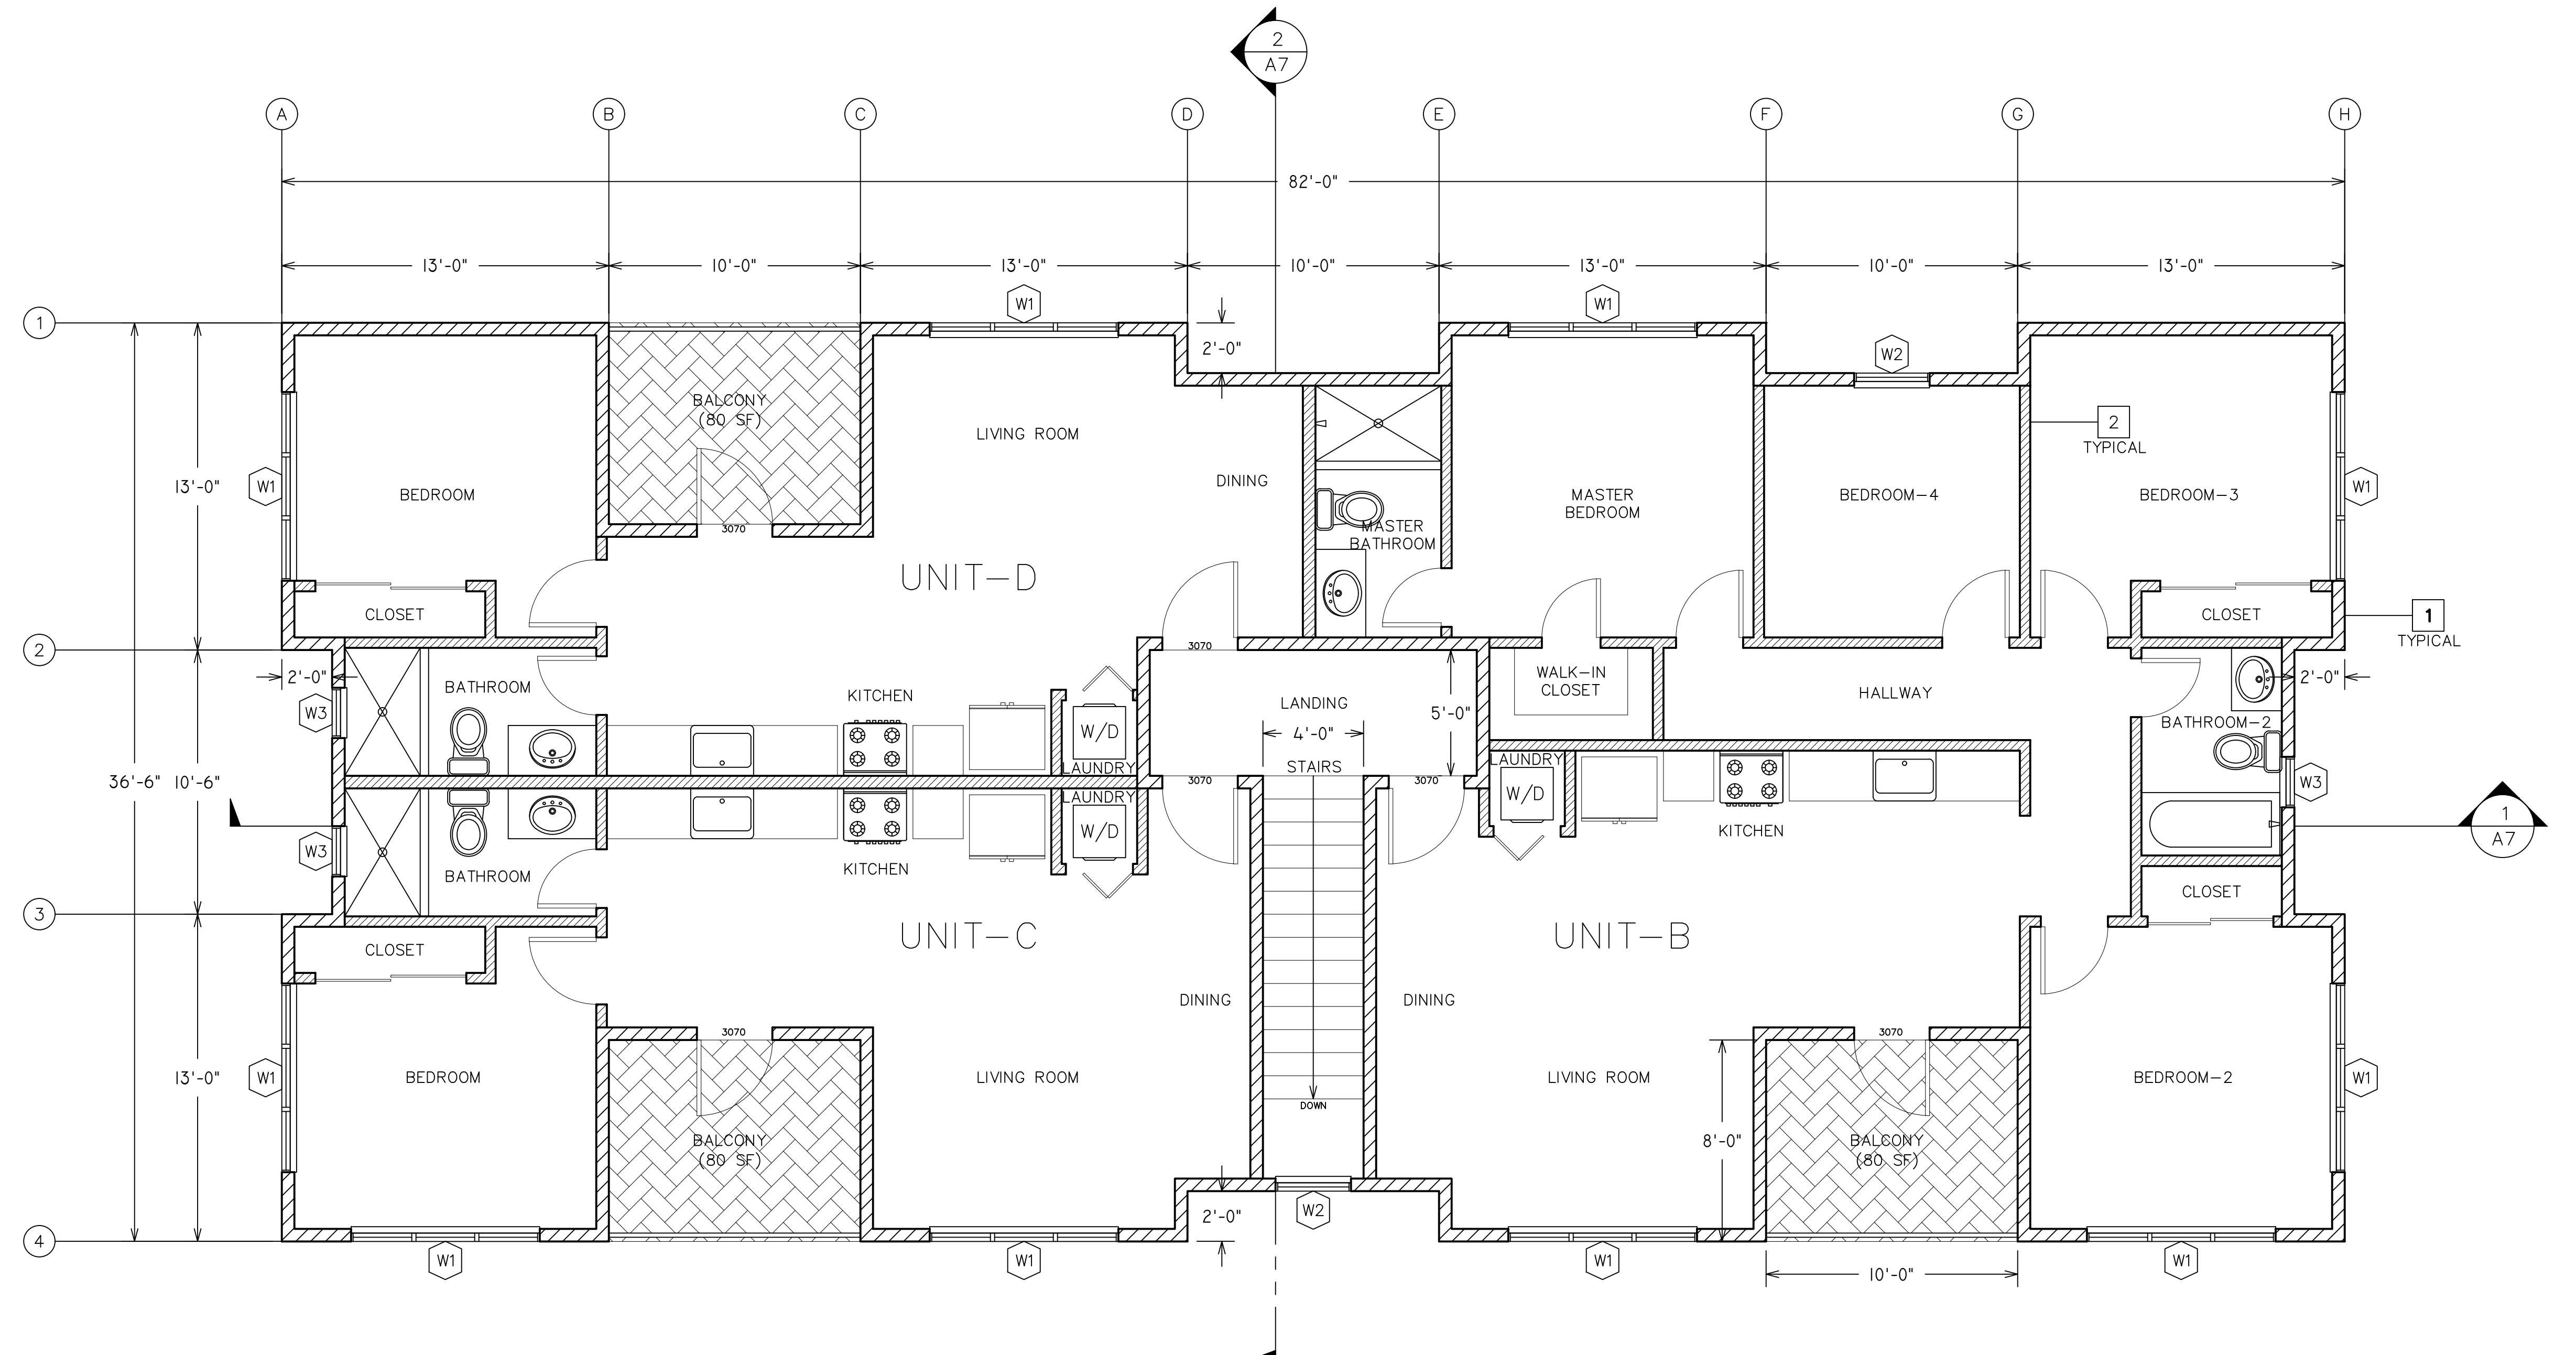


NOTE:
SEE WINDOW SCHEDULE SHEET A14.

WALL SCHEDULE

LEGEND	DESCRIPTION
1	NEW EXTERIOR WALL: 2X WOOD STUD WITH GYPSUM WALLBOARD INTERIOR SIDE & WOOD SIDING EXTERIOR SIDE
2	NEW INTERIOR WALL: 2X WOOD STUD WITH GYPSUM WALLBOARD BOTH SIDES

PROPOSED 2ND FLOOR PLAN

SCALE: 1/4" = 1'-0"

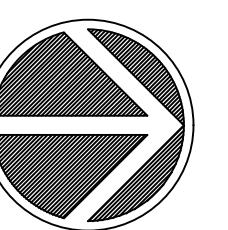

A3

Drawn	MM
Checked	RL
Date	10/17/23
Scale	AS NOTED
For	PLANNING REVIEW
Sheet	




REID LERNER ARCHITECTS
PHONE 408-842-9942
REIDLERNER@YAHOO.COM
7680 MONTEREY ST #105
GILROY, CA 95020

TILTON APARTMENTS
NEW MULTI-FAMILY APARTMENTS
328 TILTON AVENUE
SAN MATEO, CA 94401


EXISTING FLOOR PLAN @ SINGLE FAMILY HOME

drawn	MM
checked	RL
date	10/17/23
scale	AS NOTED
or	PLANNING REVIEW

A3.1

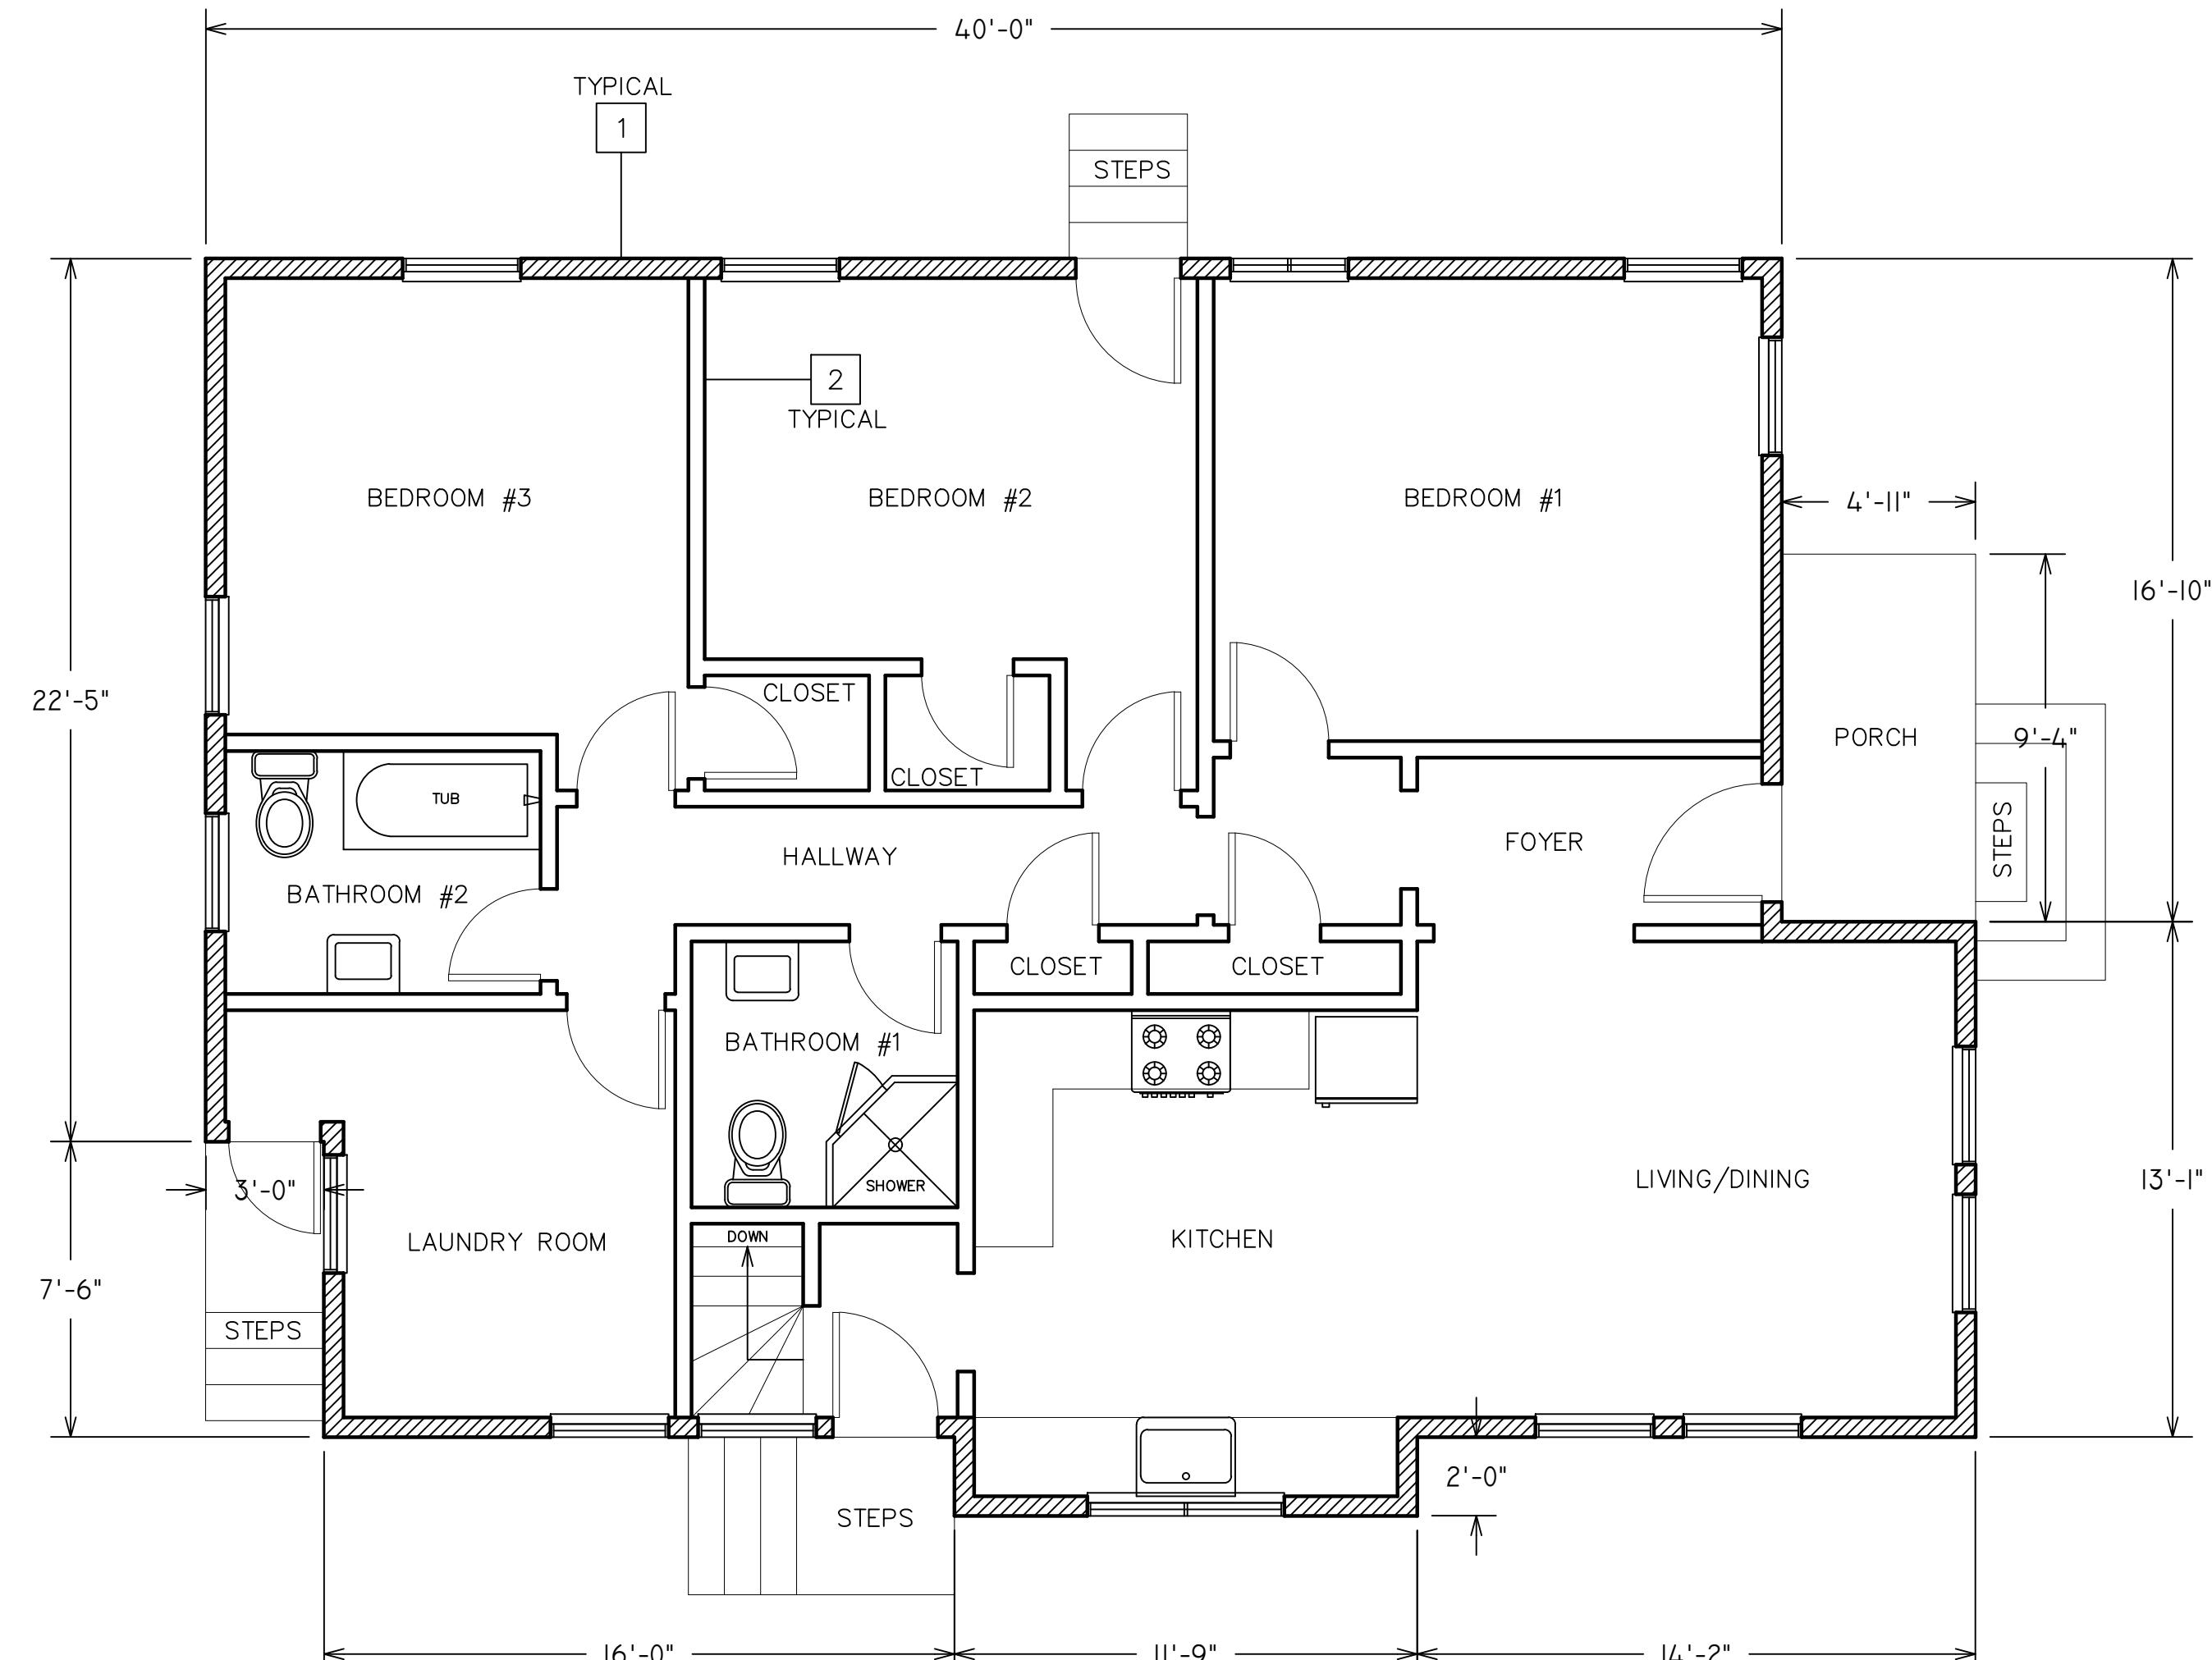

EXISTING GROUND FLOOR PLAN


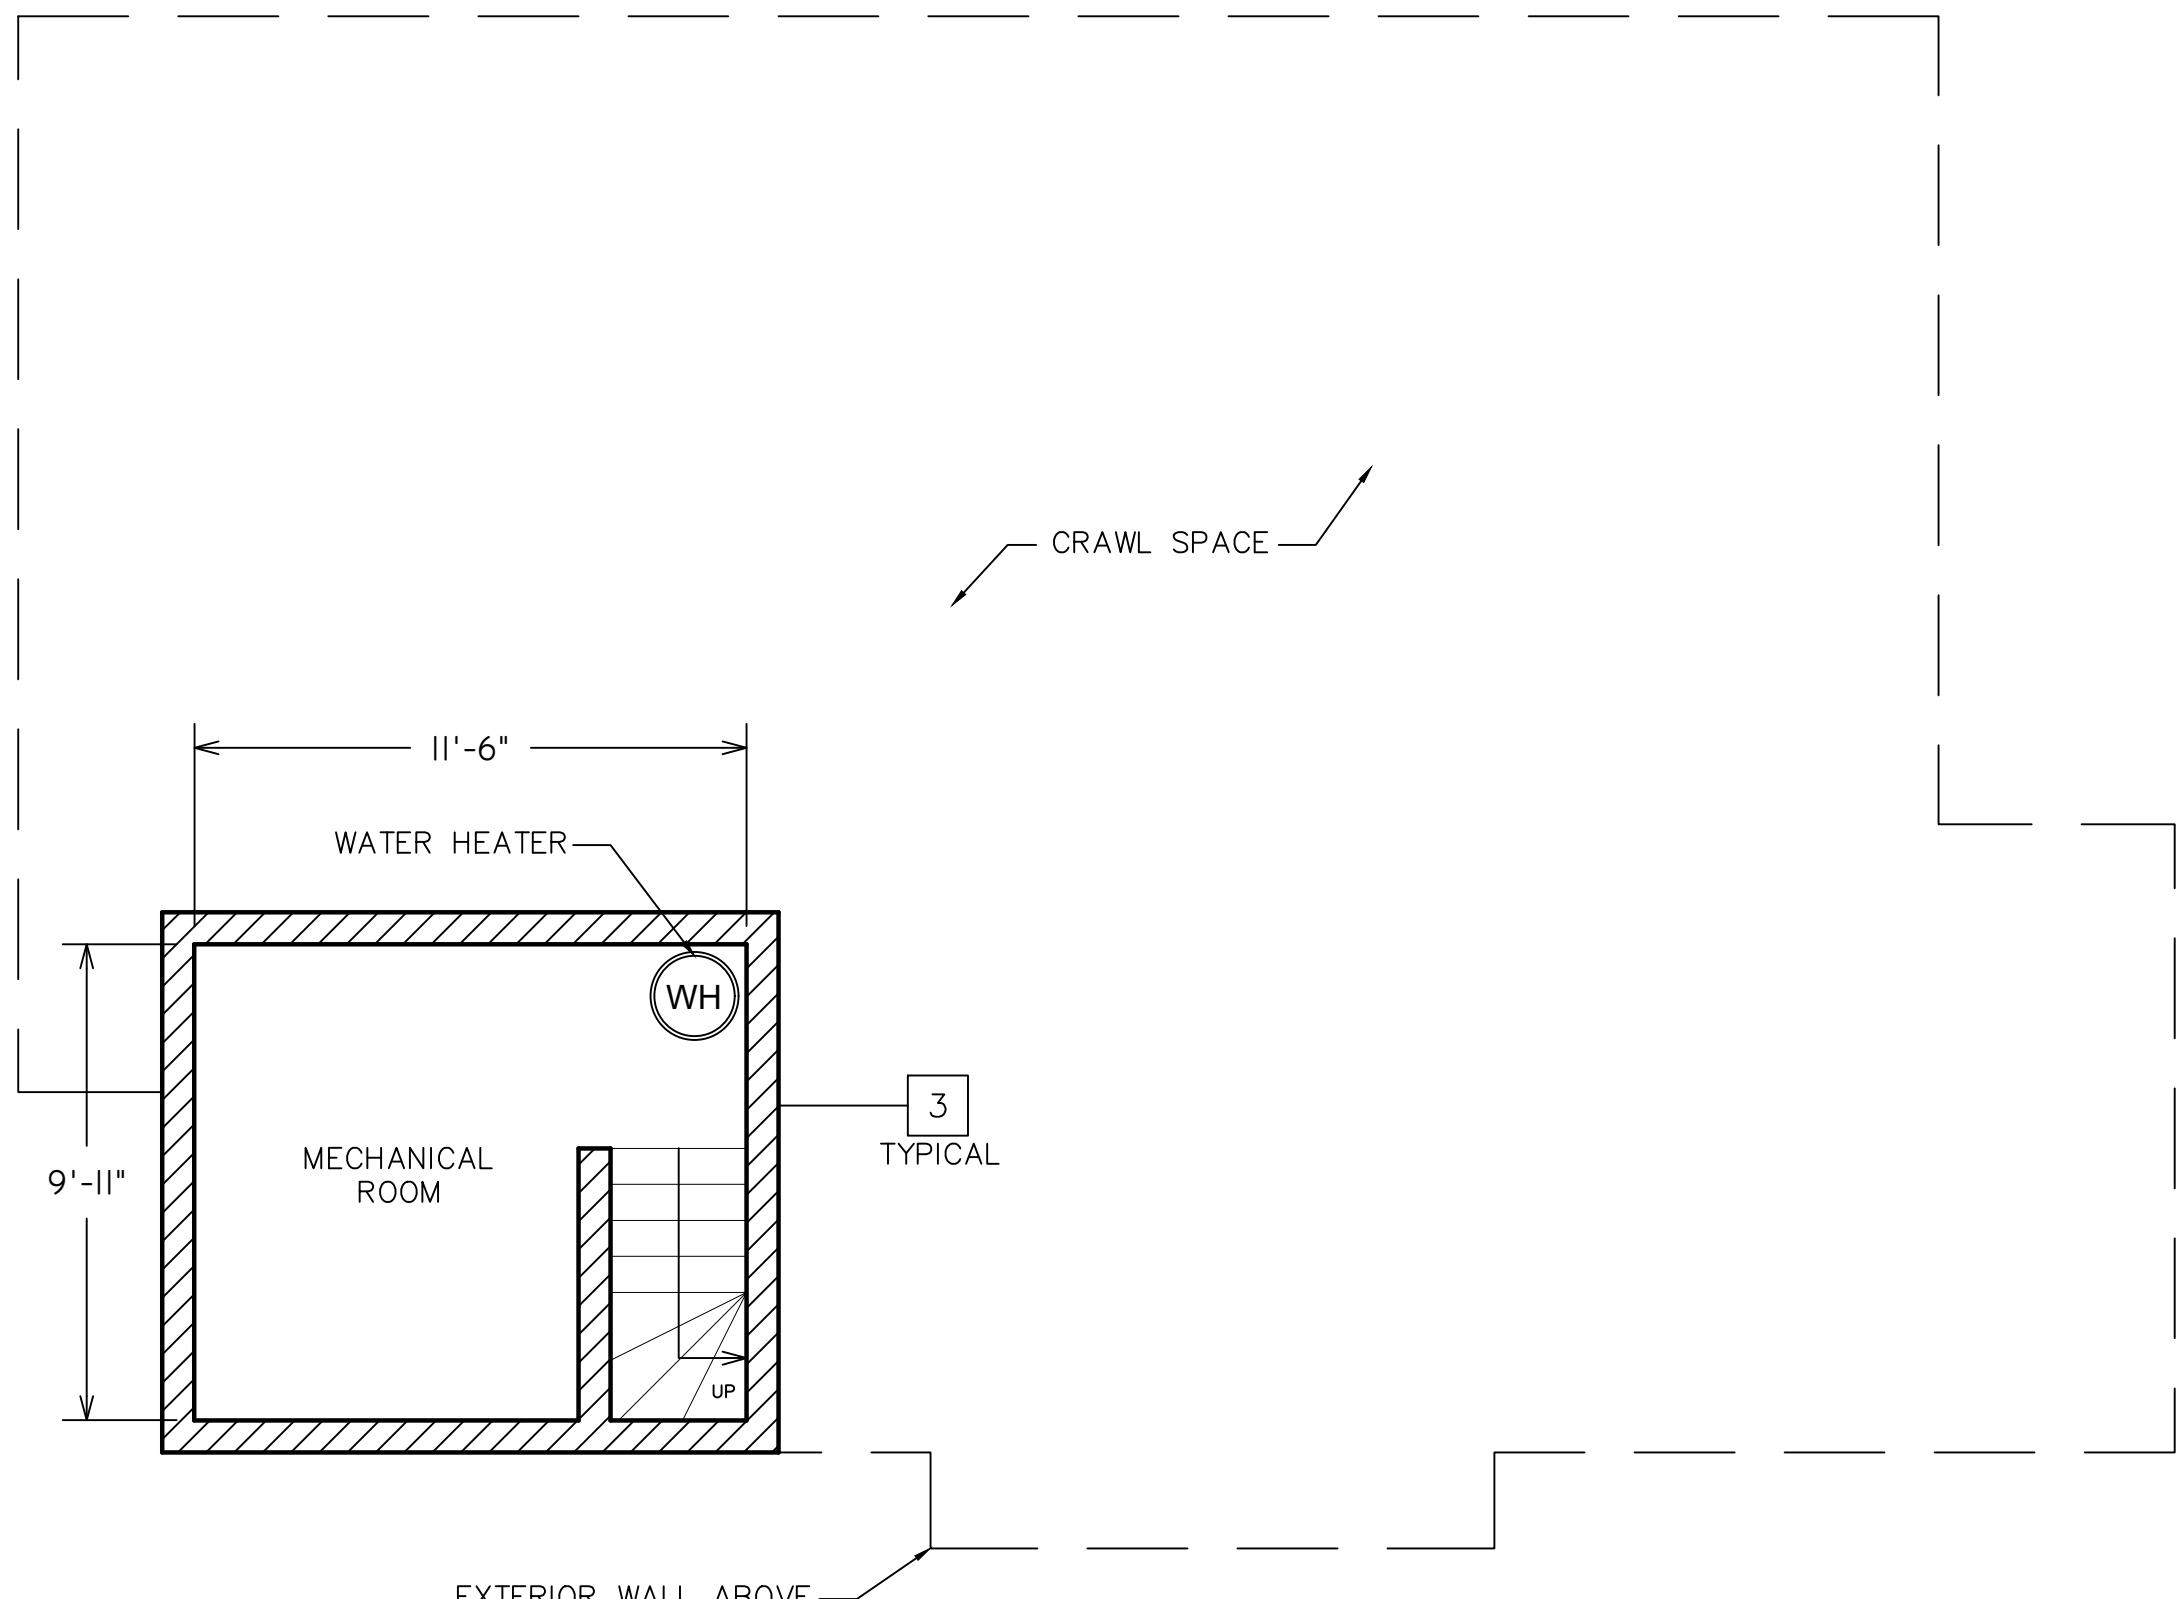



EXISTING BASEMENT FLOOR PLAN

WALL SCHEDULE	
KEY / LEGEND	DESCRIPTION
1 	EXISTING EXTERIOR WALL: 2X WOOD STUDS WITH GYPSUM WALLBOARD INTERIOR SIDE & WOOD SIDING EXTERIOR SIDE
2 	EXISTING INTERIOR WALL: 2X WOOD STUDS WITH GYPSUM WALLBOARD BOTH SIDES
3 	EXISTING BASEMENT WALL: 8" THICK CMU WALL

EXISTING FLOOR PLAN @ SINGLE FAMILY HOME


SCALE: 1/4" = 1'-0"

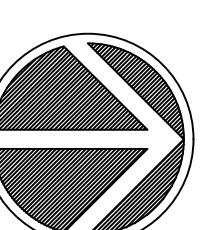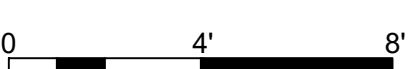

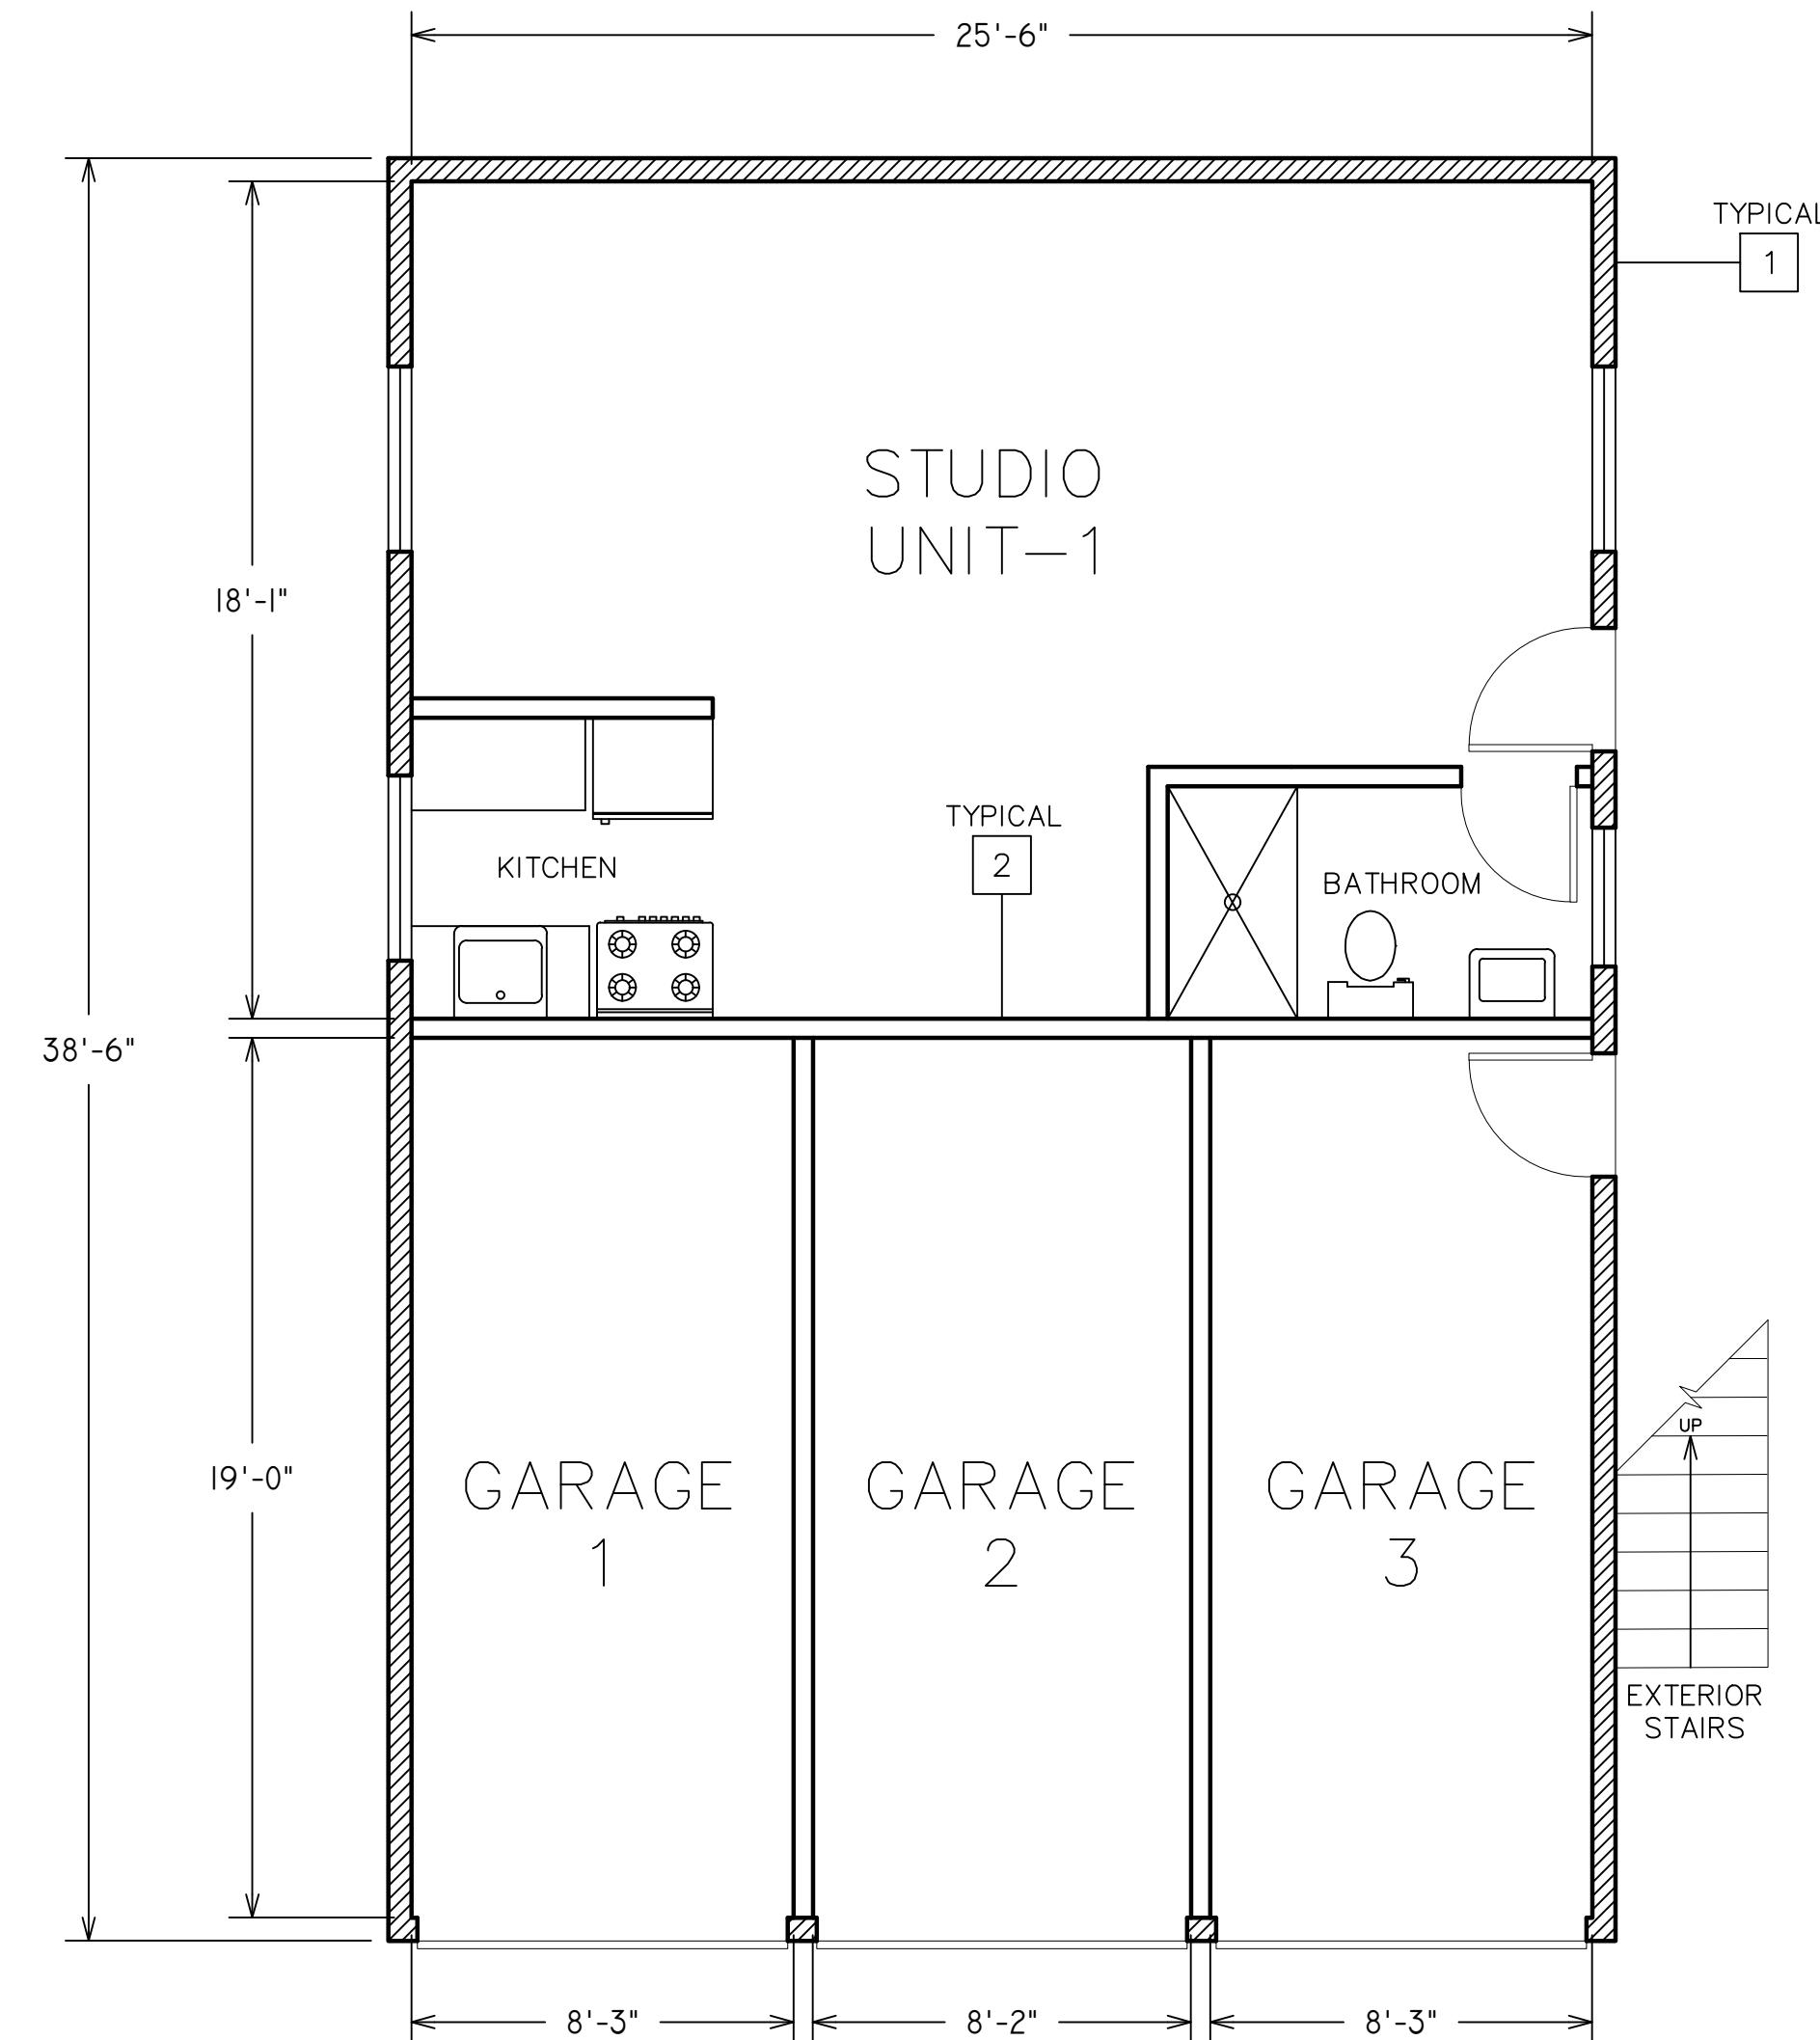


EXISTING GROUND FLOOR PLAN

SCALE: 1 / 4" = 1'-0"

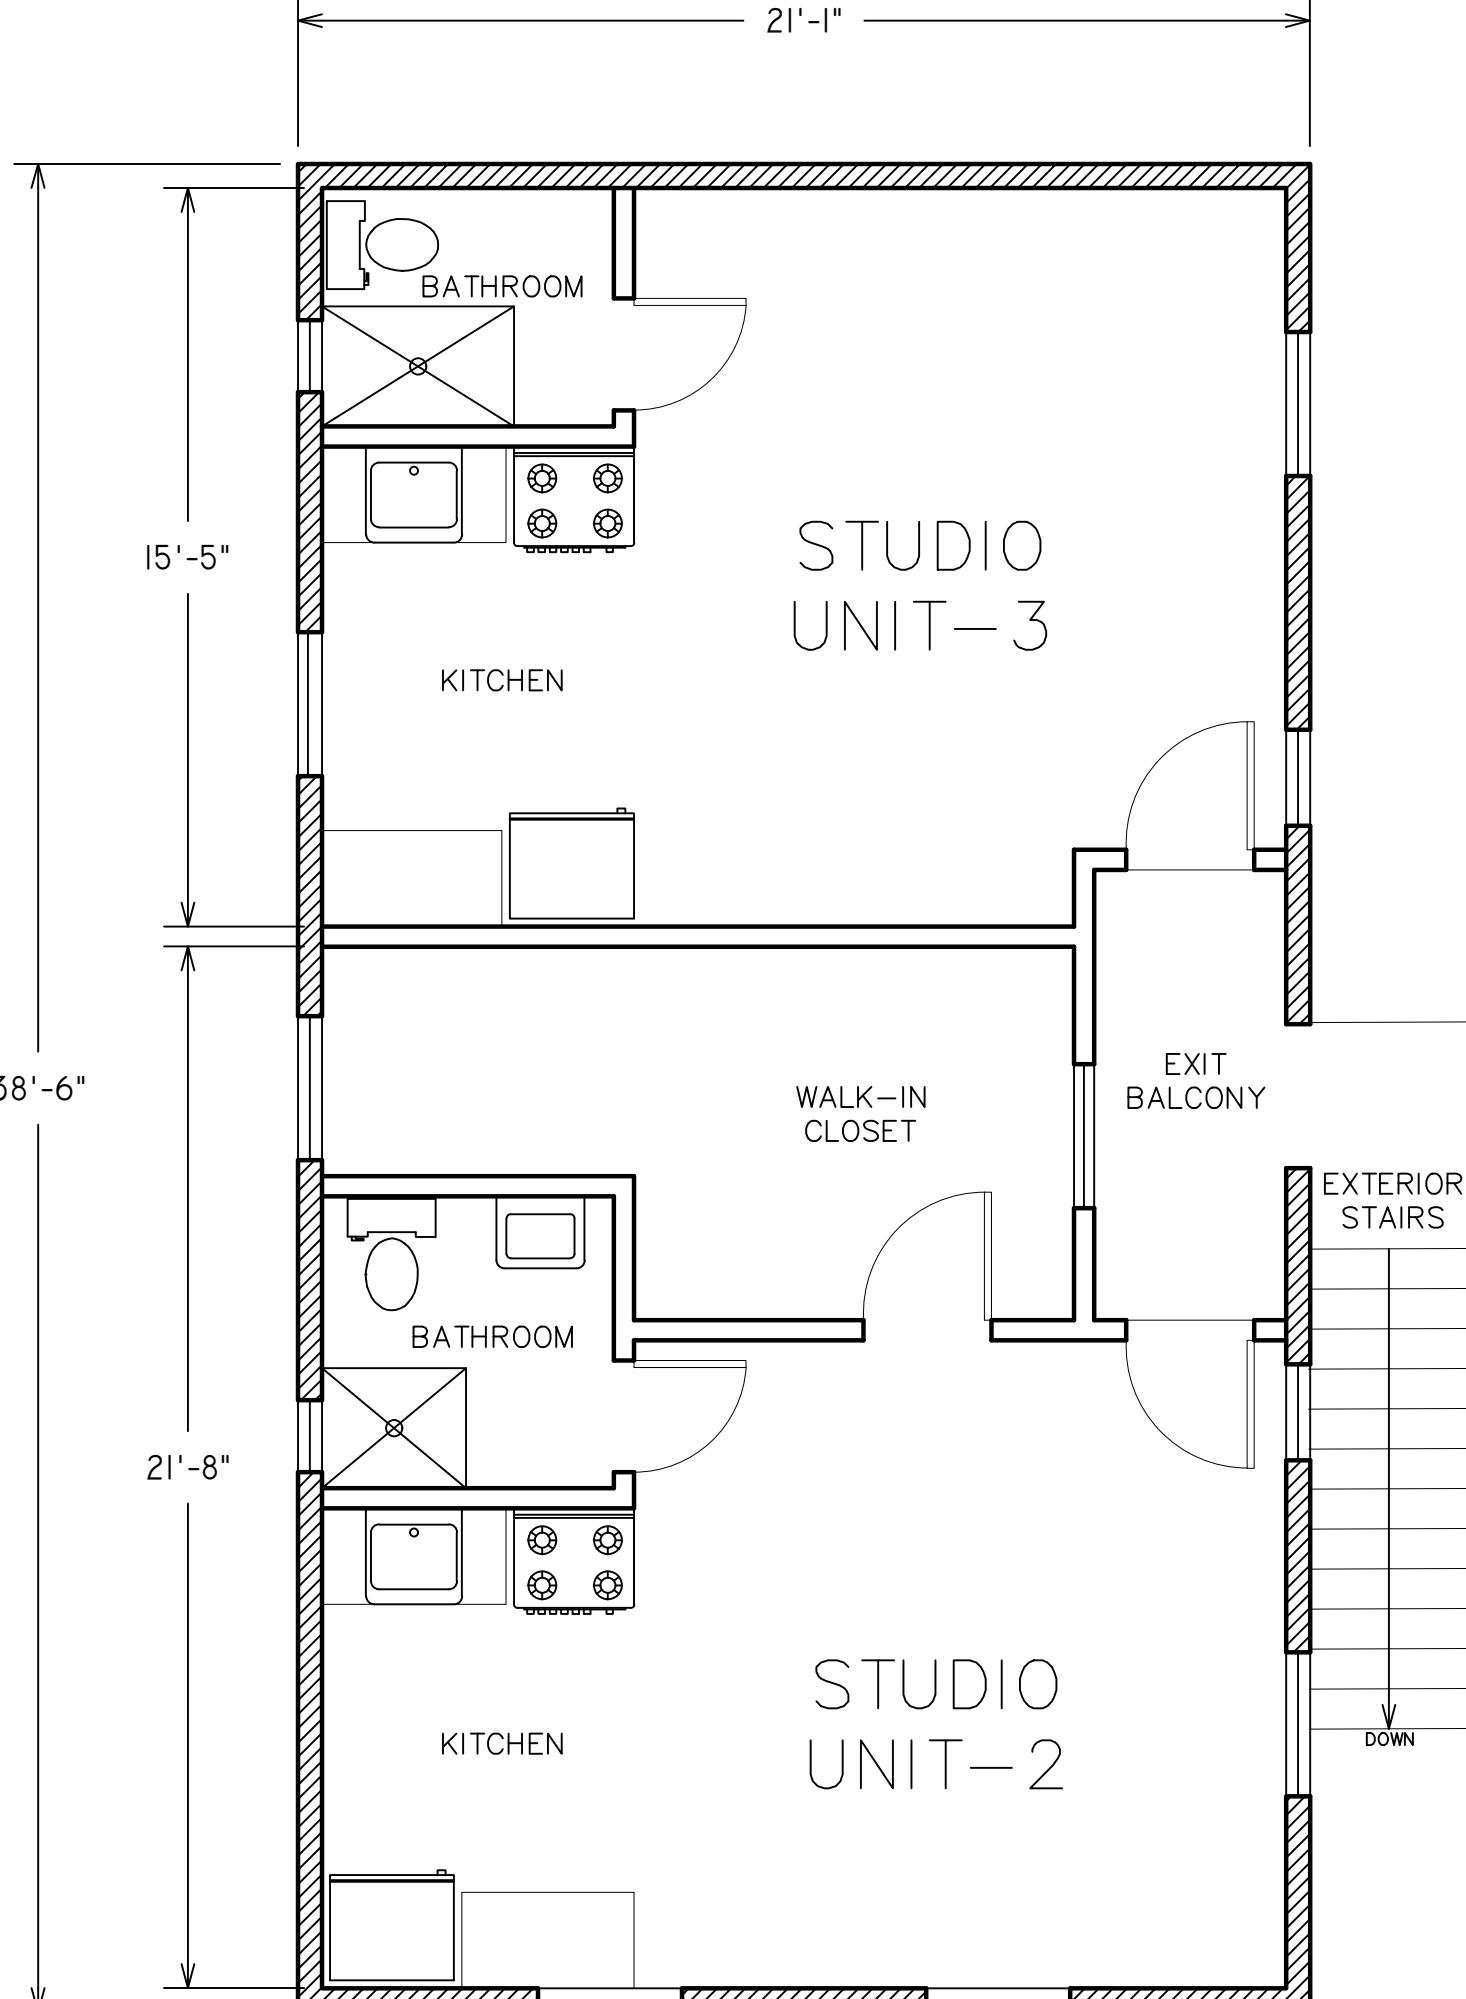

EXISTING 2ND FLOOR PLAN

 SCALE: 1/4" = 1'-0"

WALL SCHEDULE	
KEY / LEGEND	DESCRIPTION
1 	EXISTING EXTERIOR WALL: 2X WOOD STUDS WITH GYPSUM WALLBOARD INTERIOR SIDE & STUCCO EXTERIOR SIDE
2 	EXISTING INTERIOR WALL: 2X WOOD STUDS WITH GYPSUM WALLBOARD BOTH SIDES

WALL SCHEDULE



DESCRIPTION

EXISTING EXTERIOR WALL:
2X WOOD STUDS WITH GYPSUM WALLBOARD
INTERIOR SIDE & STUCCO EXTERIOR SIDE

EXISTING INTERIOR WALL:
2X WOOD STUDS WITH GYPSUM WALLBOARD
BOTH SIDES

EXISTING FLOOR PLAN @ GARAGE & MULTIFAMILY UNITS


SCALE: 1/4" = 1'-0"

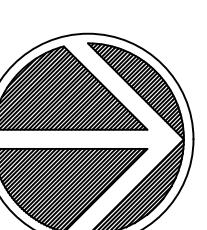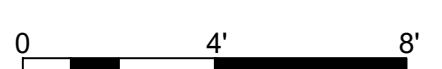

A3.2

EXISTING FLOOR PLAN @ GARAGE & MULTIFAMILY UNITS


Drawn	MM
Checked	RL
Date	10/17/23
Scale	AS NOTE
For	PLANNING REVIEW

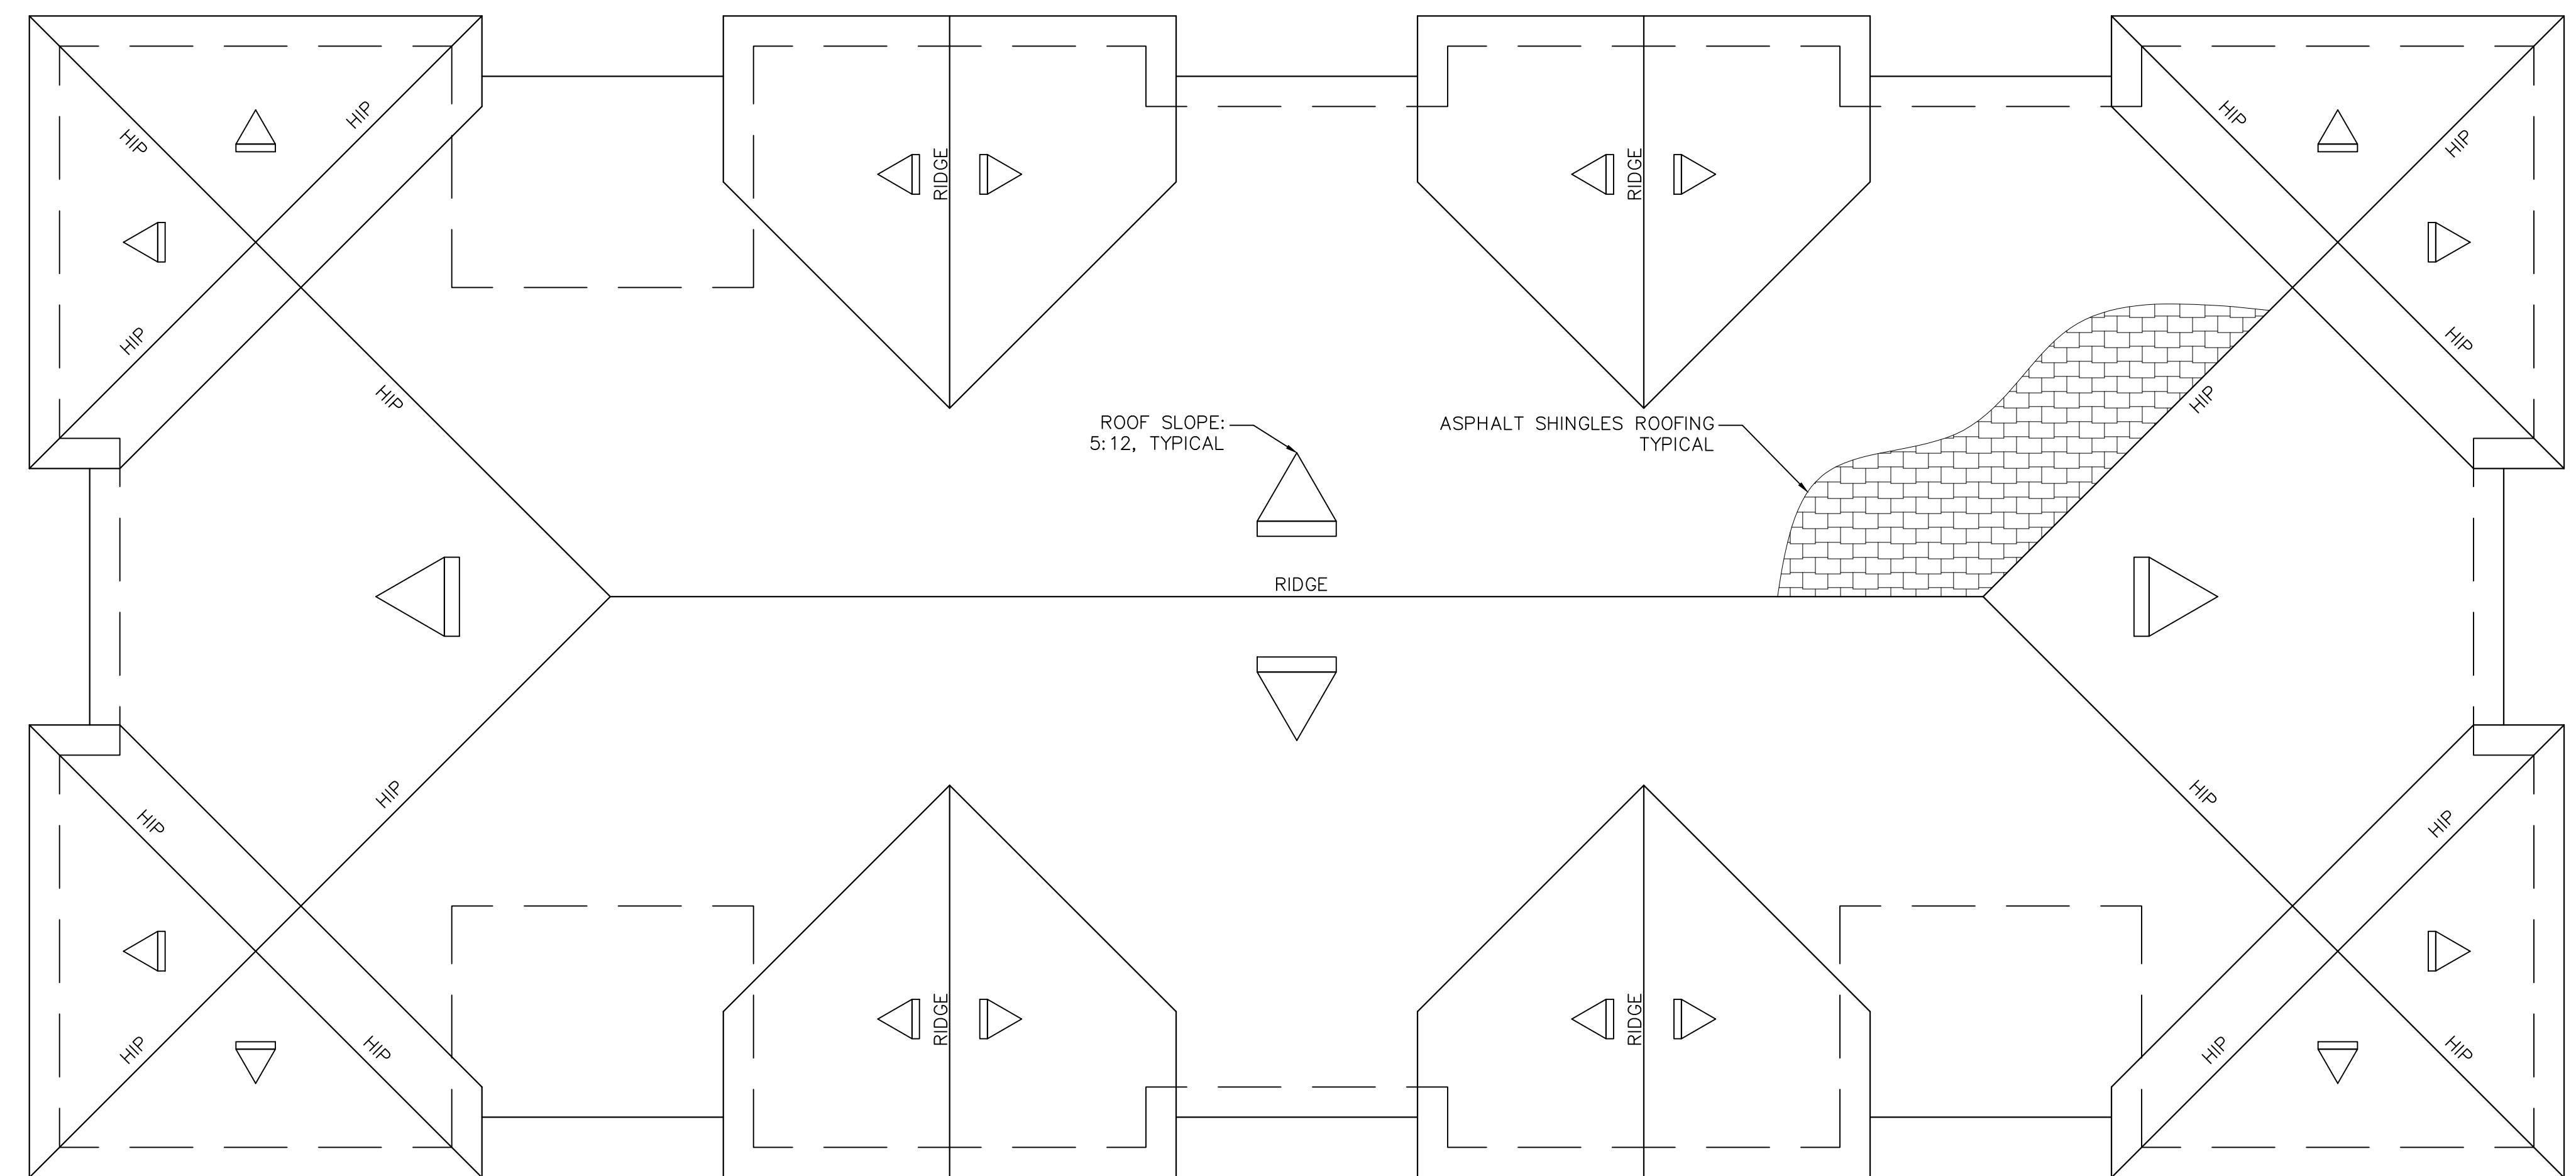

PROPOSED ROOF PLAN

SCALE: 1/4" = 1'-0"

A horizontal scale with numerical markings at 0, 4', and 8. A solid black horizontal bar is positioned below the scale, starting at the 0 mark and extending to the 4' mark.

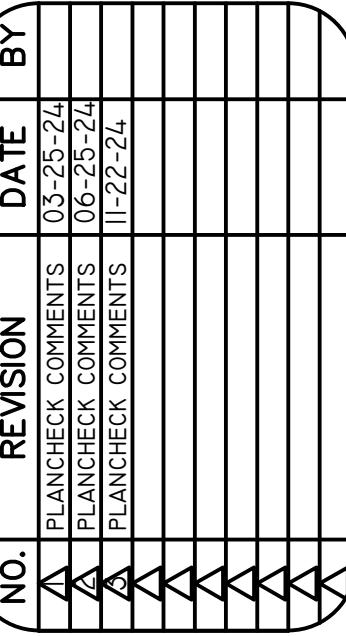


REID LERNER ARCHITECTS
PHONE 408-842-9942
REIDLERNER@YAHOO.COM
7680 MONTEREY ST #105
GILROY, CA 95020


TILTON APARTMENTS
NEW MULTI-FAMILY APARTMENTS
328 TILTON AVENUE
SAN MATEO CA 94401

PROPOSED ROOF PLAN

Drawn	MM
Checked	RL
Date	10/17/23
Scale	AS NOTED
For	PLANNING REVIEW

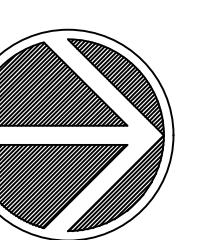

A4

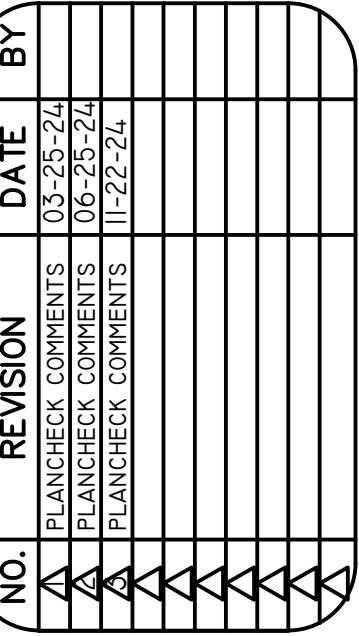

REID LERNER ARCHITECTS
PHONE 408-842-9942
REIDLERNER@YAHOO.COM
7680 MONTEREY ST #105
GILROY, CA 95020

TILTON APARTMENTS
NEW MULTI-FAMILY APARTMENTS
328 TILTON AVENUE
SAN MATEO, CA 94401

PROPOSED ELEVATIONS

Drawn	MM
Checked	RL
Date	10/17/23
Scale	AS NOTED
For	PLANNING REVIEW
Sheet	

A5




PROPOSED EAST/ RAILROAD ELEVATION

SCALE: 1/4" = 1'-0"



WEST ELEVATION				
AREA OF EXTERIOR WALL OPENINGS BASED ON FSD (PER TABLE 705.8)				
STORY	FSD (FIRE SEPARATION DISTANCE)	DEGREE OF OPENING PROTECTION	ALLOWABLE AREA (SQ. FT.)	PROPOSED OPENING AREA (PER STORY)
1	6'	UP, S	25%	17.8% (146/820)
2	6'	UP, S	25%	23.4% (187/800)

FIRE RESISTANCE RATING REQUIREMENTS FOR EXTERIOR WALLS (PER TABLE 602)				
FSD (FIRE SEPARATION DISTANCE)	TYPE OF CONSTRUCTION	OCCUPANCY GROUP	REQUIRED FIRE RESISTANCE (HOUR)	PROPOSED FIRE RESISTANCE (HOUR)
6'	VB	R-2	1	1 

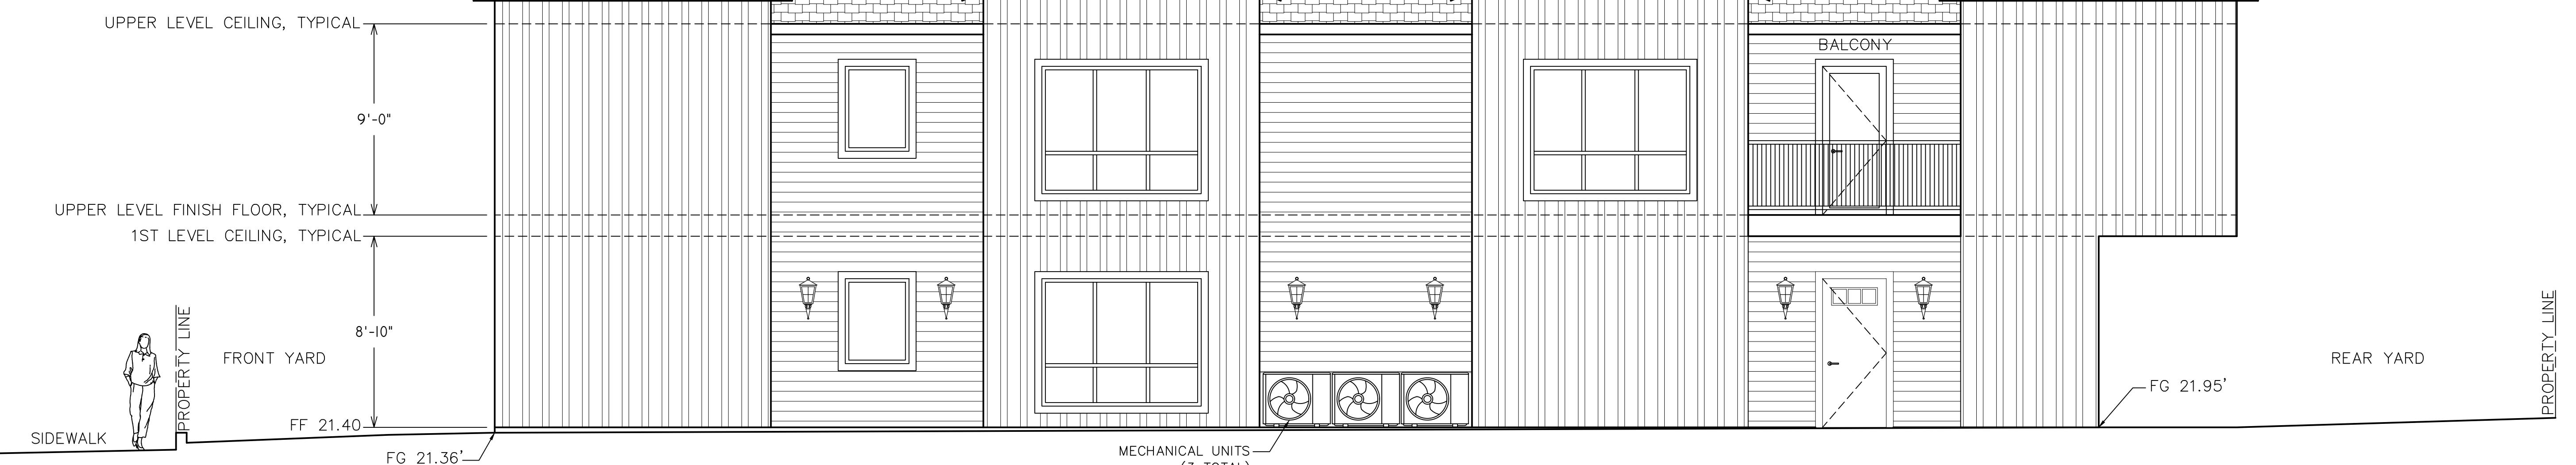

PROPOSED WEST ELEVATION


SCALE: 1/4" = 1'-0"





PROPOSED NORTH/ TILTON AVE ELEVATION

SCALE: 1/4" = 1'-0"

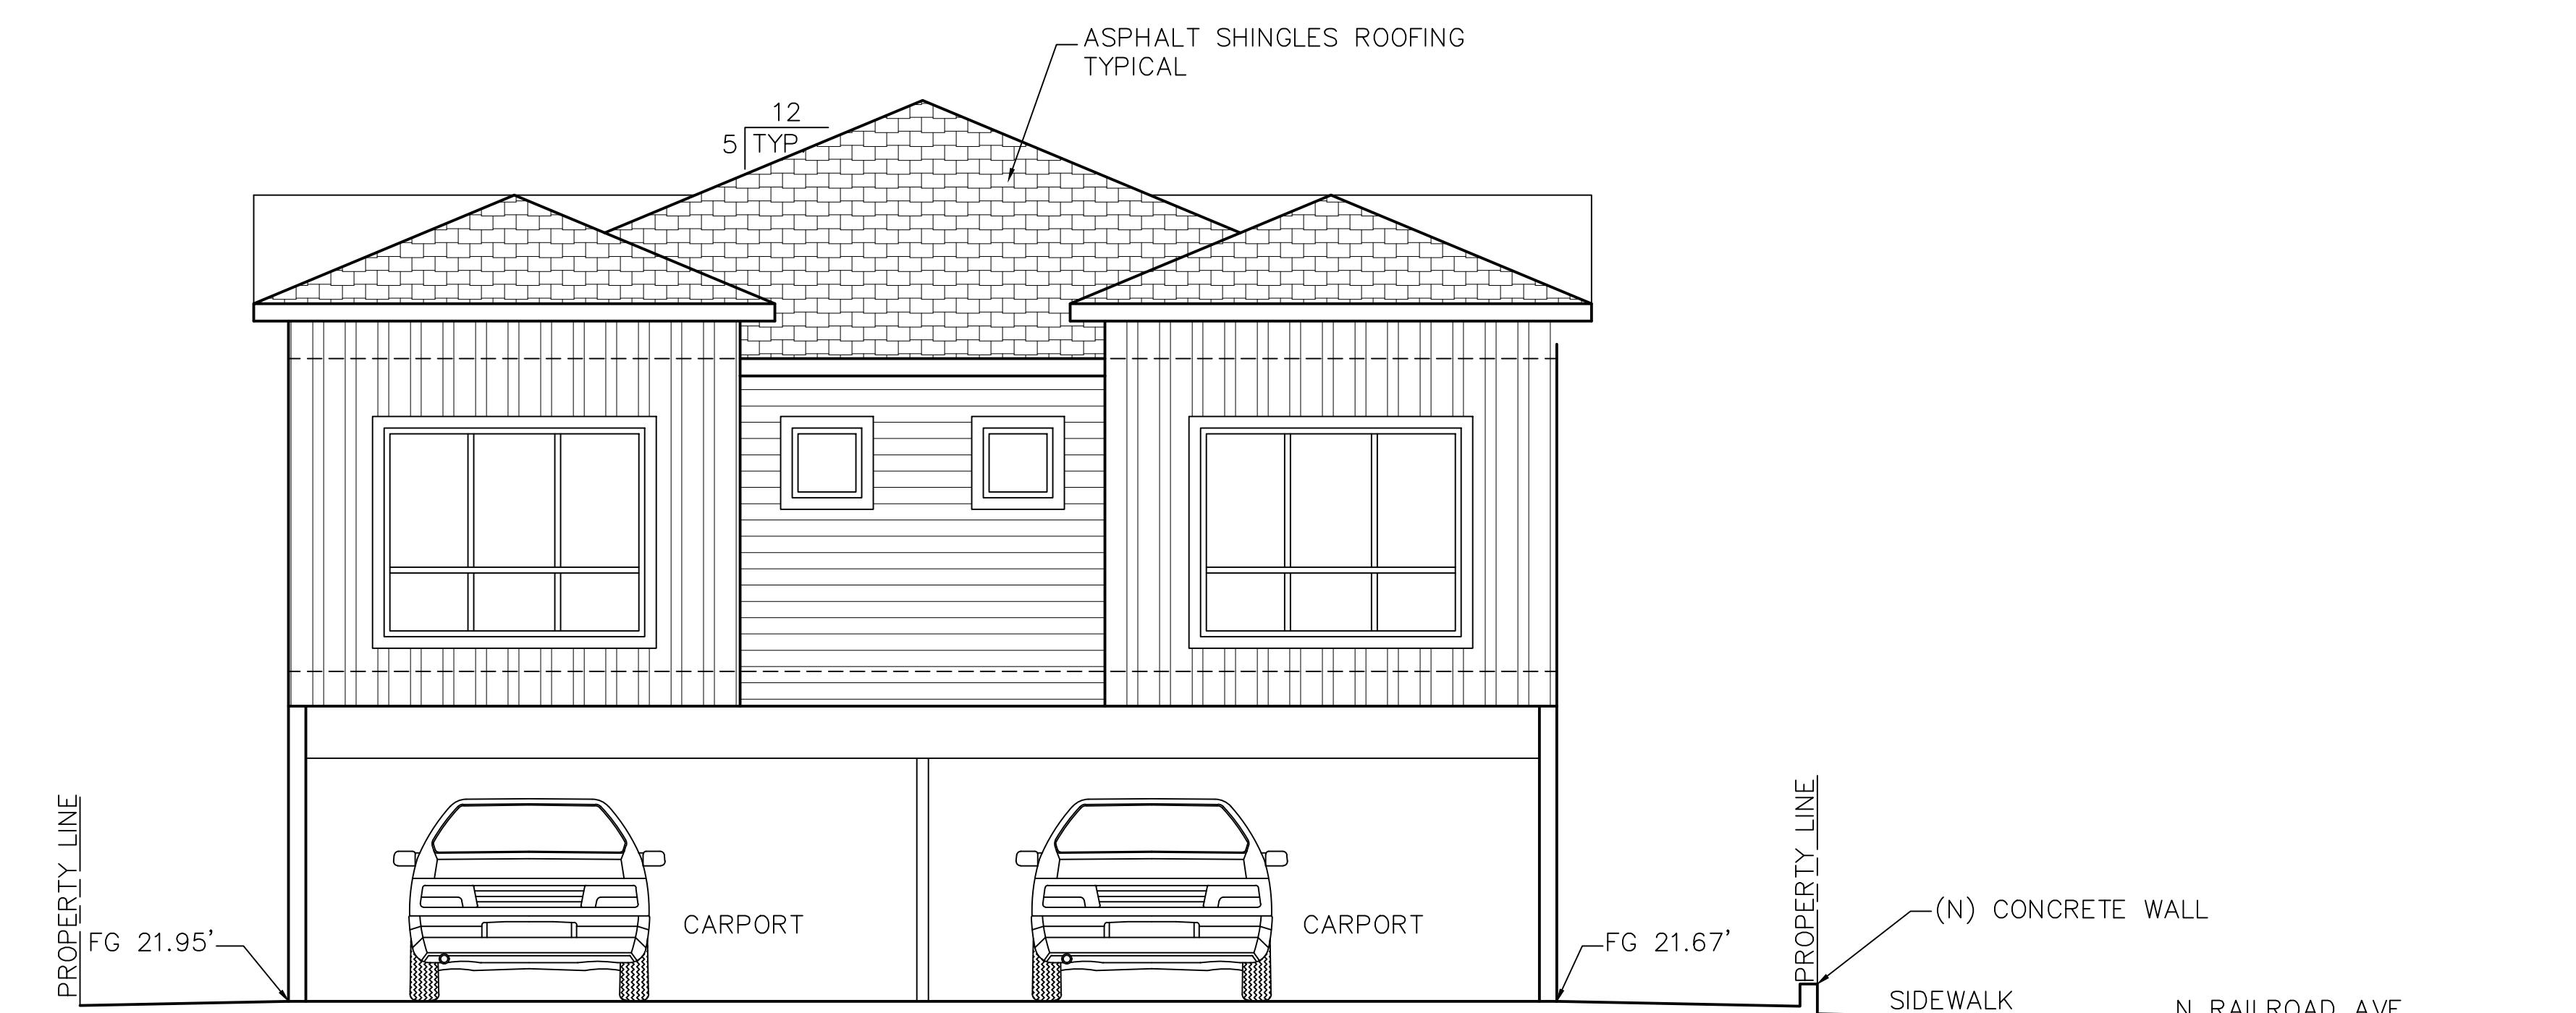

PROPOSED SOUTH ELEVATION

SCALE: 1/4" = 1'-0"



Drawn	MM
Checked	RL
Date	10/17/23
Scale	AS NOTED
For	PLANNING REVIEW
Sheet	

A6

TILTON APARTMENTS
NEW MULTI-FAMILY APARTMENTS
328 TILTON AVENUE
SAN MATEO, CA 94401



PROPOSED ELEVATIONS

NO.	REVISION	DATE	BY
1	△	PLANCHECK COMMENTS 03-25-24	
2	△	PLANCHECK COMMENTS 06-25-24	
3	△	PLANCHECK COMMENTS 11-22-24	
4	△		
5	△		
No. C 19293
Reid Lerner
REID LERNER
LICENCED ARCHITECT
STATE OF CALIFORNIA
REN: 31 AUG 2025

REID LERNER ARCHITECTS
PHONE 408-842-9942
REIDLERNER@YAHOO.COM
7680 MONTEREY ST #105
GILROY, CA 95020

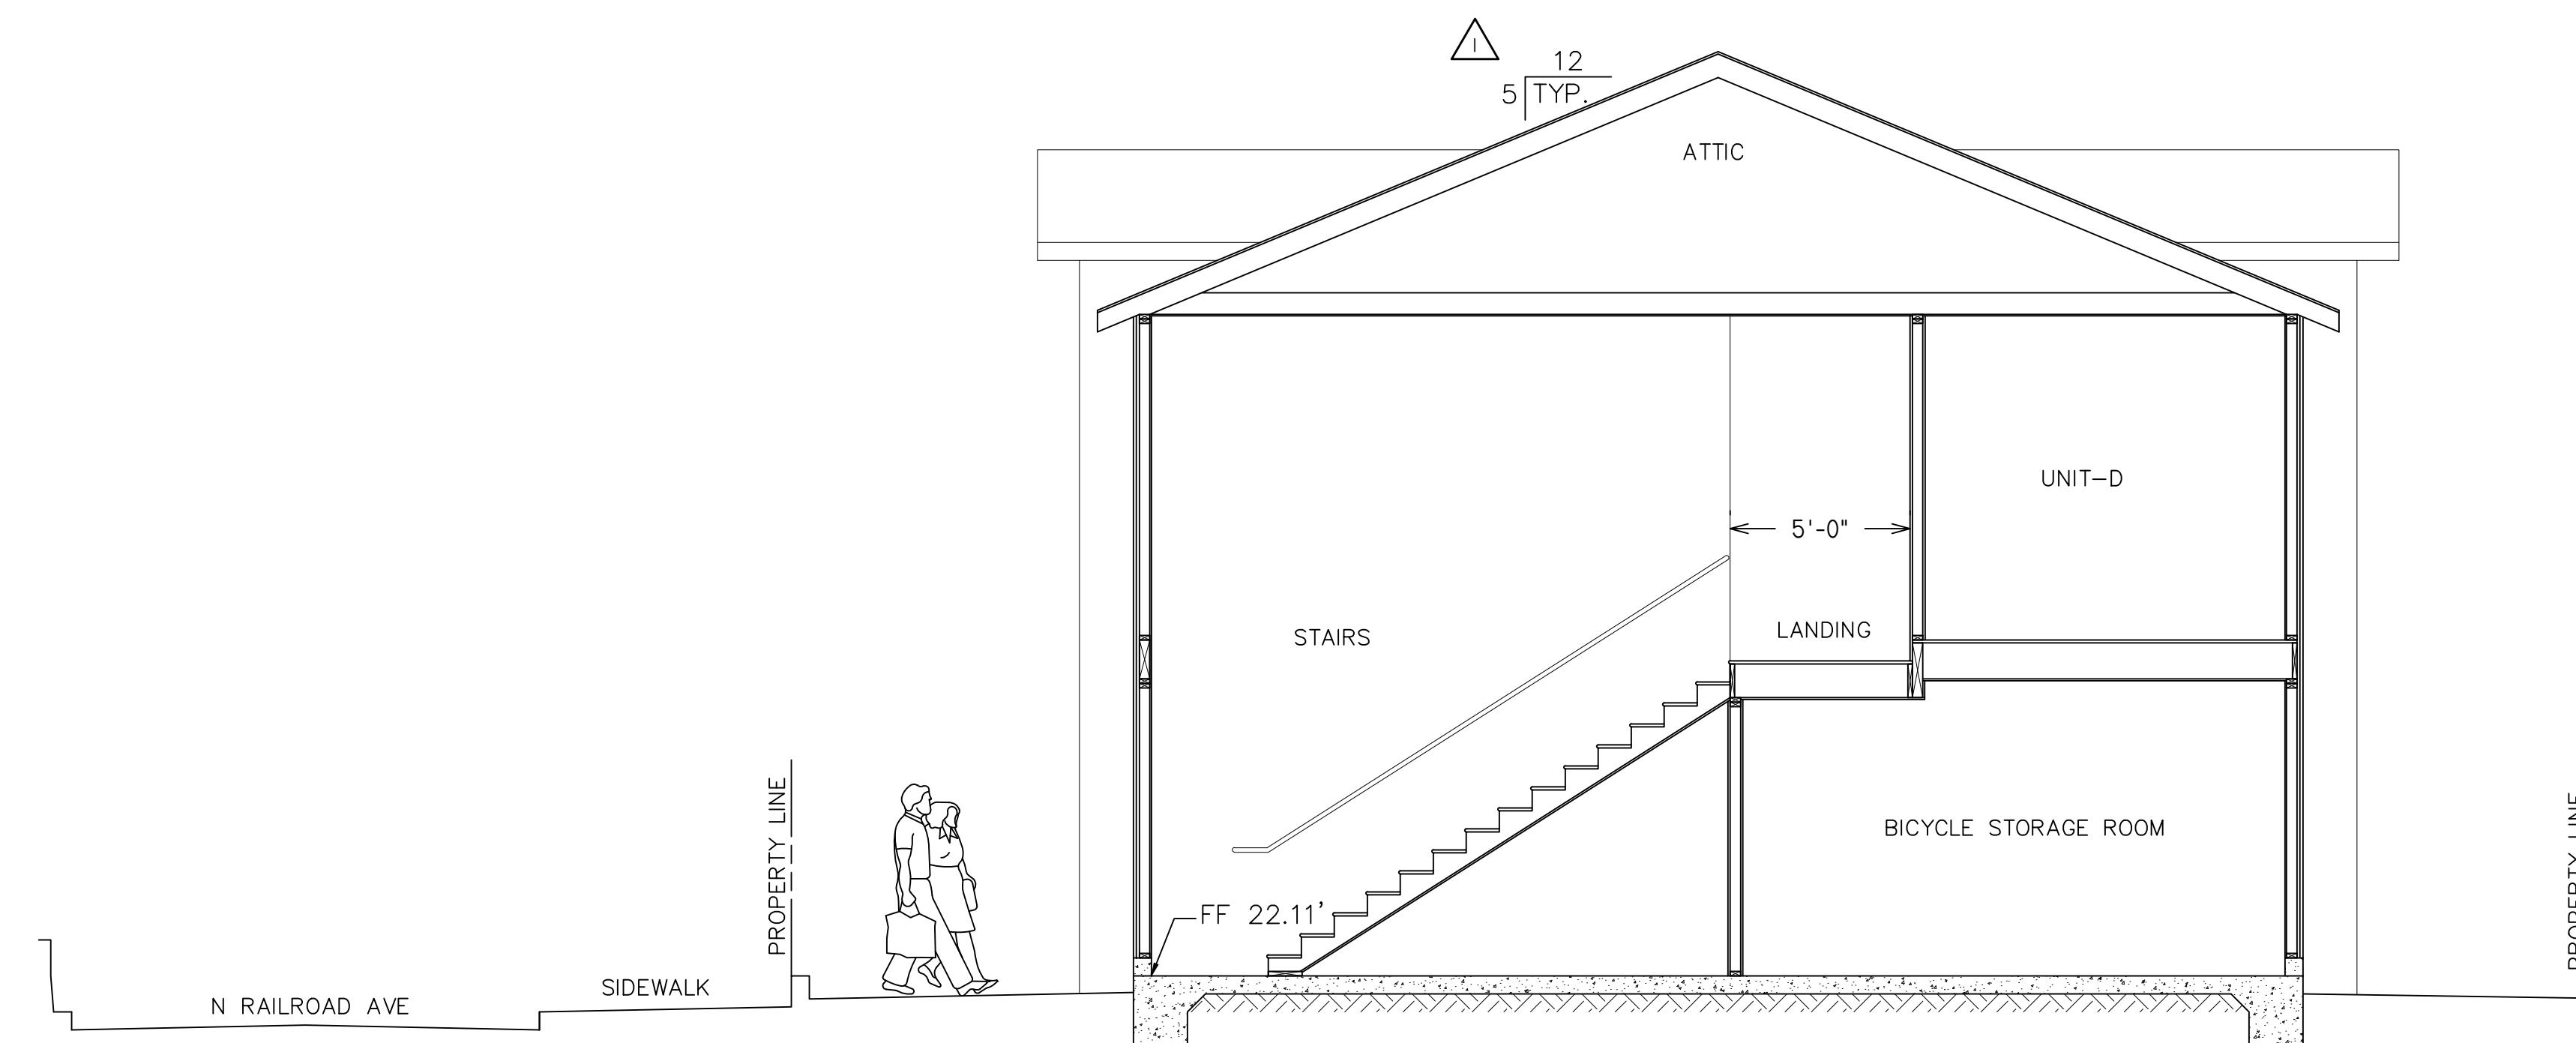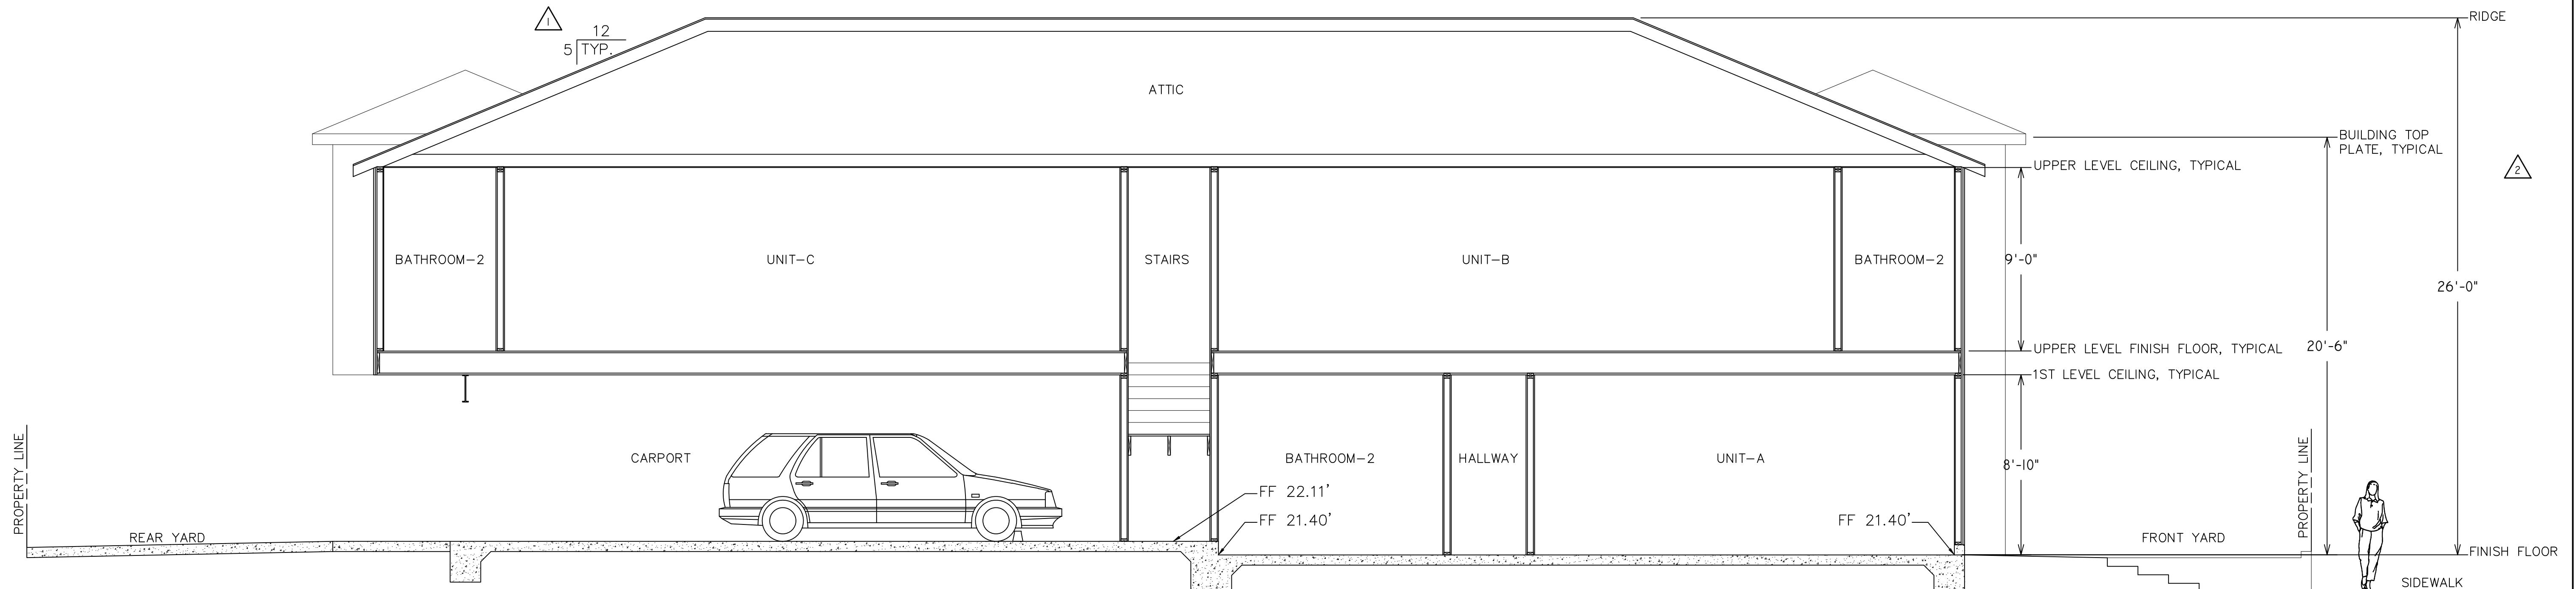

NO.	REVISION	DATE	BY
	PLANCHETTE COMMENTS	05-25-23	
	PLANCHETTE COMMENTS	06-22-23	
	PLANCHETTE COMMENTS	07-22-23	

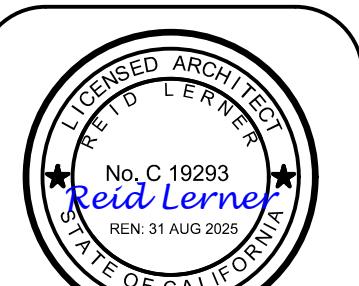


REID LERNER ARCHITECTS
PHONE 408-842-9942
REIDLERNER@GMAIL.COM
7680 MONTEREY ST #105
GILROY, CA 95020


TILTON APARTMENTS
NEW MULTI-FAMILY APARTMENTS
328 TILTON AVENUE
SAN MATEO, CA 94401

BUILDING SECTIONS

Drawn MM
Checked RL
Date 10/17/23
Scale AS NOTED
For PLANNING REVIEW
Sheet

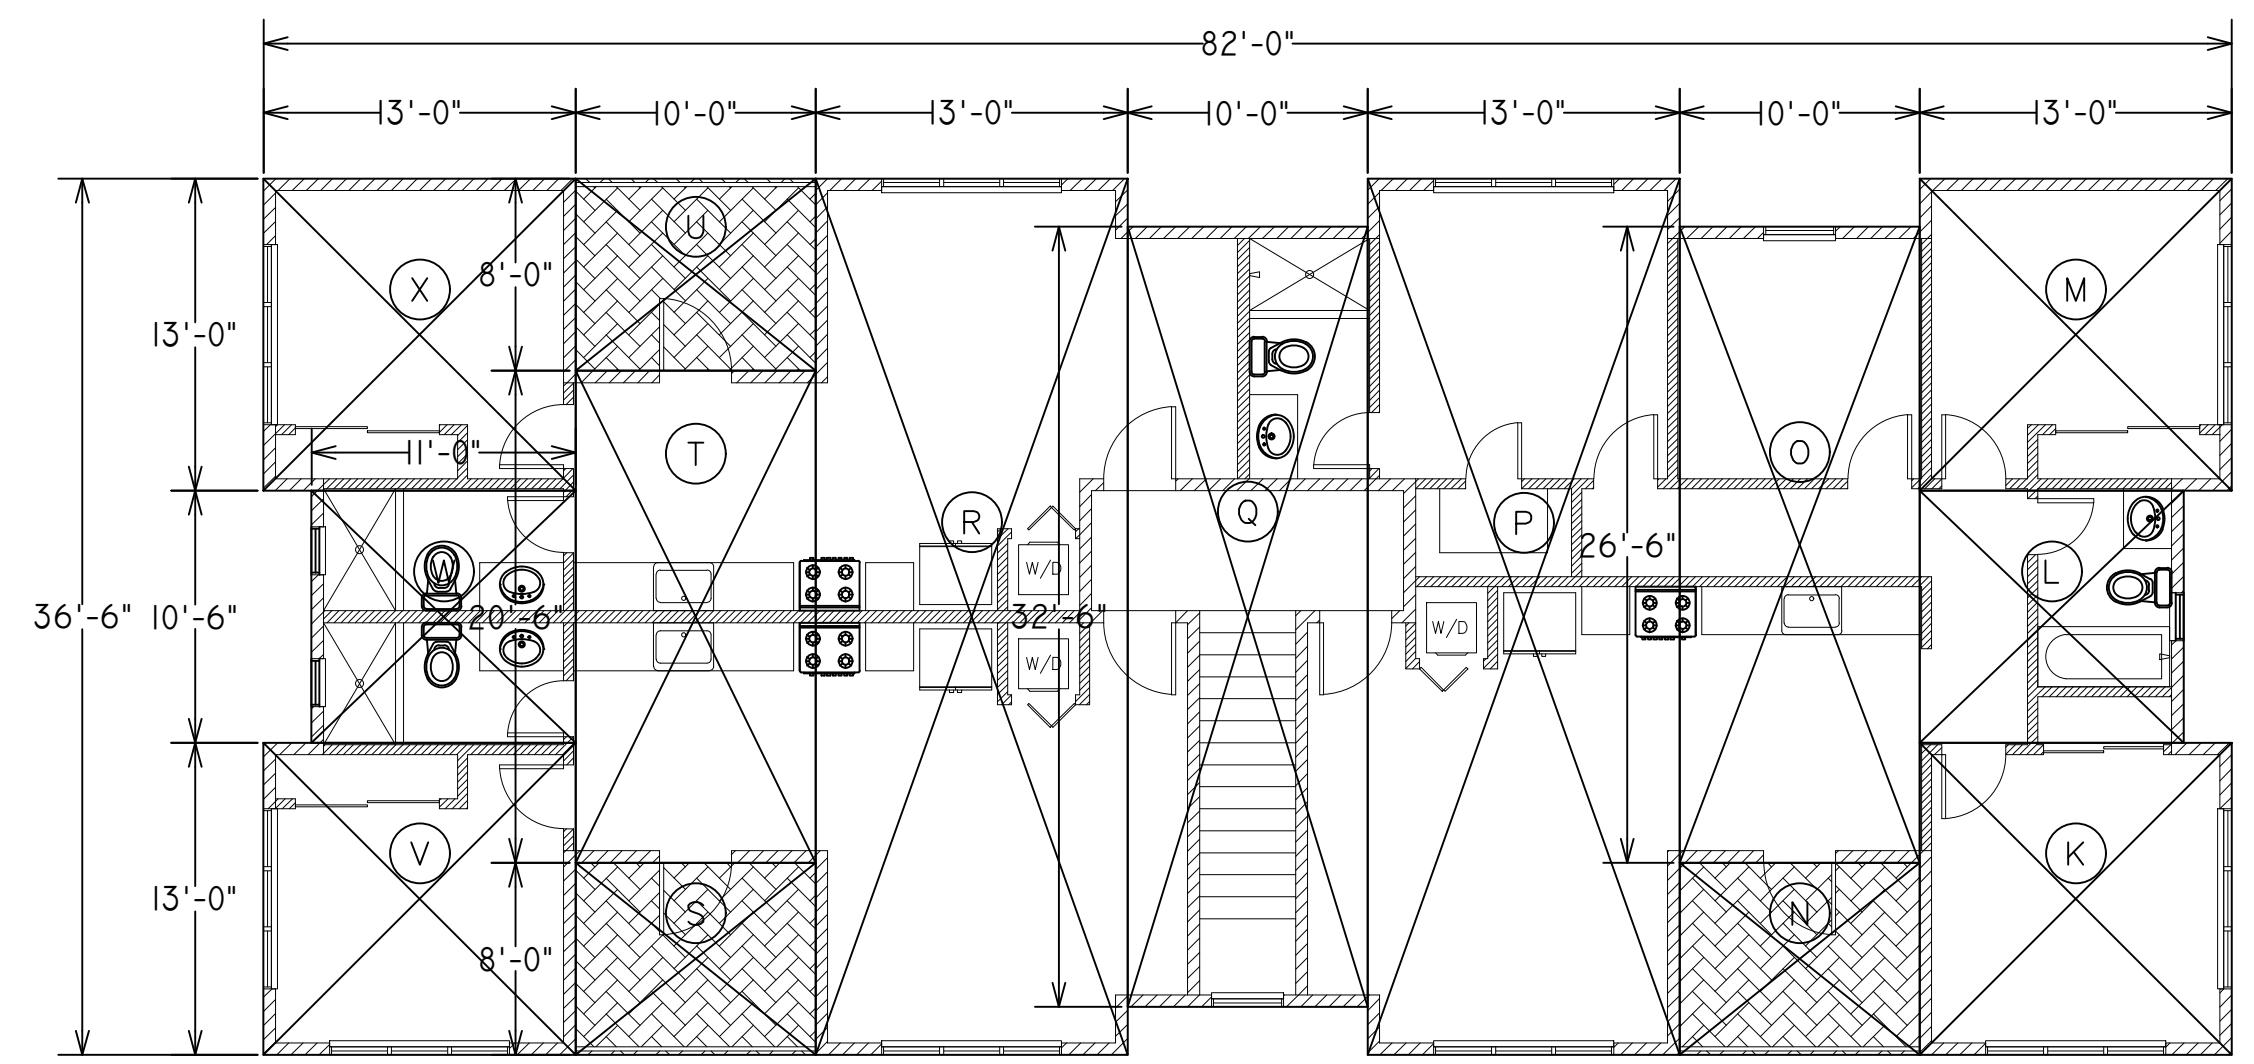


2ND FLOOR

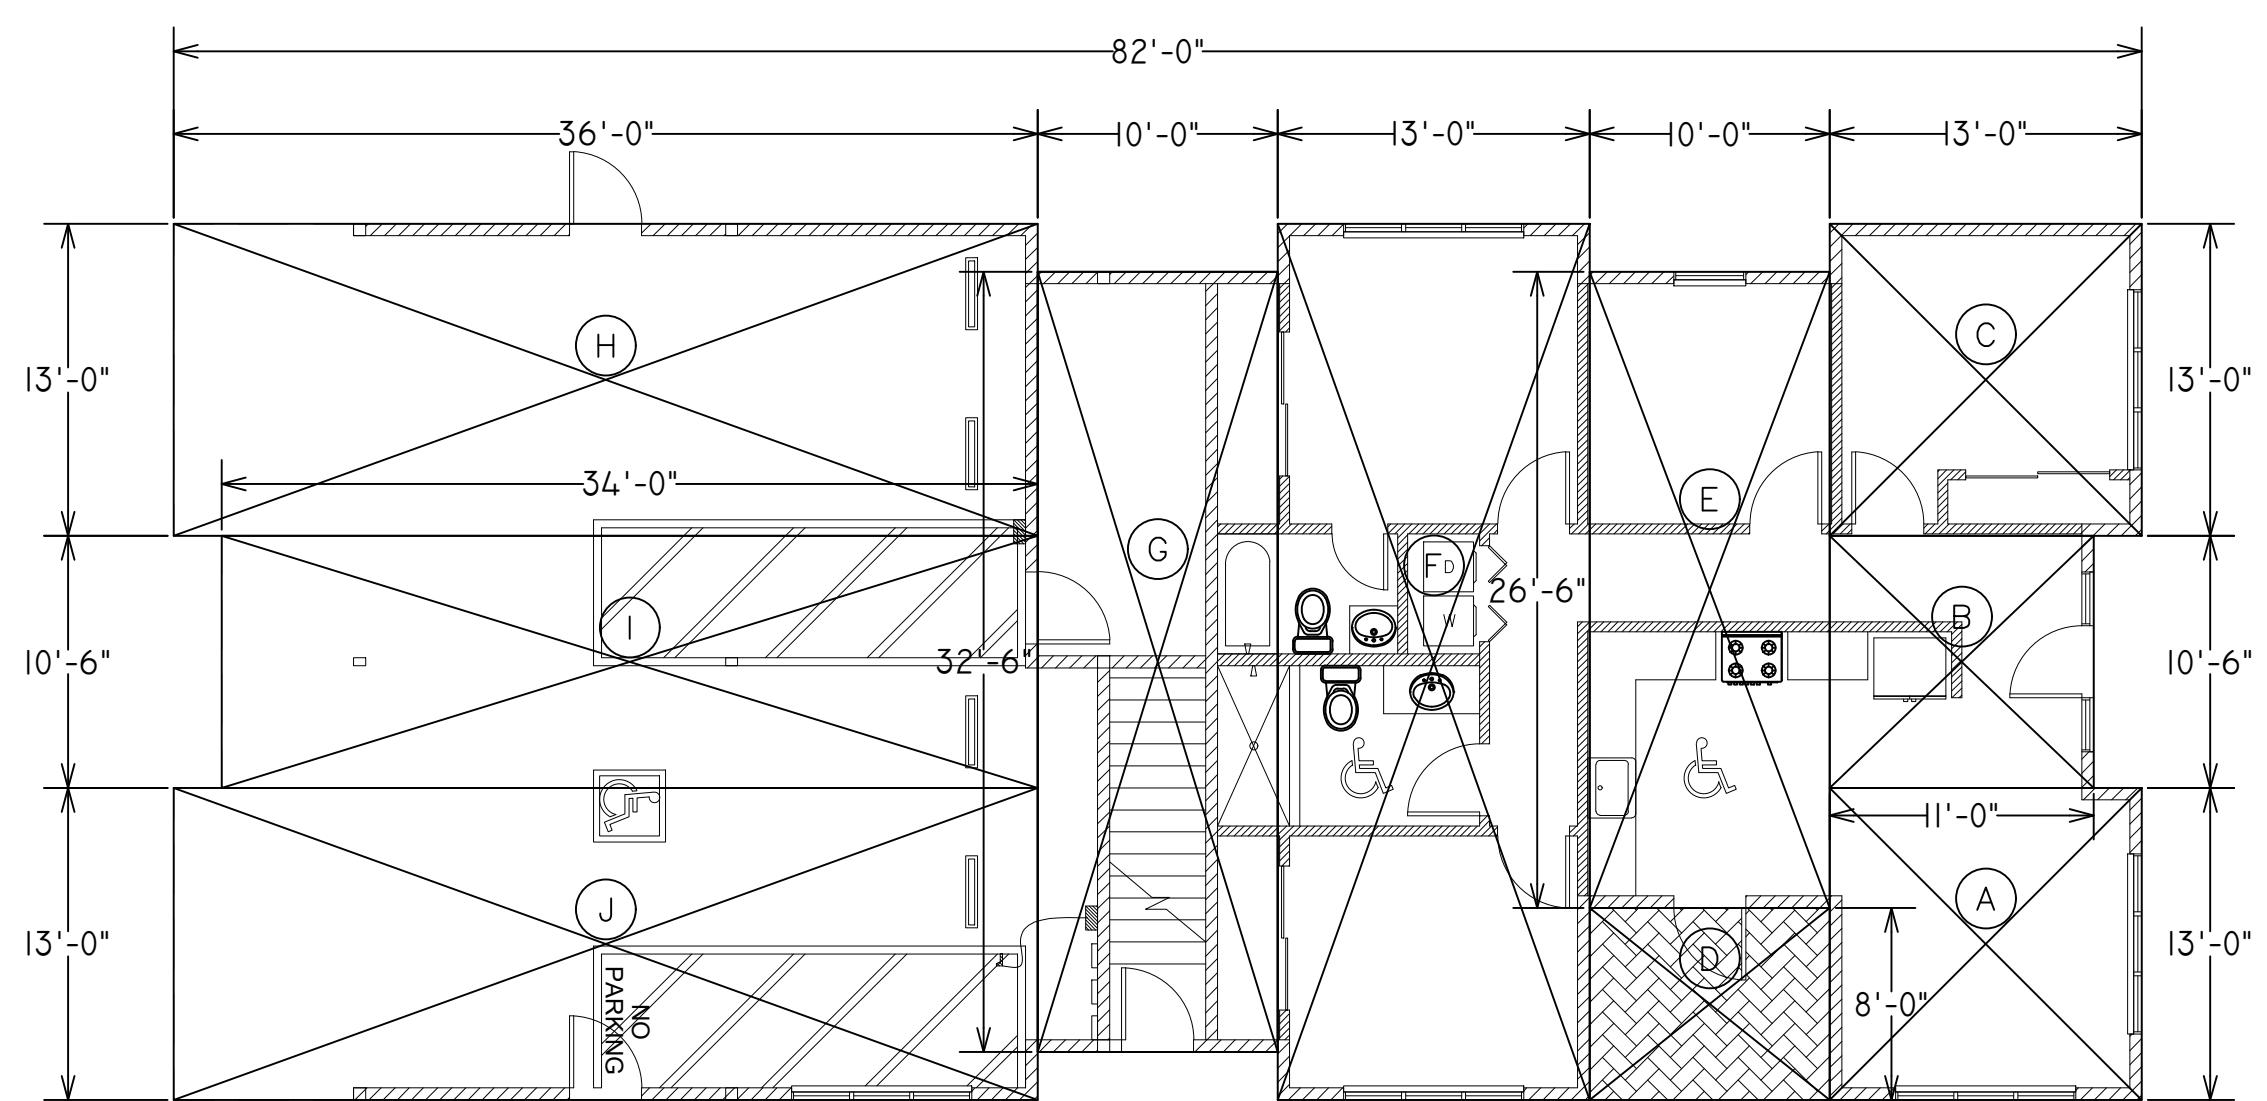

GROUND FLOOR

FLOOR AREA CALCULATION DIAGRAM

SCALE: 1/8" = 1'-0"

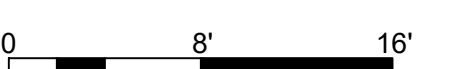

FLOOR	SECTION	DIMENSION	AREA (SQUARE FEET)
1	A	13'-0" x 13'-0"	169
	B	11'-0" x 10'-6"	115.5
	C	13'-0" x 13'-0"	169
	D	10'-0" x 8'-0"	80
	E	26'-6" x 10'-0"	265
	F	36'-6" x 13'-0"	474.5
	G	32'-6" x 10'-0"	325
	H	36'-0" x 13'-0"	468
	I	34'-0" x 10'-6"	357
	J	36'-0" x 13'-0"	468
2	K	13'-0" x 13'-0"	169
	L	11'-0" x 10'-6"	115.5
	M	13'-0" x 13'-0"	169
	N	10'-0" x 8'-0"	80
	O	26'-6" x 10'-0"	265
	P	36'-6" x 13'-0"	474.5
	Q	32'-6" x 10'-0"	325
	R	36'-6" x 13'-0"	474.5
	S	10'-0" x 8'-0"	80
	T	20'-6" x 10'-0"	205
	U	10'-0" x 8'-0"	80
	V	13'-0" x 13'-0"	169
	W	11'-0" x 10'-6"	115.5
	X	13'-0" x 13'-0"	169
TOTAL			5,782

FLOOR AREA
CALCULATION DIAGRAM

Drawn MM
Checked RL
Date 10/17/23
Scale AS NOTED
For PLANNING REVIEW
Sheet


A8


NO.	REVISION	DATE	BY
	PLANCHICK CORPENS	10/23/23	
	PLANCHICK CORPENS	10/23/23	
	PLANCHICK CORPENS	10/23/23	




REID LERNER ARCHITECTS
PHONE 408-294-2942
REIDLERNER@GMAIL.COM
7680 MONTEREY ST #105
GILROY, CA 95020

TILTON APARTMENTS
NEW MULTI-FAMILY APARTMENTS
328 TILTON AVENUE
SAN MATEO, CA 94401

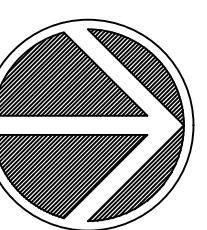

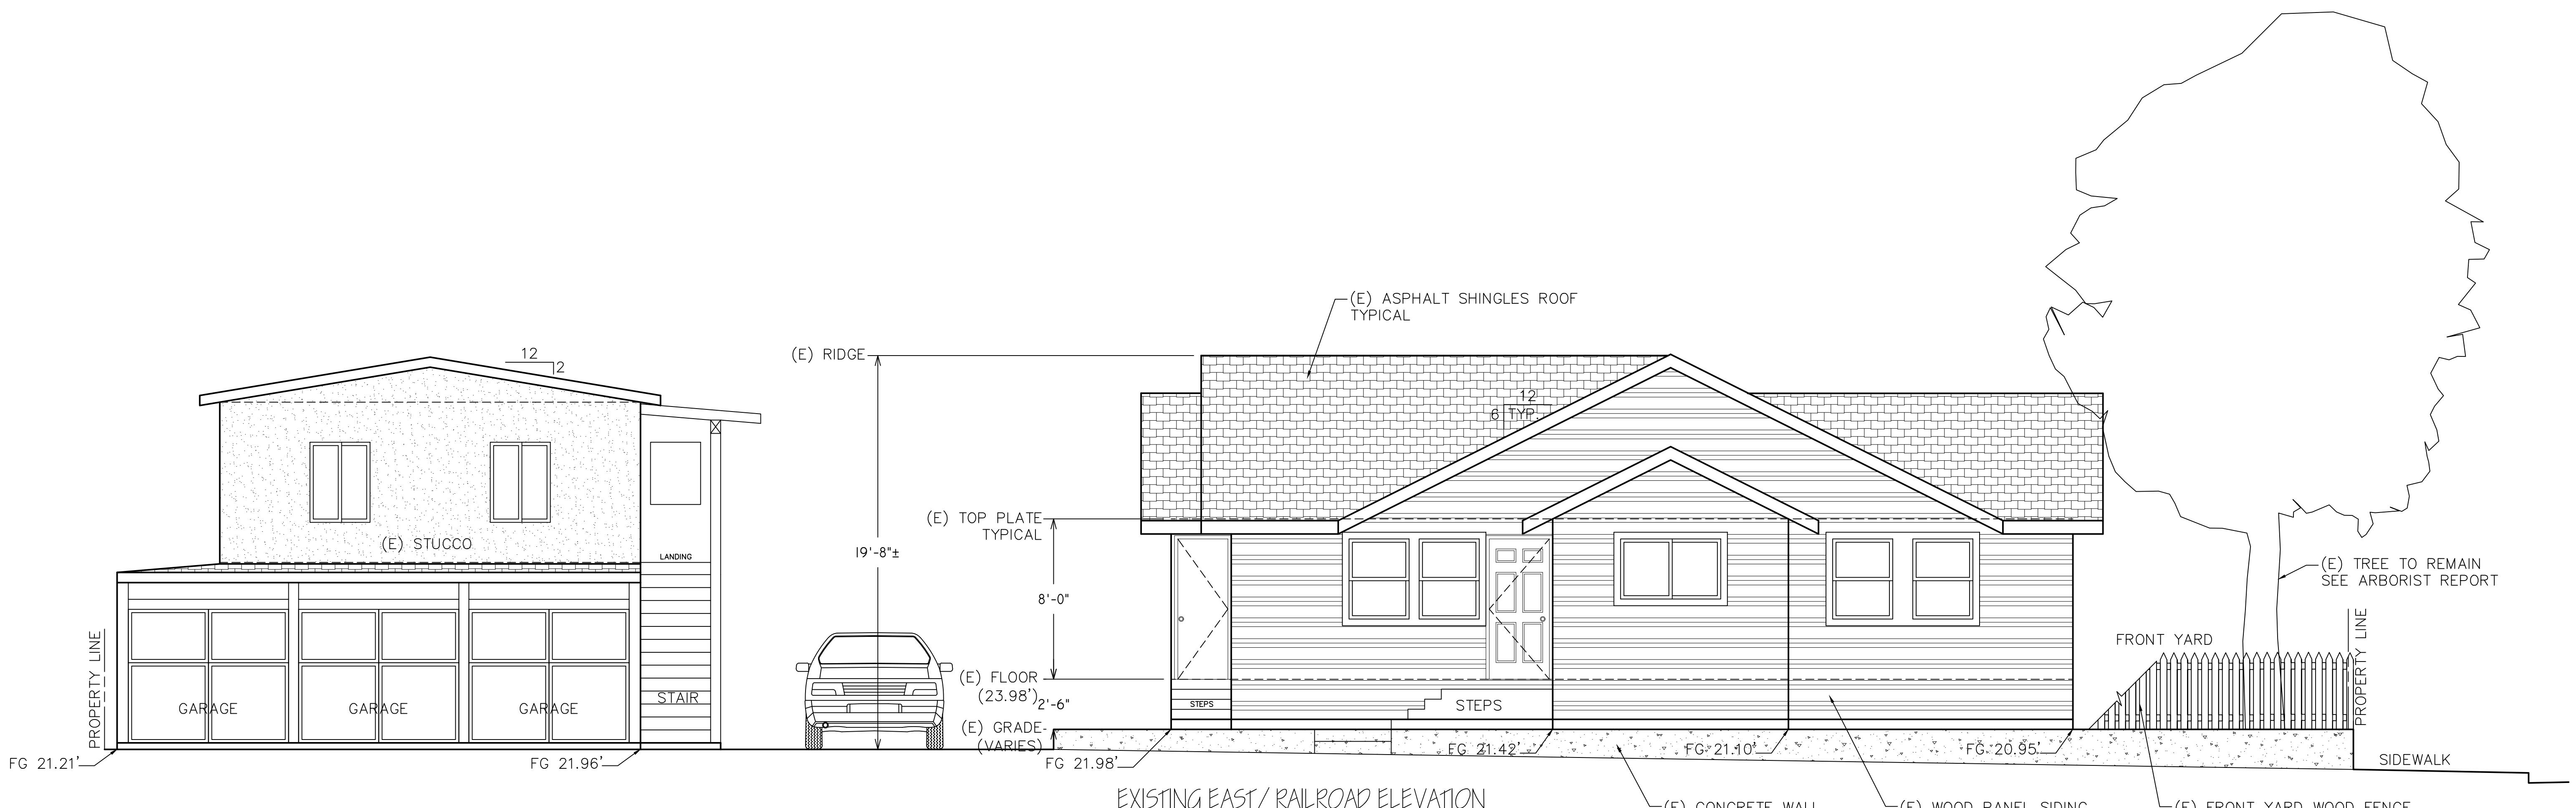


NOTE: ALL EXISTING STRUCTURES SHALL BE DEMOLISHED
UNDER SEPARATE PERMITS.

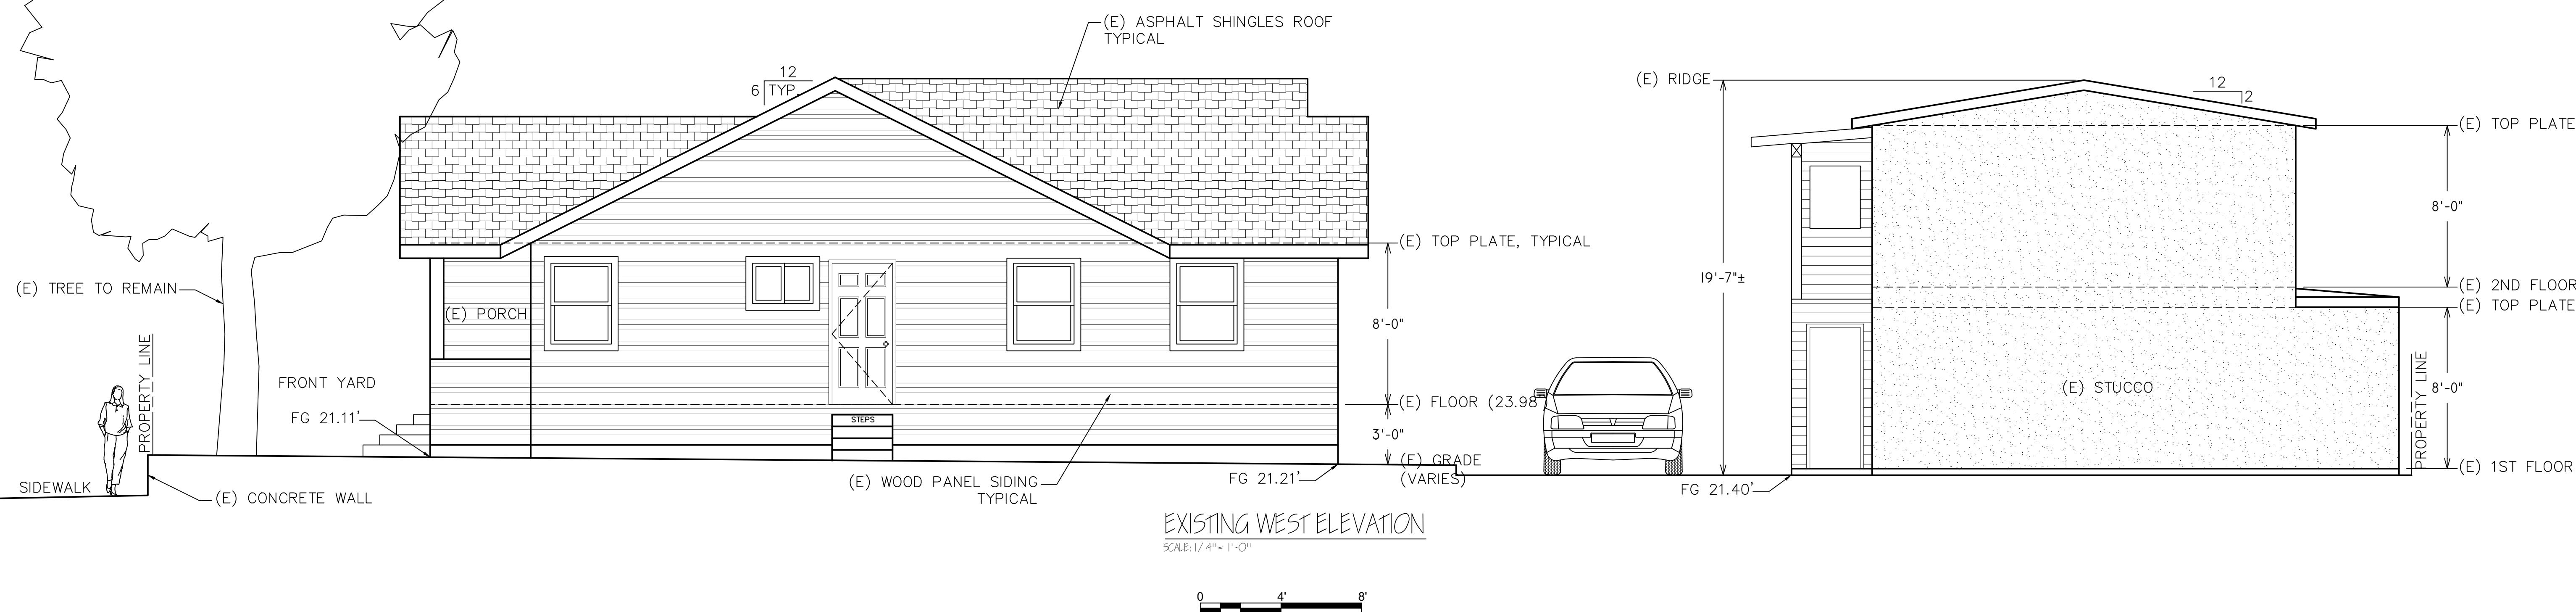


EXISTING ELEVATIONS

Drawn	MM
Checked	RL
Date	10/17/23
Scale	AS NOTED
For	PLANNING REVIEW

A9

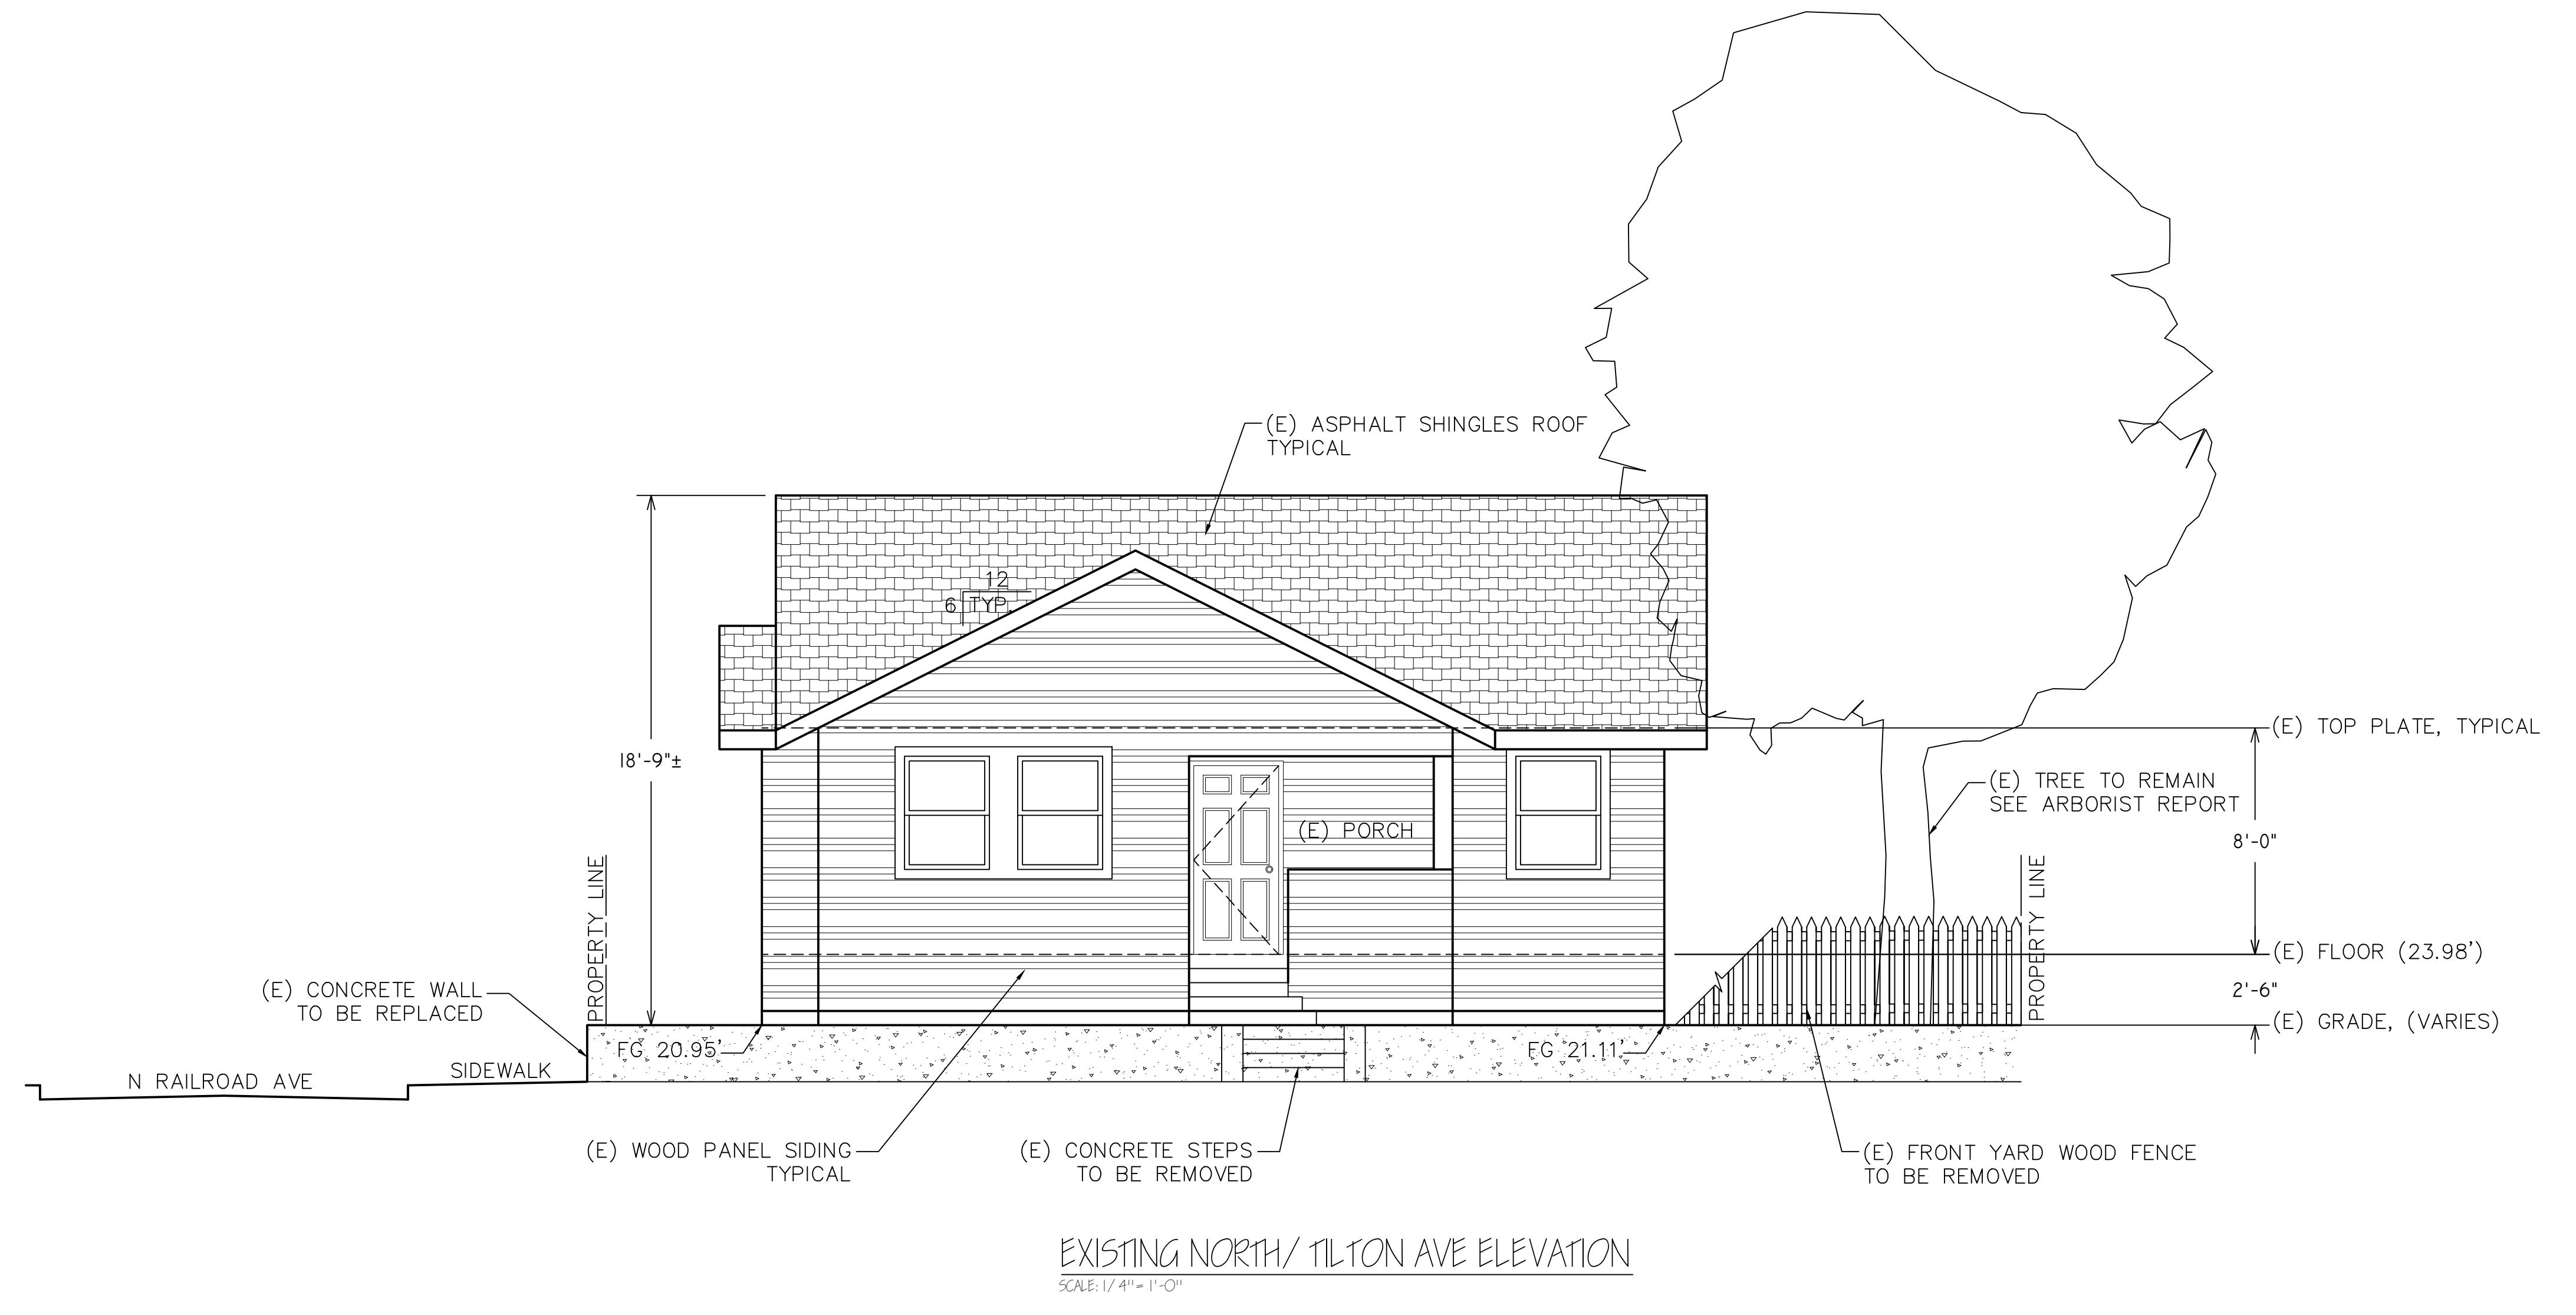

NOTE: ALL EXISTING STRUCTURES SHALL BE DEMOLISHED
UNDER SEPARATE PERMITS.

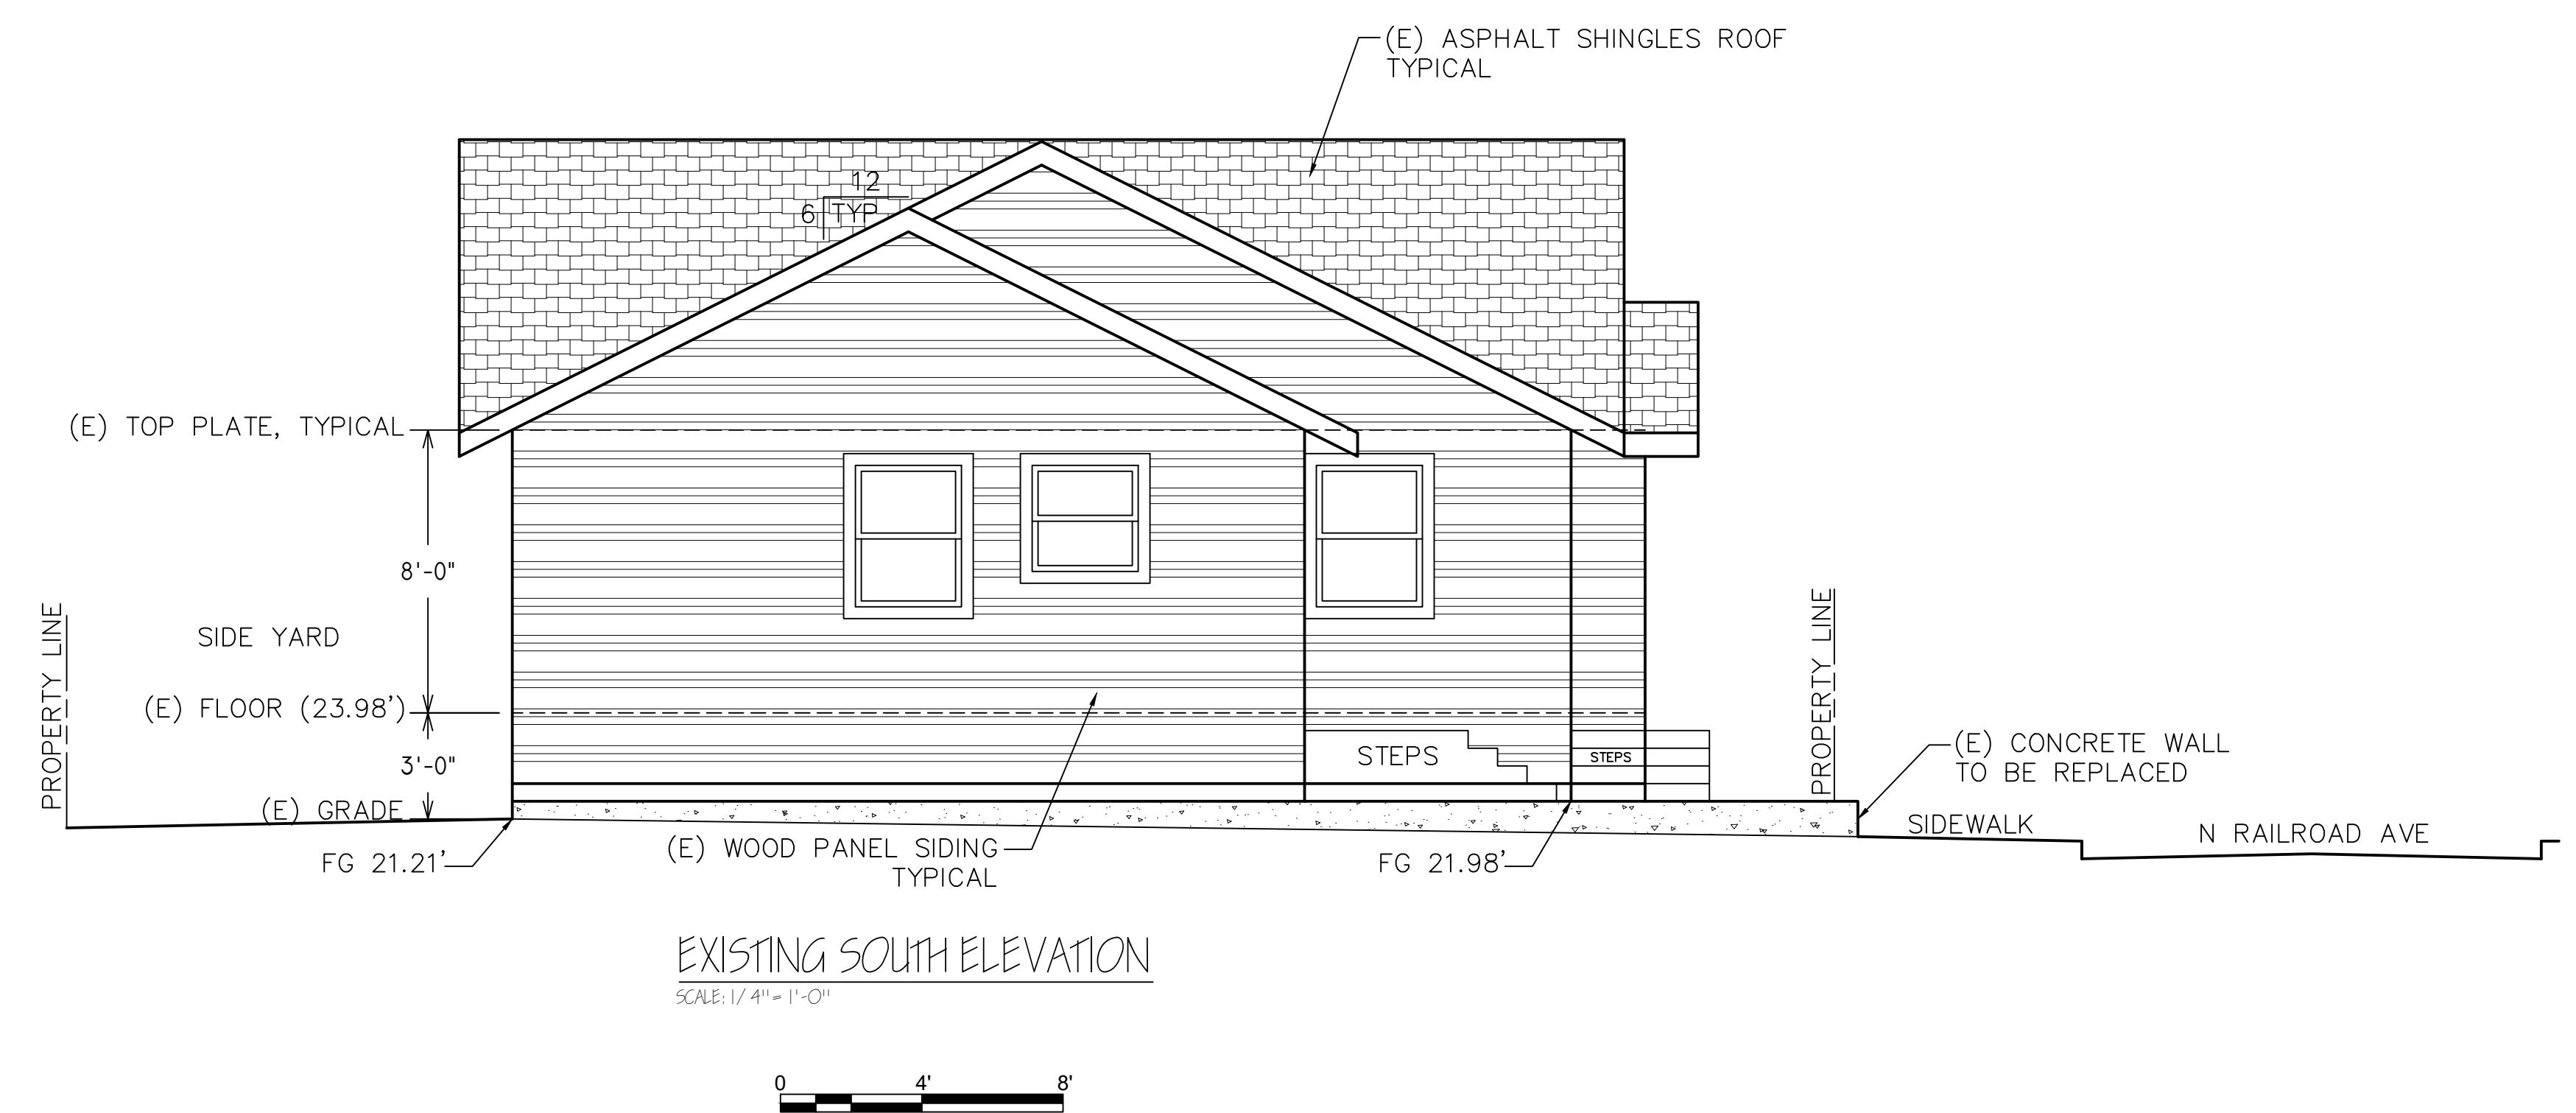

EXISTING ELEVATIONS


Drawn	MM
Checked	RL
Date	10/17/23
Scale	AS NOTED
For	PLANNING REVIEW
Sheet	

A10




REID LERNER ARCHITECTS
PHONE 408-842-9942
REIDLERNER@YAHOO.COM
7680 MONTEREY ST #105
GILROY, CA 95020

TILTON APARTMENTS
NEW MULTI-FAMILY APARTMENTS
328 TILTON AVENUE
SAN MATEO, CA 94401

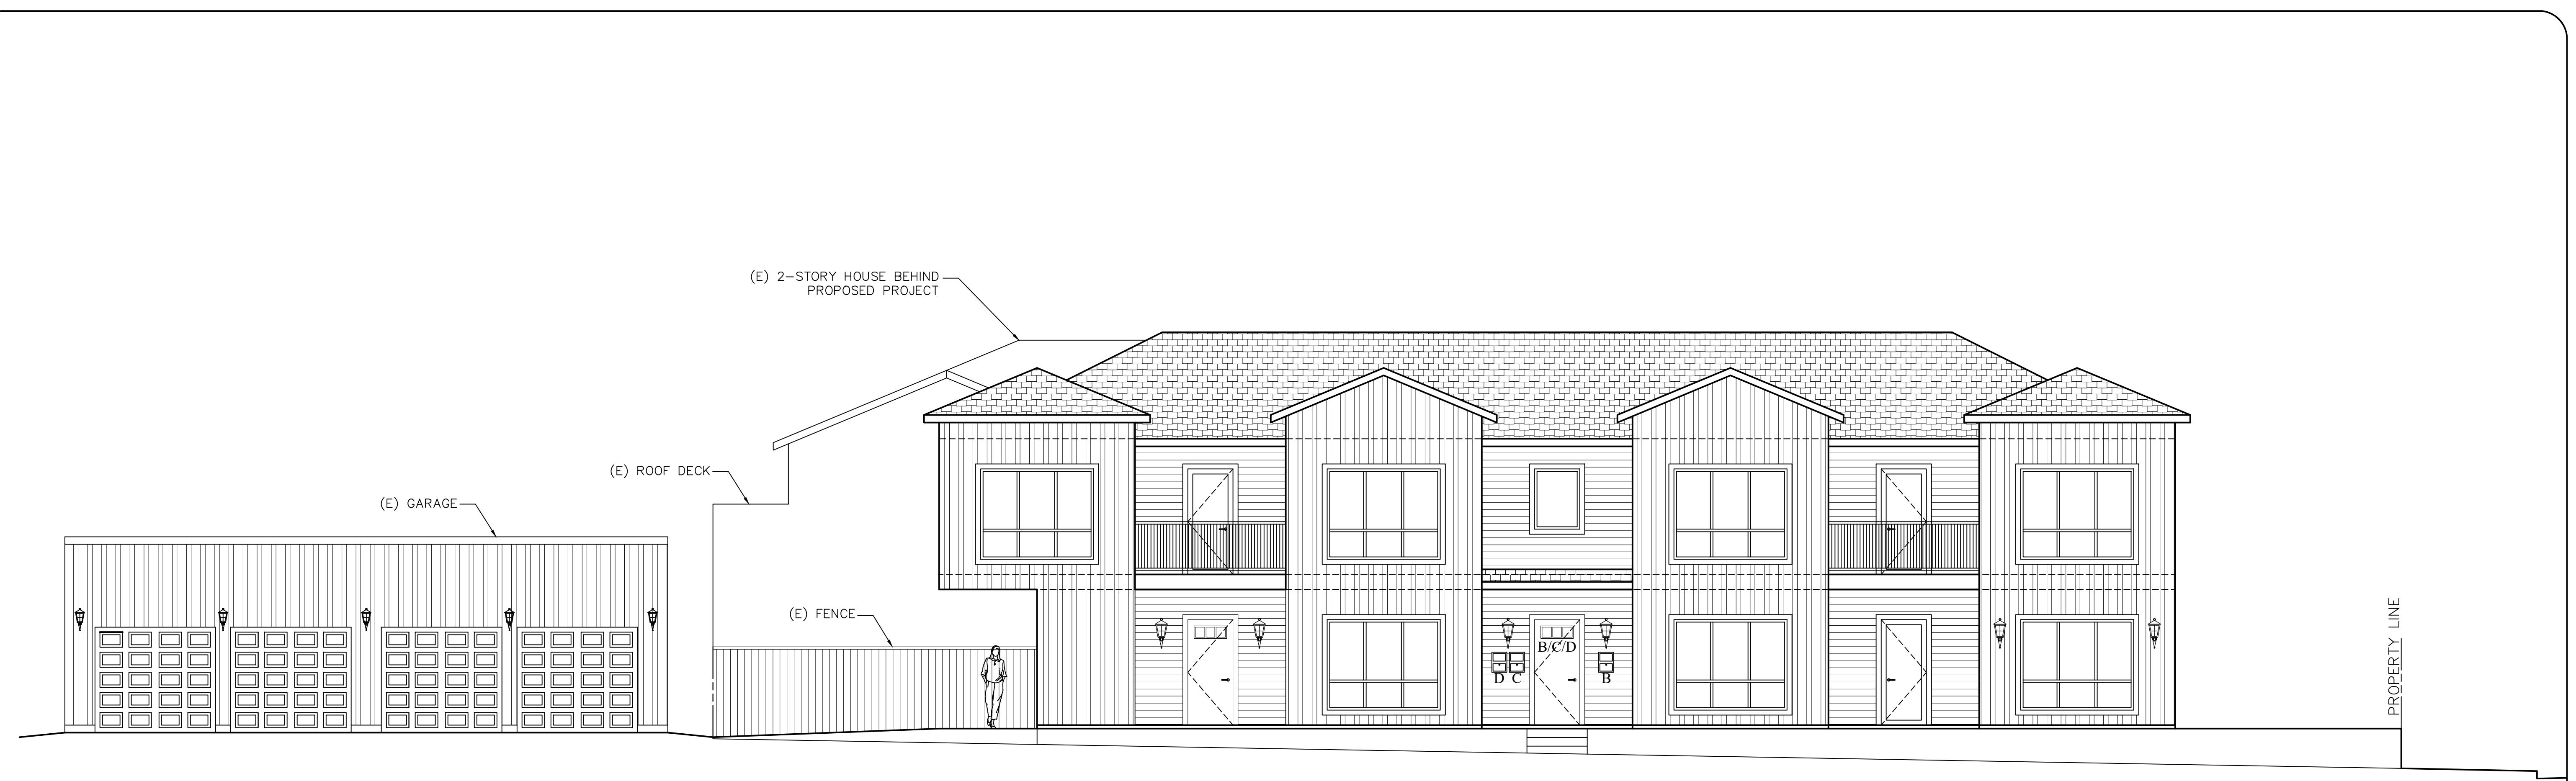

STREETSCAPE ELEVATION @ RAILROAD

SCALE: 3/16" = 1'-0"

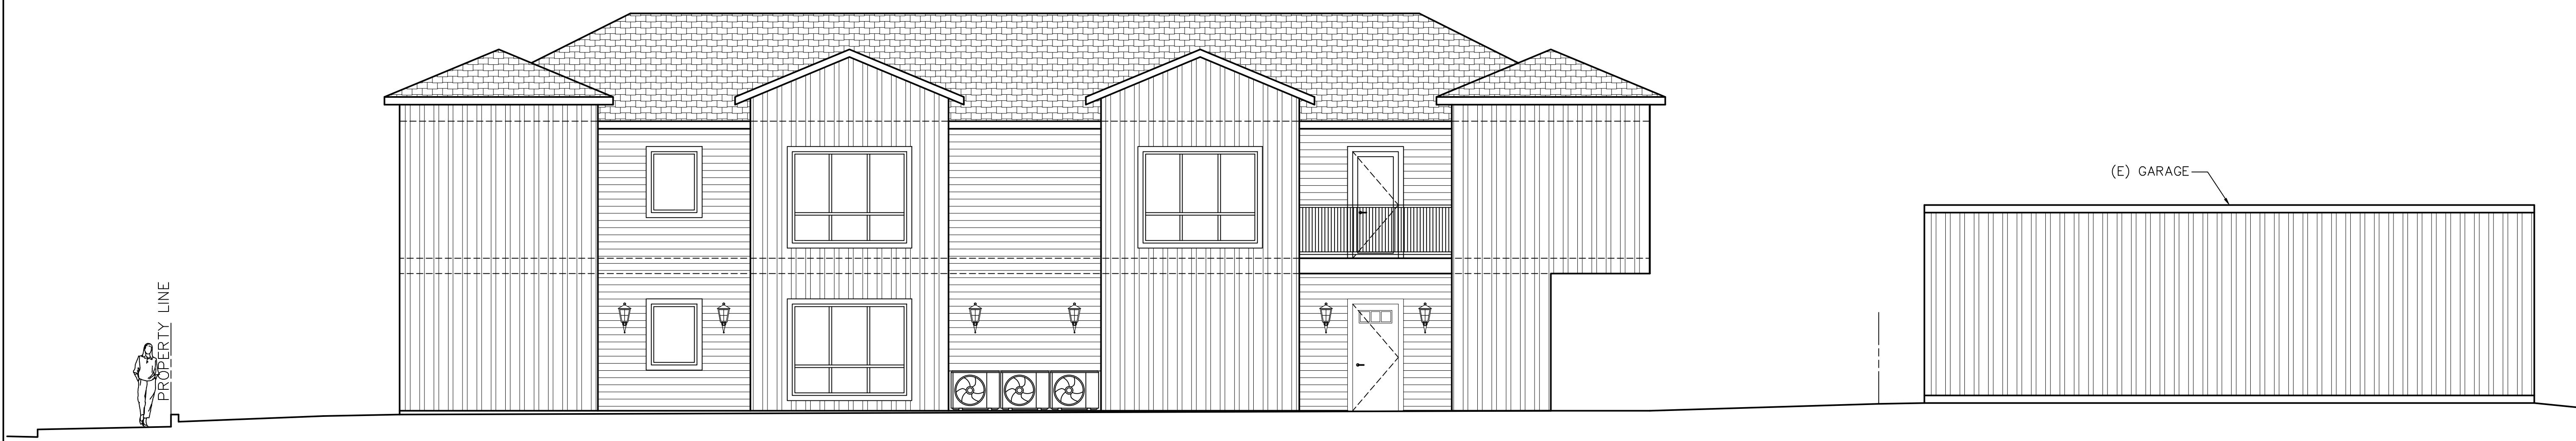



PROPOSED WEST ELEVATION

SCALE: 3/16"

A horizontal line representing a DNA sequence. The first 4' base pairs are highlighted in black, while the rest of the sequence is white. The label '4'' is placed above the black region.

Drawn	MM
Checked	RL
Date	10/17/23
Scale	AS NOTED
For	PLANNING REVIEW
Sheet	


A11

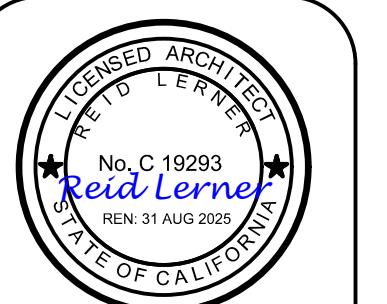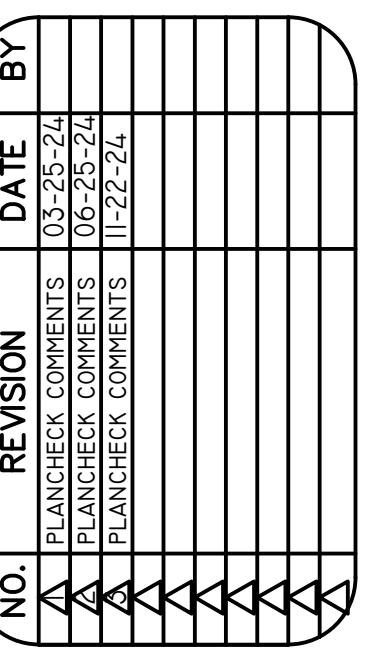

REID LERNER ARCHITECTS
PHONE 408-842-9942
REIDLERNER@YAHOO.COM
7680 MONTEREY ST #105
GILROY, CA 95020

TILTON APARTMENTS
NEW MULTI-FAMILY APARTMENTS
328 TILTON AVENUE
SAN MATEO, CA 94401

PROPOSED ELEVATIONS

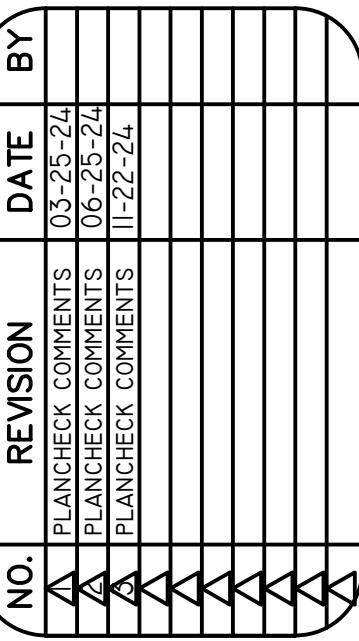

REID LERNER ARCHITECTS
PHONE 408-842-9942
REIDLERNER@YAHOO.COM
7680 MONTEREY ST #105
GILROY, CA 95020


TILTON APARTMENTS
NEW MULTI-FAMILY APARTMENTS
328 TILTON AVENUE
SAN MATEO, CA 94401

PROPOSED ELEVATIONS

Drawn MM
Checked RL
Date 10/17/23
Scale AS NOTED
For PLANNING REVIEW
Sheet

A12



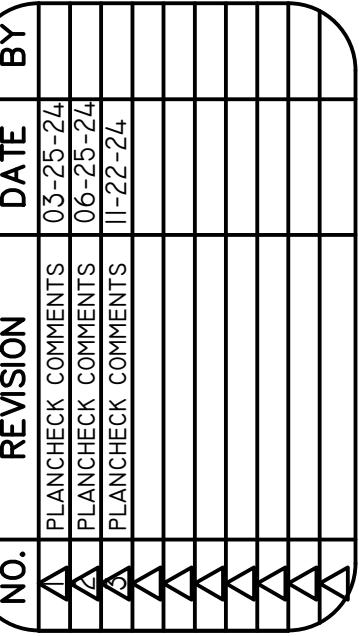


REID LERNER ARCHITECTS
PHONE 408-842-9942
REIDLERNER@YAHOO.COM
7680 MONTEREY ST #105
GILROY, CA 95020

TILTON APARTMENTS
NEW MULTI-FAMILY APARTMENTS
328 TILTON AVENUE
SAN MATEO, CA 94401


WINDOW LOCATION & PRIVACY DIAGRAM

Drawn	MM
Checked	RL
Date	10/17/23
Scale	AS NOTED
For	PLANNING REVIEW


A13

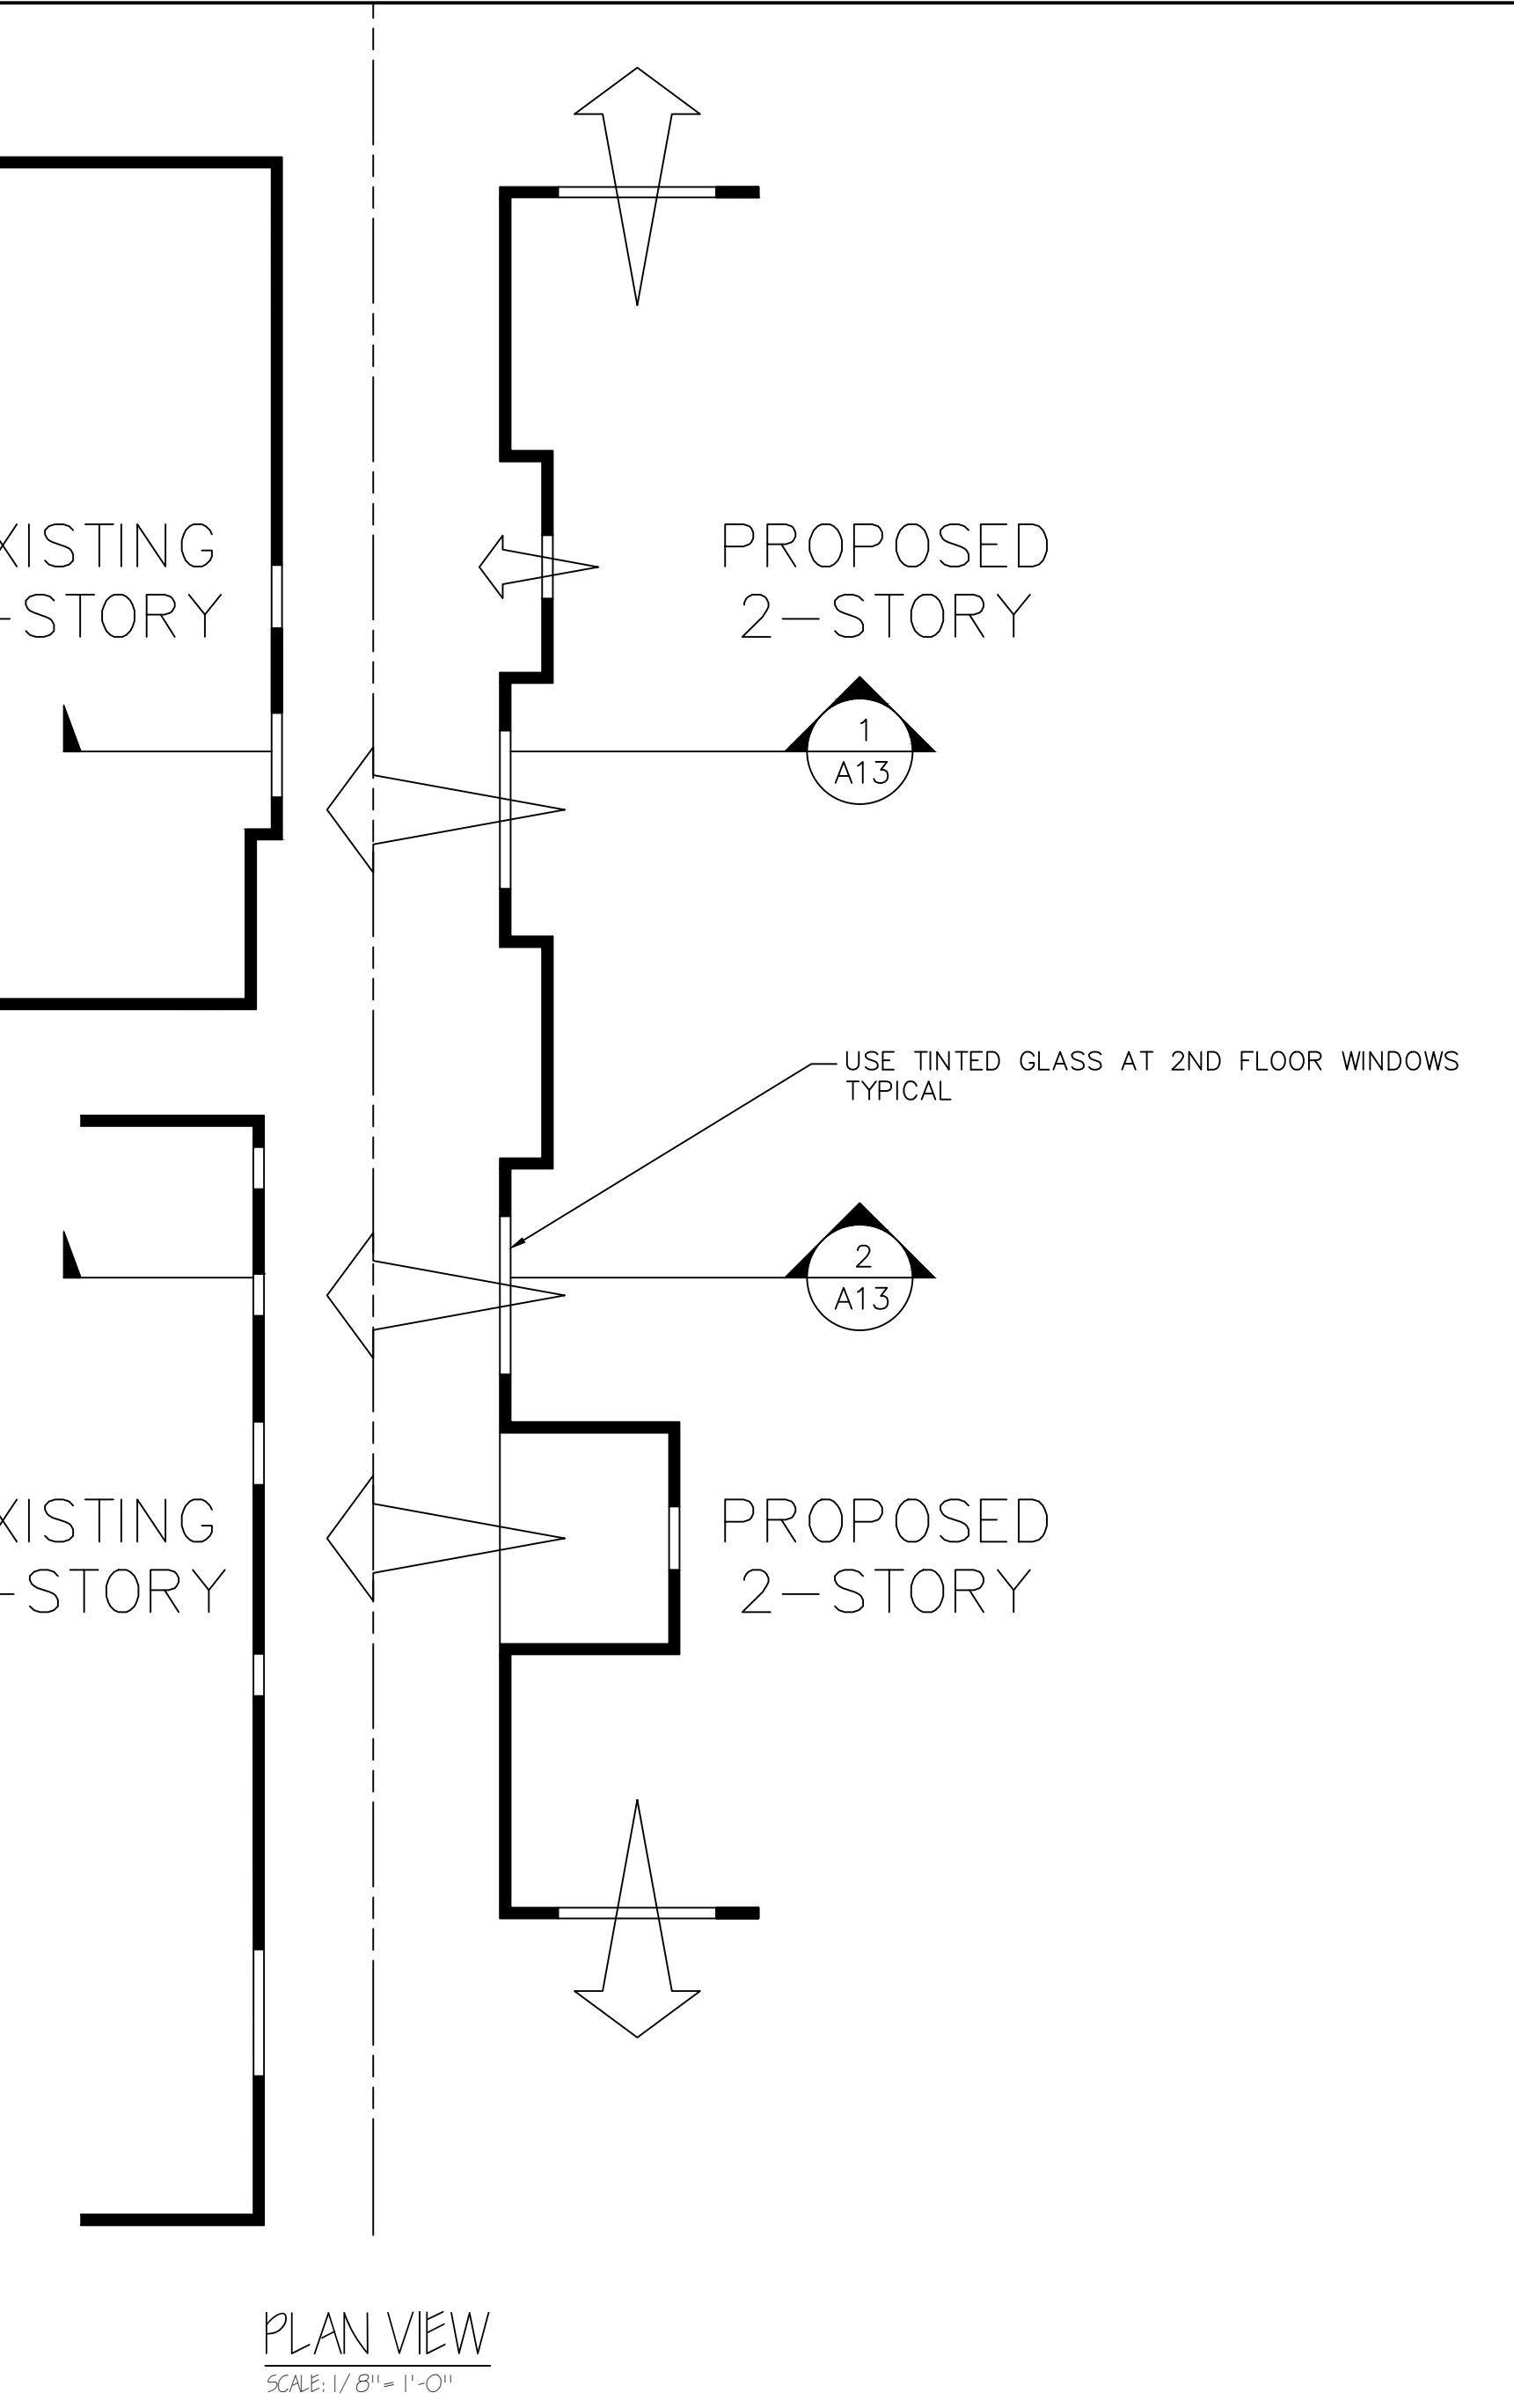

PLAN VIEW

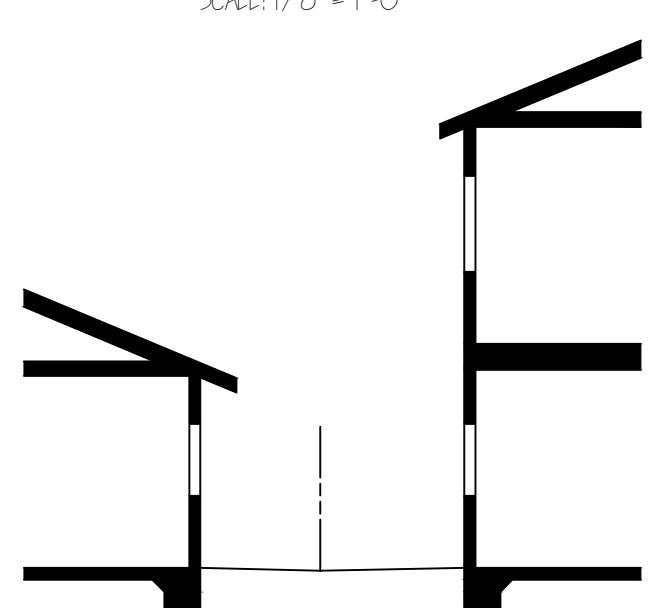


SECTION-I

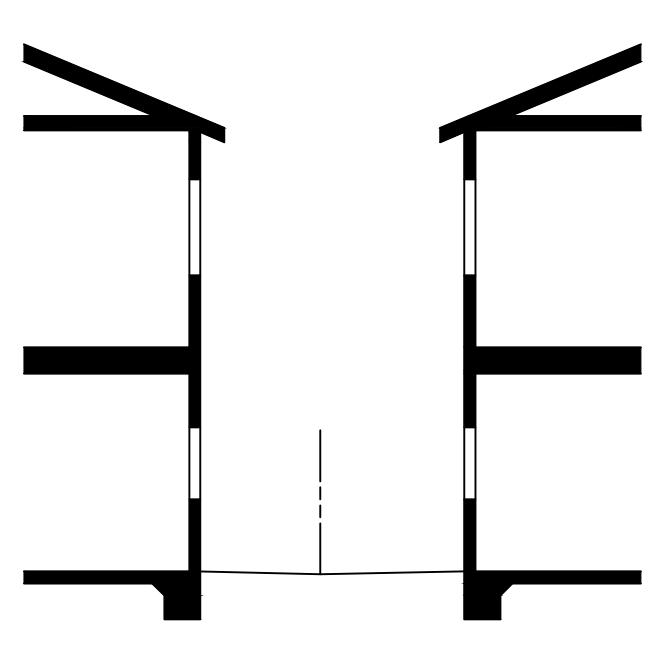

SECTION-2

WINDOW SCHEDULE NO

- 1) CONTRACTOR SHALL VERIFY ALL WINDOW SIZES, ROUGH OPENING, AND QUANTITY IN FIELD PRIOR TO ORDERING.
- 2) VERIFY ALL WINDOWS, FRAMES, GLAZING, AND HARDWARE WITH OWNER.
- 3) WINDOW SUBMITTALS TO BE DIRECTED TO THE ARCHITECT OF RECORD FOR REVIEW.
- 4) EMERGENCY EGRESS FROM SLEEPING ROOMS TO COMPLY WITH FOLLOWING:
MINIMUM NET CLEAR OPENABLE DIMENSION OF 5.7 SF IN AREA (CBC 1031.3.1).
MINIMUM NET CLEAR OPENABLE DIMENSION OF 24 INCHES IN HEIGHT (CBC 1031.3.2).
MINIMUM NET CLEAR OPENABLE DIMENSION 20 INCHES IN WIDTH (CBC 1031.3.2).
BOTTOM OF THE CLEAR OPENING SHALL NOT BE GREATER THAN 44 INCHES MEASURED FROM THE FLOOR (CBC 1031.3.3).
- 5) WINDOWS MUST HAVE LABELS FOR "U-FACTOR" & "SHGC" PER ENERGY CODE.

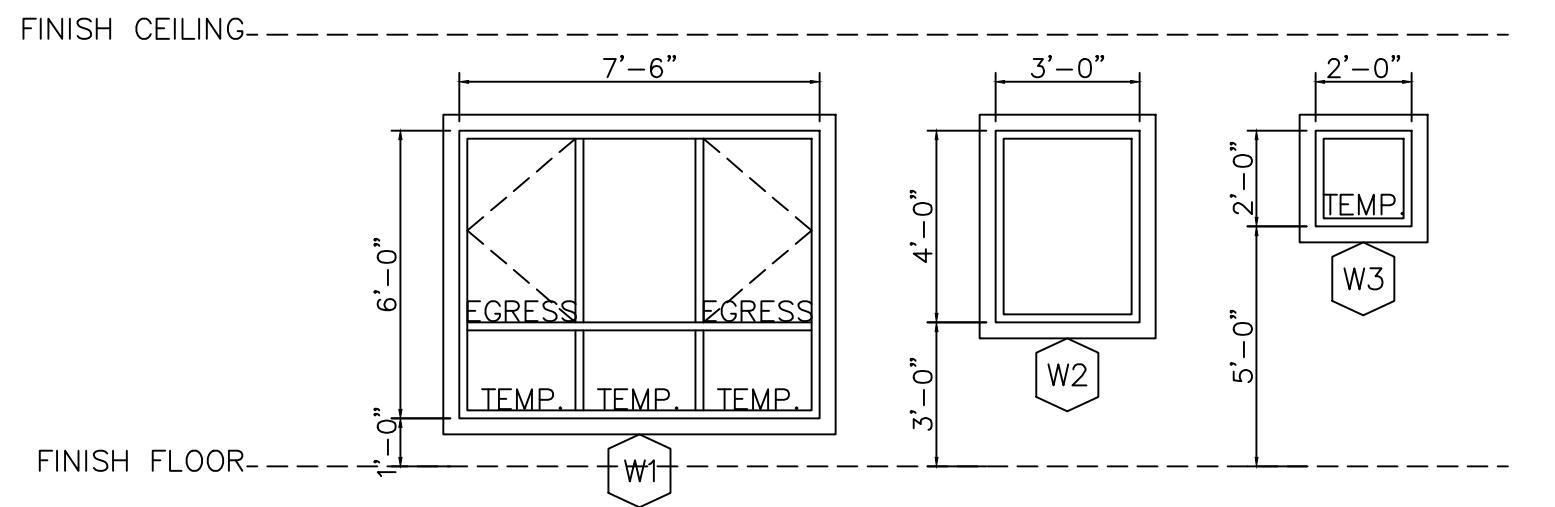

WINDOWS ELEVATION (EXTERIOR)


SCALE: 1/4" = 1'-0"

TILTON APARTMENTS
NEW MULTI-FAMILY APARTMENTS
328 TILTON AVENUE
SAN MATEO CA 9401

WINDOW SCHEDULE II F

Drawn	MM
Checked	RL
Date	10/17/23
Scale	AS NOTED
For	PLANNING REVIEW
Sheet	

A14

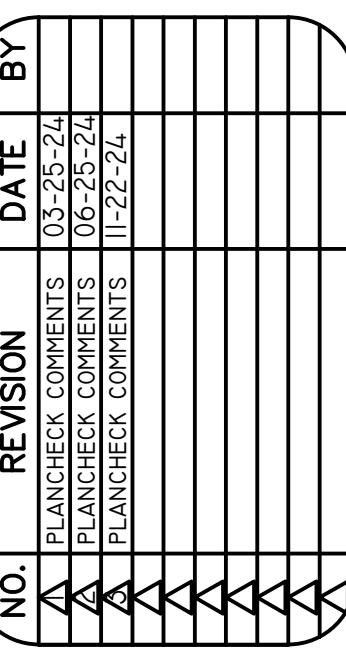

REID LERNER ARCHITECTS
PHONE 408-842-9942
REIDLERNER@YAHOO.COM
7680 MONTEREY ST #105
GILROY, CA 95020

TILTON APARTMENTS
NEW MULTI-FAMILY APAR-
TMENTS
328 TILTON AVENUE
SAN MATEO CA 94401



ARBORIST REPORT

TILTON APARTMENTS 328 TILTON AVENUE SAN MATEO, CA (PA-2023-071)

Submitted to:

Reid Lerner Architects
7680 Monterey Street #105
Gilroy, CA 95020

Prepared by:

David L. Babby
Registered Consulting Arborist® #399
Board-Certified Master Arborist® #WE-4001B

November 11, 2024

p.o. box 25295, san mateo, california 94402 • email: arborresources@comcast.net
office: 650.654.3351 • cell: 650.274.3656 • licensed contractor #796763

David L. Babby, Registered Consulting Arborist®

November 11, 2024

The canopy is asymmetrical and has an average spread of nearly 45 feet, extending predominantly in directions away from the home (more specifically, 15 feet towards the home, 20 feet over the street, and 50 feet east to west). Along its lower section, foliage consists predominantly of waterspouts due to extensive pruning in the past, and there are some dead branches along the west and east sides. Towards the north, branches grow around the adjacent utility pole, phone and cable wires. Some branches which extend over the home are heavy and bow downward, increasing their possibility for breaking.

Based these observations, I regard the tree's health to be fair, structural integrity as poor, and assign a suitability for preservation rating of poor. The dominant factor regarding the poor suitability involves the tree's unfavorable location beneath high-voltage wires, resulting in an irreparable structure throughout its remaining lifespan. Furthermore, its large size within a relatively confined setting reveals it has outgrown the location.

3.0 IMPACT ANALYSIS

My analysis considers both the canopy and root zone. For the canopy, I do not foresee any significant conflicts posed by constructing the proposed building. The limb structure and form along the building side is already upright, and only small branches would require pruning to achieve a 5-foot clearance from both the building and construction scaffolding.

The root zone, however, would be significantly impacted by introducing the following: a concrete staircase 16 feet east of the trunk; a 5-foot wide, concrete walkway 4.5 feet south of the trunk (this walk will abut and align the new building); and constructing the building's foundation 10 feet south from the trunk, which will also require subexcavation and compaction, likely at least 5 feet beyond the foundation.

For the staircase and walkway, overexcavation needed to form and pour the concrete will result in soil excavation by at least an additional 12 inches towards the trunk, establishing root loss as close as 15 feet towards the east and 3.5 feet towards the south (building side). To construct the building's foundation, subexcavation and compaction is expected to occur

Page 3 of 5

David L. Babby, Registered Consulting Arborist® November 11, 2024

TABLE OF CONTENTS

SECTION	TITLE	PAGE
1.0	INTRODUCTION & ASSIGNMENT	1
2.0	OBSERVATIONS	2
3.0	IMPACT ANALYSIS	3
4.0	CONCLUSIONS	4
5.0	ASSUMPTIONS AND LIMITING CONDITIONS	5

EXHIBITS

EXHIBIT	TITLE
A	SITE MAP (one sheet)
B	PHOTOGRAPHS (three sheets)

i

David L. Babby, Registered Consulting Arborist® November 11, 2024

1.0 INTRODUCTION & ASSIGNMENT

A multi-family apartment building is being planned for construction at 328 Tilton Avenue, San Mateo (APN 032-323-010). The site occupies the south corner of Tilton Avenue and Railroad Avenue, and is currently occupied by two existing structures which are planned for demolition. As there is one heritage tree located on the property where construction activities¹ are proposed within 10 times its trunk diameter, I have been retained by the project architect, Reid Lerner Architects to evaluate the tree, review the proposed design, and prepare this *Arborist Report*. Specific tasks assigned to execute are as follows:

- Visit the site on 10/3/24 and 11/7/24 to identify the heritage tree, measure its trunk diameter at 54 inches above grade,² estimate its height and average canopy spread, evaluate its condition, and obtain photos.
- Review the project plan set, dated 6/25/24, prepared by Reid Lerner Architects.
- Provide conclusions as to the extent of impacts and its proposed disposition. Because I am recommending removal, this report is structured as such, and does not include any protection measures.
- Include a copy of the *Topographic Survey*, dated 5/15/23 and prepared by Zhen's Land Surveying Corp., to represent the tree and its approximate dripline (i.e. canopy spread); see Exhibit A.
- Prepare a written report presenting the above information, and submit via email as a PDF document.

For disclosure, I am an independent consulting arborist operating under the name of Arbor Resources, and neither my company or I will execute any tree work recommended in this report (additional disclosures are presented within Section 6.0).

¹ Section 13.40.030(g) defines construction activity as any work associated with or requiring a permit for any new building, building addition, building demolition, grading, excavation or paving. This includes necessary related activities which may or may not be shown on site plans, including, but not limited to the following: storing/staging of materials, site access, parking, placement of temporary structures, debris disposal, additional excavation and landscaping.

² Measurements align with the City's *Protected Trees Ordinance Administrative Guidelines*, dated 7/13/21.

328 Tilton Avenue, San Mateo
Reid Lerner Architects
Page 1 of 5

David L. Babby, Registered Consulting Arborist® November 11, 2024

2.0 OBSERVATIONS

The subject tree is a large silver maple (*Acer saccharinum*) with a trunk diameter of 26.3 inches measured at 54 above grade. Based on this diameter, it is classified as a heritage tree pursuant to Section 13.40.030(k)(2) of the San Mateo Municipal Code (the threshold being ≥15 inches for all trees other than oaks).

The tree's location can be viewed on the site map in Exhibit A, and photographs are presented in Exhibit B. For directional references, consider project north being towards Tilton Avenue.

The maple is located in the front yard at the property's northwest corner. Its trunk is 15.5 feet northwest from the existing home, and is partly situated beneath high-voltage electrical wires (distribution wires). The subject lot is elevated above the adjacent sidewalk, and is bordered along the north (sidewalk) side by a 1.3-foot tall retaining wall 2 feet from the trunk's base. Ground beneath the canopy and within the property is flat, and contains dead lawn, barren ground, and a narrow concrete walkway 7 feet southwest of the trunk. The tree's rooting area is relatively confined, being entirely or highly concentrated in directions away from the wall.

The site appears high use, and immediate targets beneath and within striking distance of the tree include the following: existing home, sidewalk, street, vehicles and persons occupying the house and traveling along the street/sidewalk, and an adjacent utility pole and phone/cable wires. The high-voltage electrical wires above can also present a threat should branches not remain clear at all times.

The tree is an estimated 45 feet tall, and due to its location beneath high-voltage wires, its height has been regularly reduced, and will continue being so throughout its remaining lifespan. This specific pruning practice is particularly an issue for silver maples, resulting in all ensuing branches (aka watersprouts) being weakly-attached, prone to breaking during storm events, and growing at ever-increasing rates following each pruning cycle.

328 Tilton Avenue, San Mateo
Reid Lerner Architects
Page 2 of 5

David L. Babby, Registered Consulting Arborist® November 11, 2024

David L. Babby, Registered Consulting Arborist® November 11, 2024

5.0 ASSUMPTIONS AND LIMITING CONDITIONS

- Information presented herein covers only the subject silver maple, and reflects its size, condition and areas viewed from the ground, project site, sidewalk and street on 10/3/24 and 11/7/24.
- Observations were performed visually without probing, coring, dissecting or excavating.
- The assignment pertains solely to the subject tree, and I hold no opinion towards other trees on or surrounding the project area.
- I cannot provide a guarantee or warranty, expressed or implied, that deficiencies or problems of the subject tree or property in question may not arise in the future.
- No assurance can be offered that if all my recommendations and precautionary measures (verbal or in writing) are accepted and followed that the desired results may be achieved.
- I cannot guarantee or be responsible for the accuracy of information provided by others.
- I assume no responsibility for the means and methods used by any person or company implementing the recommendations presented in this report.
- The information provided herein represents my opinion. Accordingly, my fee is in no way contingent upon the reporting of a specified finding, conclusion or value.
- I am an independent consulting arborist operating under the name of Arbor Resources, and neither my company or I will engage in executing any work associated with the tree.
- Information presented on the site map in Exhibit A is solely intended to approximately represent the tree's location, size, and protection zone and materials (versus surveyed points).
- This report is proprietary to me and may not be copied or reproduced in whole or part without prior written consent. It has been prepared for the sole and exclusive use of the parties to who submitted for the purpose of contracting services provided by David L. Babby.
- If any part of this report or copy thereof be lost or altered, the entire evaluation shall be invalid.

Prepared By:

Date: November 11, 2024
David L. Babby
Registered Consulting Arborist® #399
Board-Certified Master Arborist® #WE-4001B
CA Licensed Tree Service Contractor #796763 (C61/D49)



328 Tilton Avenue, San Mateo
Reid Lerner Architects
Page 4 of 5

David L. Babby, Registered Consulting Arborist® November 11, 2024

David L. Babby, Registered Consulting Arborist® November 11, 2024

EXHIBIT A:

SITE MAP

(one sheet)

NO.	REVISION	DATE	BY
1	PLANCHECK CORPENS	10/3/24	REID LERNER ARCHITECTS
2	PLANCHECK CORPENS	11/7/24	REID LERNER ARCHITECTS
3	PLANCHECK CORPENS	11/7/24	REID LERNER ARCHITECTS



TILTON APARTMENTS
NEW MULTI-FAMILY APARTMENTS
328 TILTON AVENUE
SAN MATEO, CA 94401

ARBORIST REPORT &
TREE PROTECTION PLAN

Drawn	MM
Checked	RL
Date	10/17/23
Scale	AS NOTED
For	PLANNING REVIEW
Sheet	

T-1

NO.	REVISION	DATE	BY
1	PLANCHECK-COMMENS	10/25/24	
2	PLANCHECK-COMMENS	10/25/24	
3	PLANCHECK-COMMENS	10/25/24	




REID LERNER ARCHITECTS
PHONE 408-542-9942
REIDLERNER@GMAIL.COM
7660 MONTEREY ST #105
GILROY, CA 95020

TILTON APARTMENTS
NEW MULTI-FAMILY APARTMENTS
328 TILTON AVENUE
SAN MATEO, CA 94401


ARBORIST REPORT &
REQUIRED TREE
PLANTING FORM

Drawn	MM
Checked	RL
Date	10/17/23
Scale	AS NOTED
For	PLANNING REVIEW
Sheet	

T-2

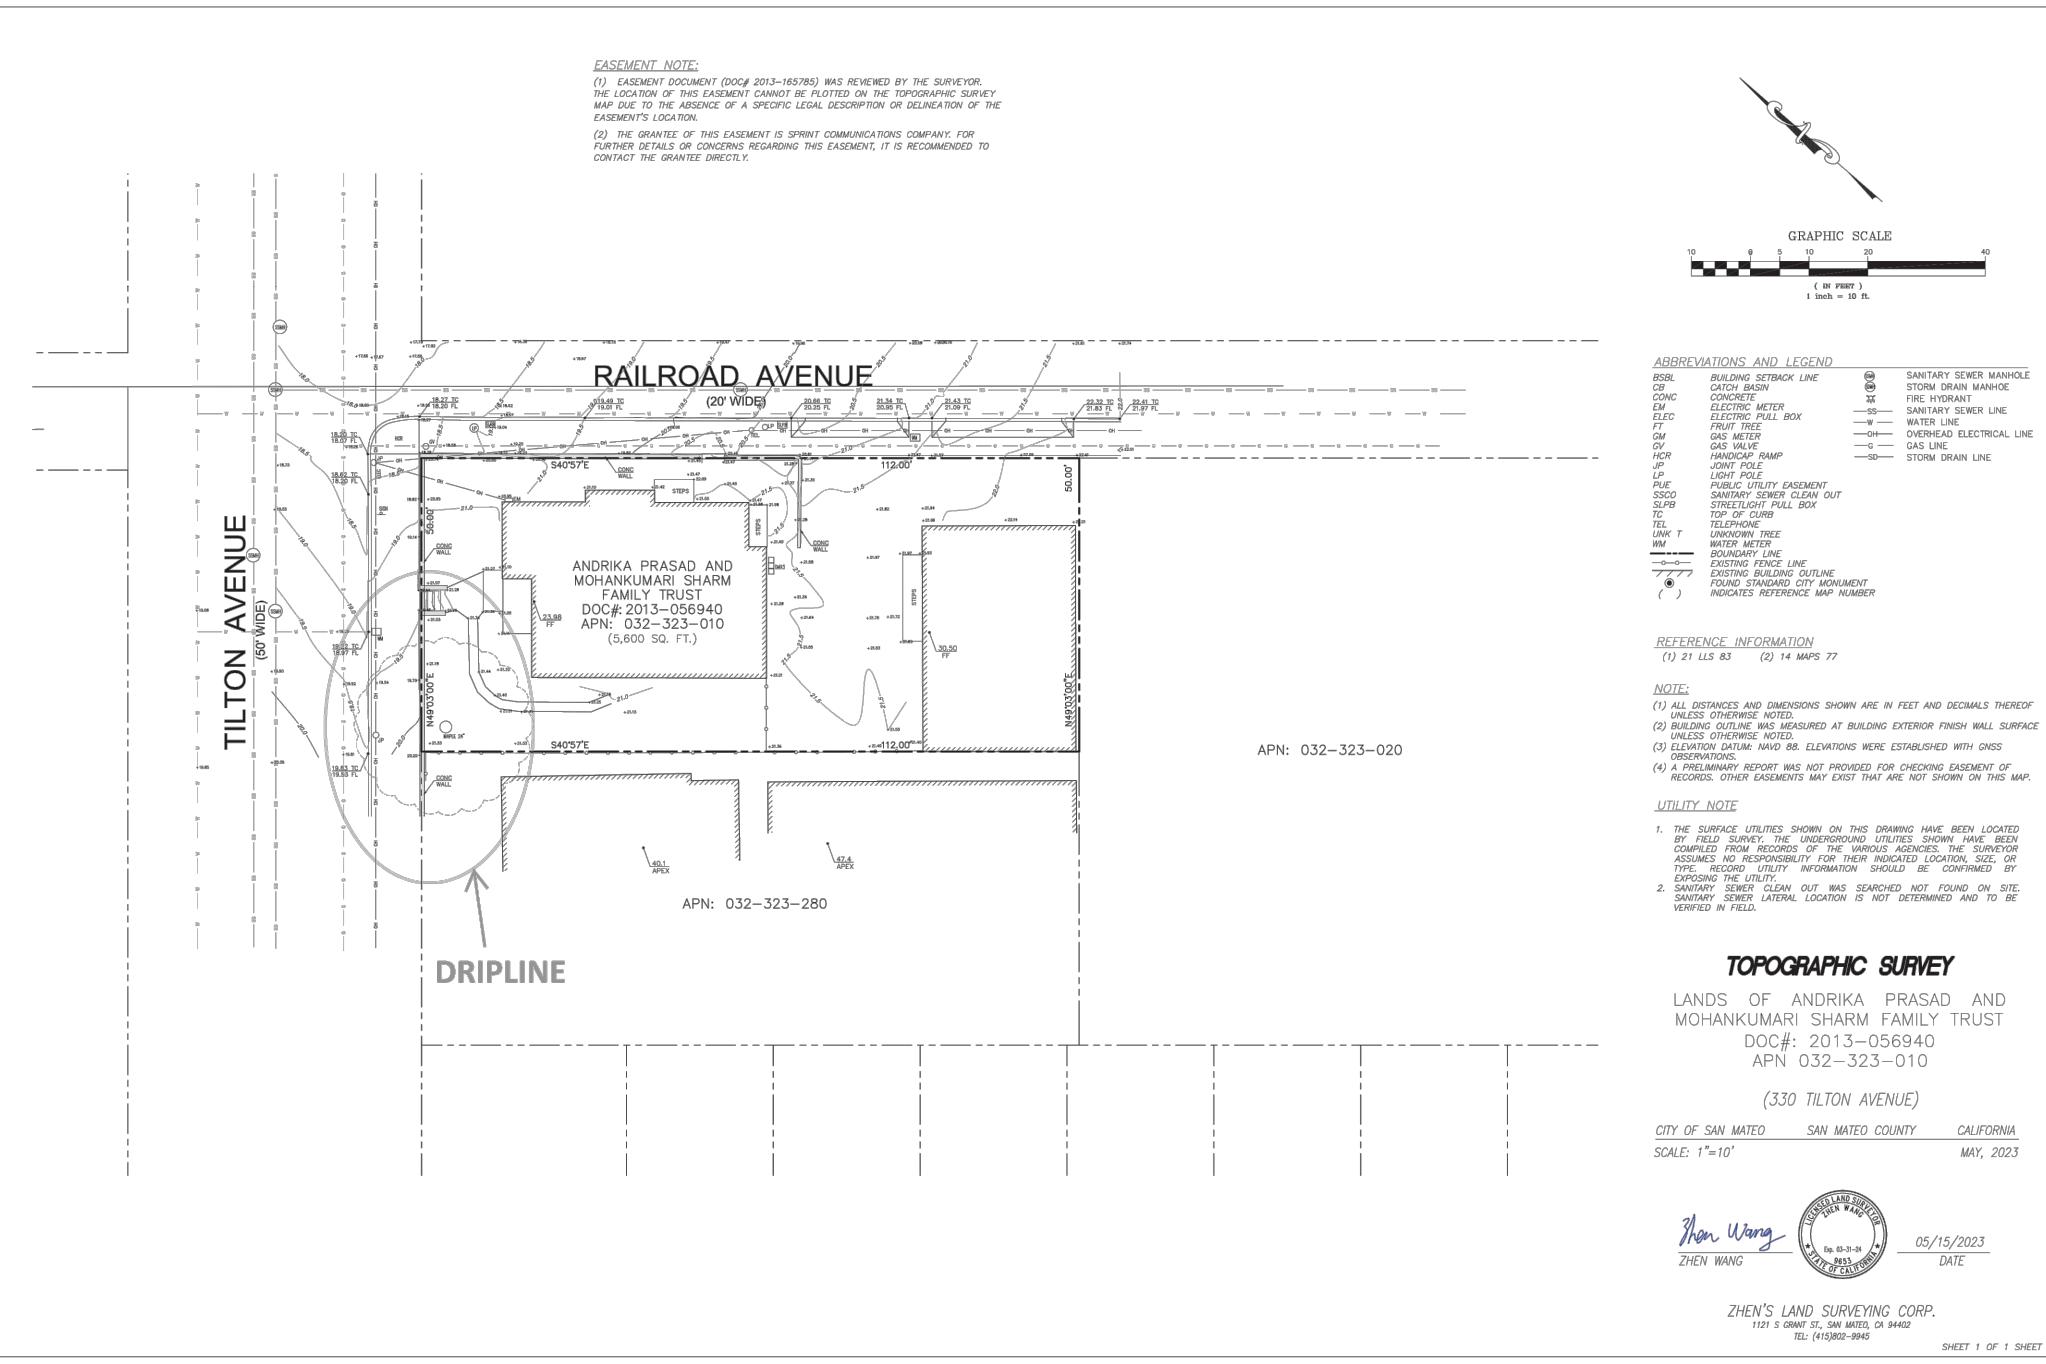

328 Tilton Avenue, San Mateo
Reid Lerner Architects

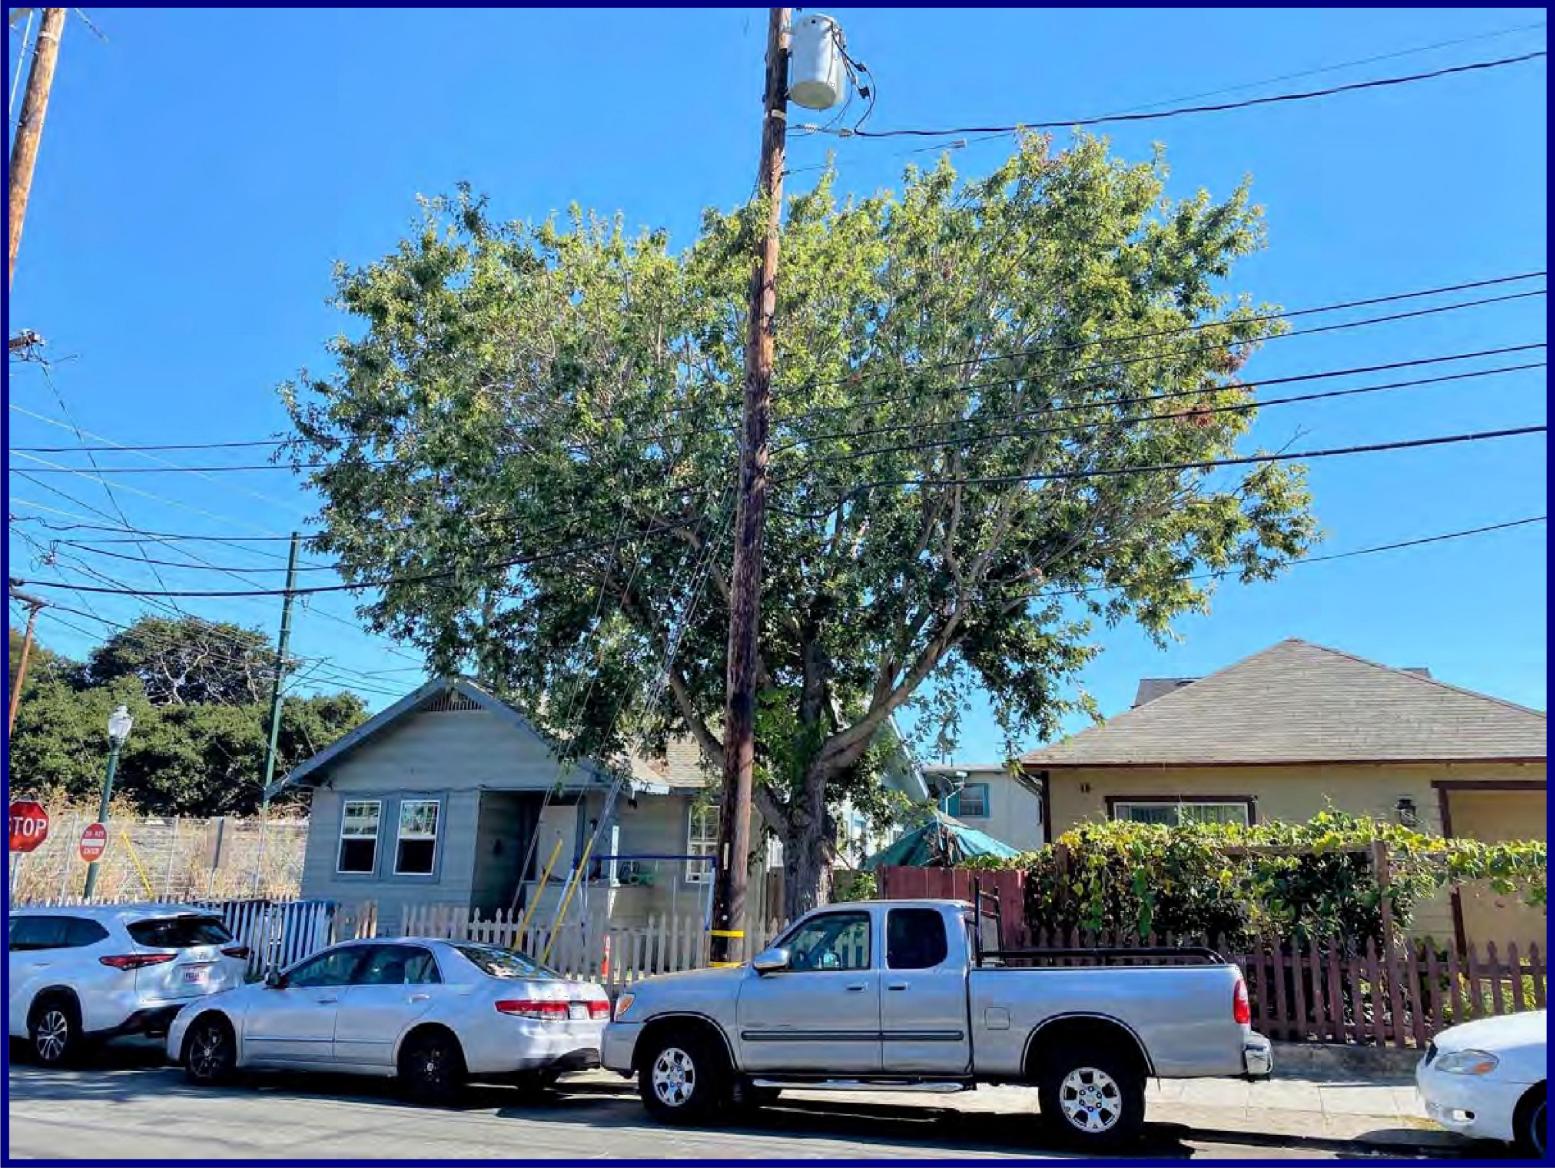

Page B-1



328 Tilton Avenue, San Mateo
Reid Lerner Architects



Page B-2



328 Tilton Avenue, San Mateo
Reid Lerner Architects

Required Tree Planting

Zoning Code, Section 27.71 – Landscape, requires all projects to have a minimum ratio of 1 tree per 400 square feet of landscaped area. Existing trees that are a minimum of 6 inch diameter may count toward this total.

Landscape Area: 968 sq. ft. ÷ 400 = 2 (a)

Number of existing trees from Tree Evaluation Schedule with a 6 inch or greater diameter to be preserved: 0 (b)

Landscape Unit (LU) value of trees to be removed from the Tree Evaluation Schedule: 1 (c)

Minimum LU value to be replaced and/or met through payment of in-lieu fees: [a – b + c = d] 3 (d)

New Trees:
A "landscape unit" (LU) value equivalent to (d) above, must either be planted on site, or an "in-lieu" fee paid to the city's street tree planting fund. If the LU value shown at (e) is not equal or greater than (d), then an in-lieu fee must be paid to the City's street tree planting fund at the rate defined annually in the City's Comprehensive Fee Schedule for each deficient LU.

New Trees Being Planted*			
Quantity	Size	LU Value	Total LU Value
5	15 gallon	1	5
1	24 inch box	2	2
	36 inch box	3	
	48 inch box	4	

Total LU Value of new trees being proposed: 7 (e)

*New replacement trees shall be in addition to and not substitute requirements for new street trees, parking lot trees or other required trees.

Fees Owed to the City Street Tree Planting Fund:

If (d) is greater than (e), there will be an LU value deficit calculated as follows:

[d – e] x (the annually defined \$ per LU value as per Current Comprehensive Fee Schedule) = \$


**IRRIGATION NOTES**

1. THE IRRIGATION SYSTEM IS TO BE INSTALLED IN CONFORMANCE WITH ALL LOCAL CODES.
2. THIS IRRIGATION DESIGN IS DIAGRAMMATIC IN NATURE AND DOES NOT REPRESENT AN EXACT LAYOUT. THE CONTRACTOR SHALL MAKE MINOR ADJUSTMENTS IN HEAD, VALVE, AND PIPING LAYOUT. FOR GRAPHIC CLARITY, PIPING MAY BE SHOWN OUTSIDE OF PLANTING AREAS BUT SHOULD BE INSTALLED IN BEDS WHENEVER POSSIBLE.
3. REMOTE CONTROL VALVES SHALL BE INSTALLED FLUSH WITH FINISH GRADE AND SHOULD BE INSTALLED IN PLANTING AREAS ONLY. USE EXISTING VALVE BOXES WHEN POSSIBLE.
4. WHERE PIPE PASSES UNDER DRIVING SURFACES, AND WALKS PROVIDE PVC SLEEVES AS NOTED ON PLANS. CONTRACTOR TO USE EXISTING SLEEVING WHEN POSSIBLE AND IS TO LOCATE ON SITE.
5. CONTRACTOR TO CONFIRM THE LOCATION OF ALL EXISTING UTILITIES AND UNDERGROUND STRUCTURES PRIOR TO EXCAVATION OF TRENCHES. CONTRACTOR TO REPAIR ANY DAMAGES CAUSED BY, OR DURING THE PERFORMANCE OF HIS WORK AT NO EXTRA COST TO THE OWNER.
6. A DIAGRAM OF THE IRRIGATION PLAN SHOWING HYDROZONES SHALL BE KEPT WITH THE IRRIGATION CONTROLLER FOR SUBSEQUENT MANAGEMENT PURPOSES.
7. AN IRRIGATION AUDIT REPORT SHALL BE COMPLETED BY A CERTIFIED IRRIGATION AUDITOR AT THE TIME OF FINAL INSPECTION

SOIL PREPARATION, MULCH AND AMENDMENTS

THE FOLLOWING CRITERIA SHALL BE USED IN THE PREPARATION OF ON-SITE SOILS AND FOR MULCHING PROCEDURES:

- A) PRIOR TO THE PLANTING OF ANY MATERIALS, COMPAKTED SOILS SHALL BE TRANSFORMED TO A FRIABLE CONDITION. ON ENGINEERED SLOPES, ONLY AMENDED PLANTING HOLES NEED MEET THIS REQUIREMENT.
- B) SOIL AMENDMENTS SHALL BE INCORPORATED ACCORDING TO RECOMMENDATIONS OF THE SOIL REPORT AND WHAT IS APPROPRIATE FOR THE PLANTS SELECTED.
- C) FOR LANDSCAPE INSTALLATIONS, COMPOST AT A RATE OF A MINIMUM OF FOUR CUBIC YARDS PER 1,000 SQUARE FEET OF PERMEABLE AREA SHALL BE INCORPORATED TO A DEPTH OF SIX INCHES INTO THE SOIL. SOILS WITH GREATER THAN 6% ORGANIC MATTER IN THE TOP 6 INCHES OF SOIL ARE EXEMPT FROM ADDING COMPOST AND TILLING.
- D) A MINIMUM THREE INCH (3") LAYER OF BARK MULCH SHALL BE APPLIED ON ALL EXPOSED SOIL SURFACES OF PLANTING AREAS EXCEPT IN TURF AREAS, CREEPING OR ROOTING GROUNDCOVERS, OR DIRECT SEEDING APPLICATIONS WHERE MULCH IS CONTRAINDICATED.

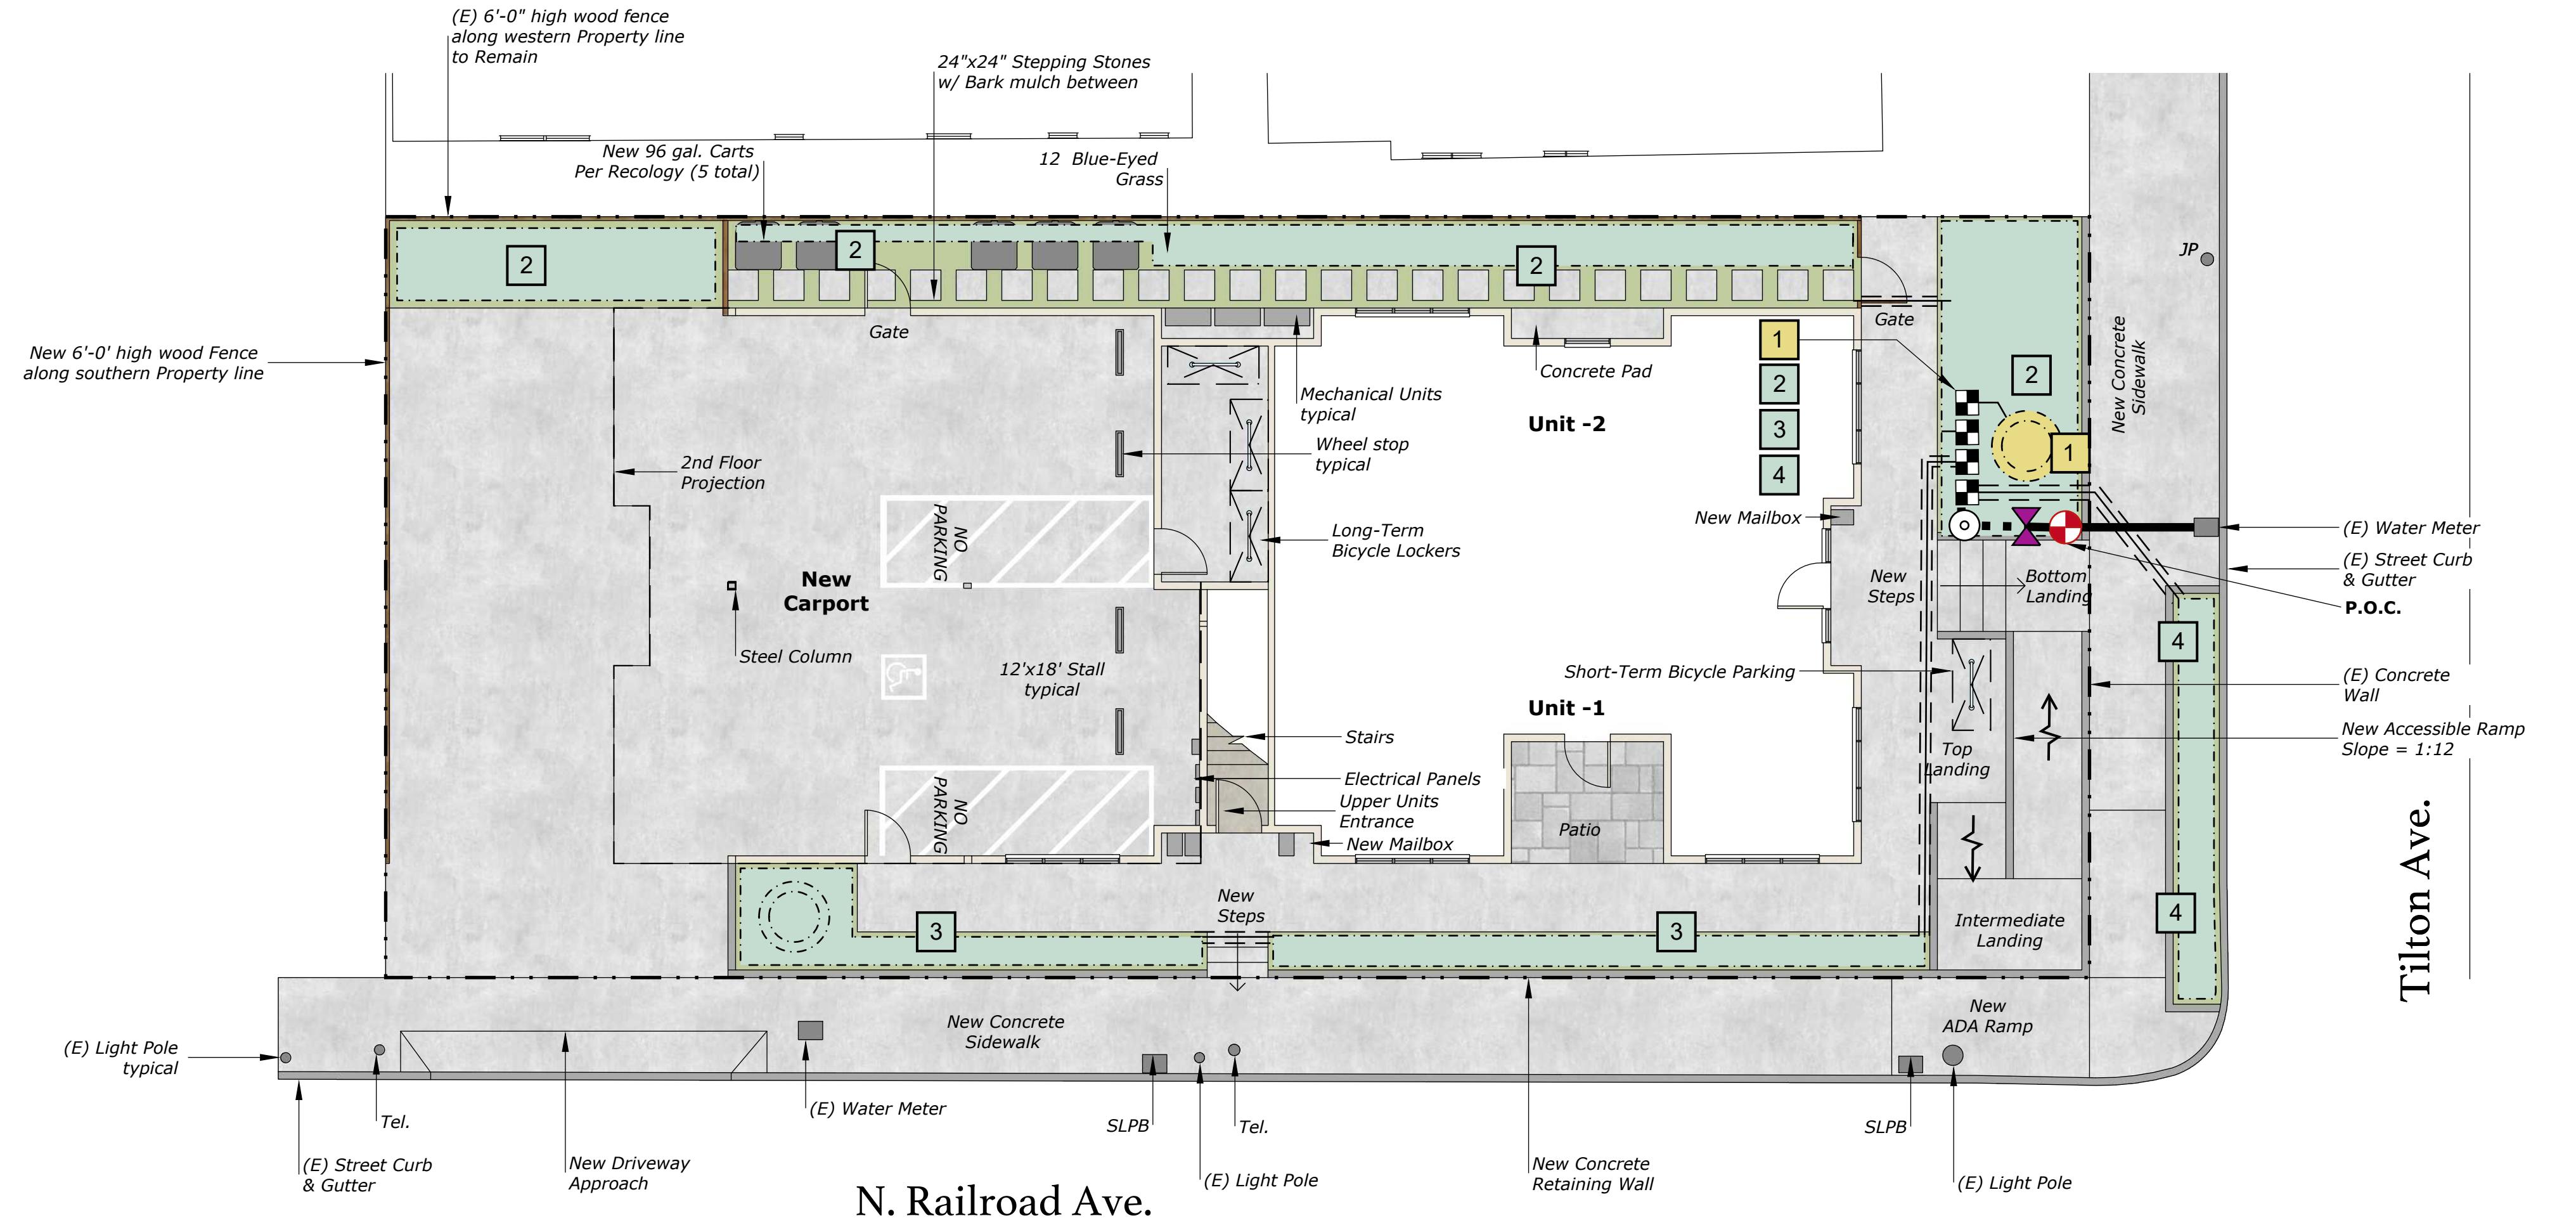

IRRIGATION KEY	
—	Irrigation Lateral Line: 1 in. PVC Class 200
— · —	Irrigation Mainline: 1 in. PVC Schedule 40
— — —	Pipe Sleeve: PVC Class 200 - Typical pipe sleeve for irrigation pipe. Pipe sleeve size shall allow for irrigation piping and their related couplings to easily slide through sleeving material. Extend sleeves 18 inches beyond edges of paving or construction.
■	Hunter ICZ-101-25-LF Drip Control Kit. 1" ICV Globe Valve with 1" HY100 filter system. Pressure Regulation: 25psi. Flow Range: 5-15 GPM. 150 mesh stainless steel screen.
○	Hunter HFS-150 Flow Sensor for use with ACC controller, 1" Schedule 40 Sensor Body, 24 VAC, 2 amp.
○	Hunter DripLine HDL-06-12-CV Hunter DripLine w/ 0.9 GPH emitters every 12 in. DripLine laterals spaced at 12" apart. Install with Hunter PLD barbed or PLD-LOC fittings. Tree Ring Irrigation DripLine w/ 0.9 drip emitters placed every 12 in. Inner ring 12" from plant. Outer ring 30" from plant. Place tie down every 4' in loam and 5' in clay.
C	Hunter ACC-1200 12 Station Outdoor Modular Controller. No Module Required. High-End Commercial Use. Metal Cabinet.
WS	Hunter SOIL-CLICK The Soil-Click probe uses proven technology to measure moisture within the root zone. When the probe senses that the soil has reached its desired moisture level, it will shut down irrigation, preventing water waste.
SS	Hunter Solar-Sync WSS-SEN Solar, rain freeze sensor with outdoor interface, connects to Hunter PCC, Pro-C, and I-Core Controllers, install as noted. Includes 10 year lithium battery and rubber module cover, and gutter mount bracket. Wireless.
■	Gate Valve - Insolation Shut off Valve

Color Indicates the Irrigated Area
Hydrozone Number (Valve)
100 SF Low Water Drip
Water Use (Low, Moderate or High)

Hydrozone - Valves

1	30 SF Med. Water Drip (Tree)	3	242 SF Low Water Drip
2	614 SF Low Water Drip	4	82 SF Low Water Drip (Bioretention)

Total Irrigated Landscape Area
Represent 968 sf.

"I have complied with the criteria of the Water Conservation in Landscaping Ordinance and applied them accordingly for the efficient use of water in the landscape & irrigation design plans."

Karen Aitken

Refer to L-3 for Irrigation Details & Water Calculations



SCALE 1/8" = 1'-0"
0 8 16

* NOTES (E) = Existing




DATE 11-20-24

SCALE 1/8"=1'-0"

DRAWN AD


JOB TILTON UNITS

L-2

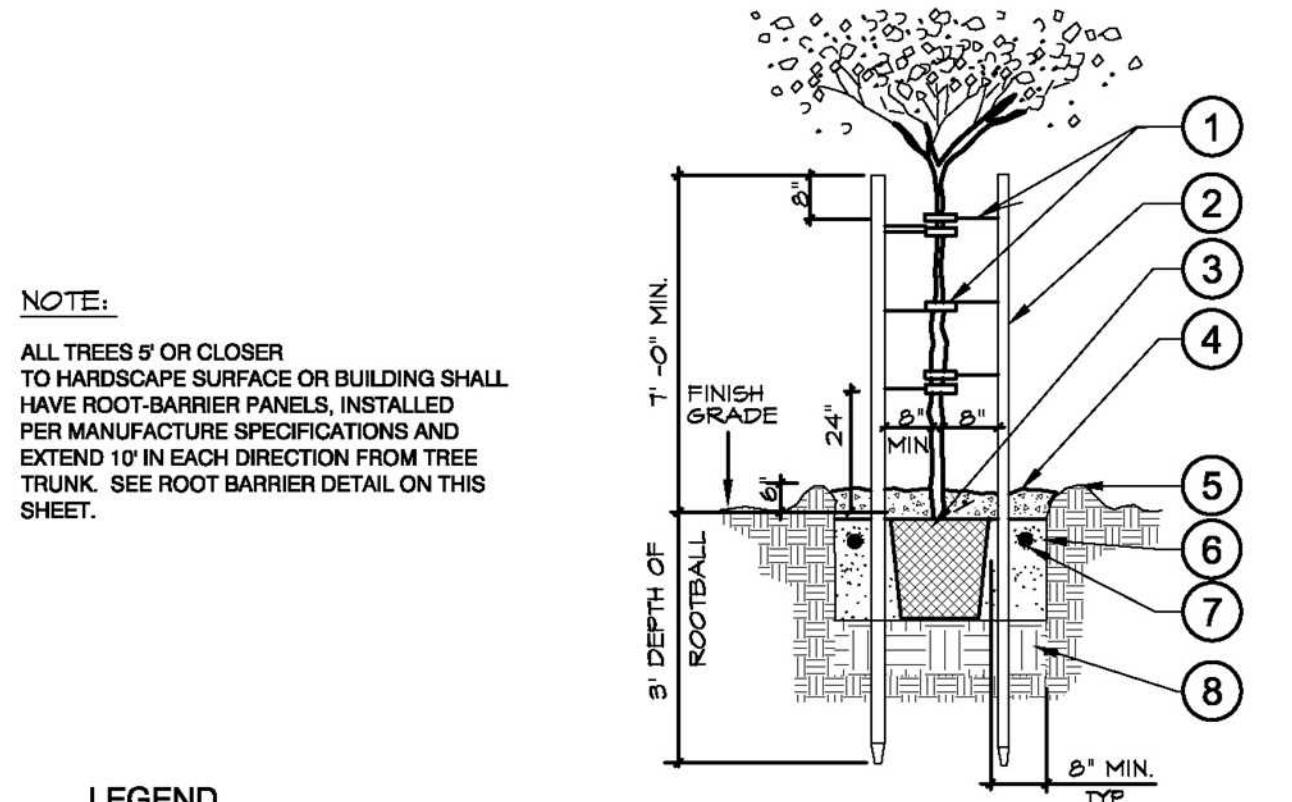


LEGEND

- ① CINCH-TIE TREE TIE - WRAP WIRE AROUND OUTSIDE OF STAKE. SECURE TO STAKE PER MANUFACTURE'S RECOMMENDATIONS, PLACE BELOW BRANCHING YOKE OF TREE.
- ② LODGE POLE PINE STAKES: 3 POLES FOR 36" BOX IN TRIANGLE ARRANGEMENT
- ③ SET TOP OF FOOTBALL 2" ABOVE FINISH GRADE.
- ④ 2" SHREDDED BARK MULCH, (APPROX. 3' DIA. RING)
- ⑤ WATER BASIN (SHRUB AREAS ONLY)
- ⑥ BACKFILL MIX: 1/3 SITE SOIL 1/3 SAND, 1/3 GROW MULCH
- ⑦ PLANTING FERTILIZER TABLETS (SEE DETAIL/CHART ON THIS SHEET) APPLICATION RATES PER MANUFACTURER'S SPECIFICATIONS OR SOILS REPORT RECOMMENDATION
- ⑧ NATIVE SOIL SUBGRADE EXCAVATE TO CORRECT HEIGHT FOR PLANTING. SCARIFY BOTTOM TO ENSURE ADEQUATE DRAINAGE FOR HEALTHY GROWTH OF PLANT.

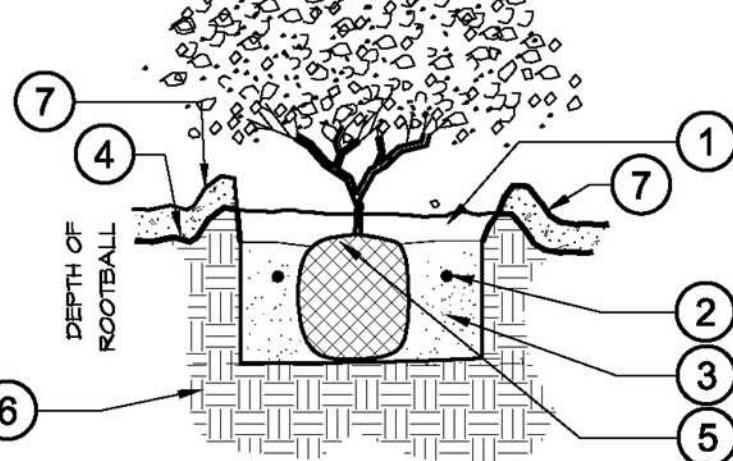TREE PLANTING WITH DOUBLE STAKE


LEGEND


- ① WATER BASIN WITH 2" X 2" SHREDDED BARK MULCH.
- ② TRI-C MYCO PAKS (SEE DETAIL "E" ON THIS SHEET). APPLICATION RATES PER MANUFACTURER SPECIFICATIONS.
- ③ BACKFILL MIX: 1/3 SITE SOIL, 1/3 SAND, 1/3 GROW MULCH.
- ④ FINISH GRADE
- ⑤ ROOTBALL 1"-2" ABOVE FINISH GRADE
- ⑥ NATIVE SOIL SUBGRADE EXCAVATE TO CORRECT HEIGHT FOR PLANTING. SCARIFY BOTTOM TO ENSURE ADEQUATE DRAINAGE FOR HEALTHY GROWTH OF PLANT.
- ⑦ 3" MULCH LAYER

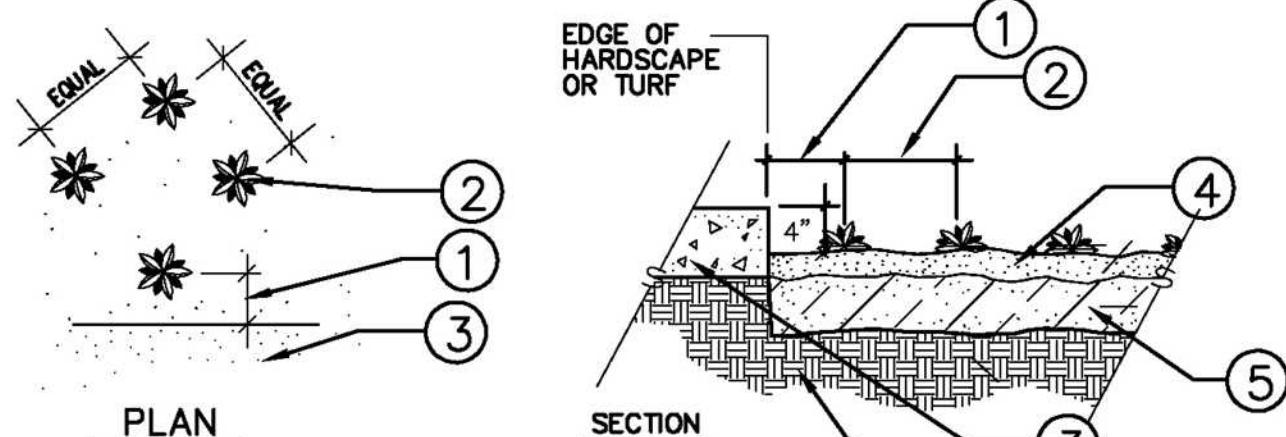TYPICAL SHRUB PLANTING


LEGEND

- 1. 1/2 TIMES O.C. SPACING
- 2. GROUNDCOVER PLANTS / SEE LEGEND FOR TYPE SIZE AND SPACING SPEC.
- 3. HARDCAPE OR TURF
- 4. 3" DEEP SHREDDED BARK MULCH LAYER
- 5. TILLED AND AMENDED PLANTING BED PER PLANTING NOTES.
- 6. UNDISTURBED NATIVE SOIL SUBGRADE

NOTE: ESTABLISH FINISH GRADE 2" BELOW FINISH SURFACE OF HARDCAPE/CURB. ROTOTILL AREAS BEING AMENDED TO A DEPTH OF 6". BLEND AMENDMENTS INTO NATIVE SOIL TO AVOID ANY DISTINCT SOIL HORIZON.


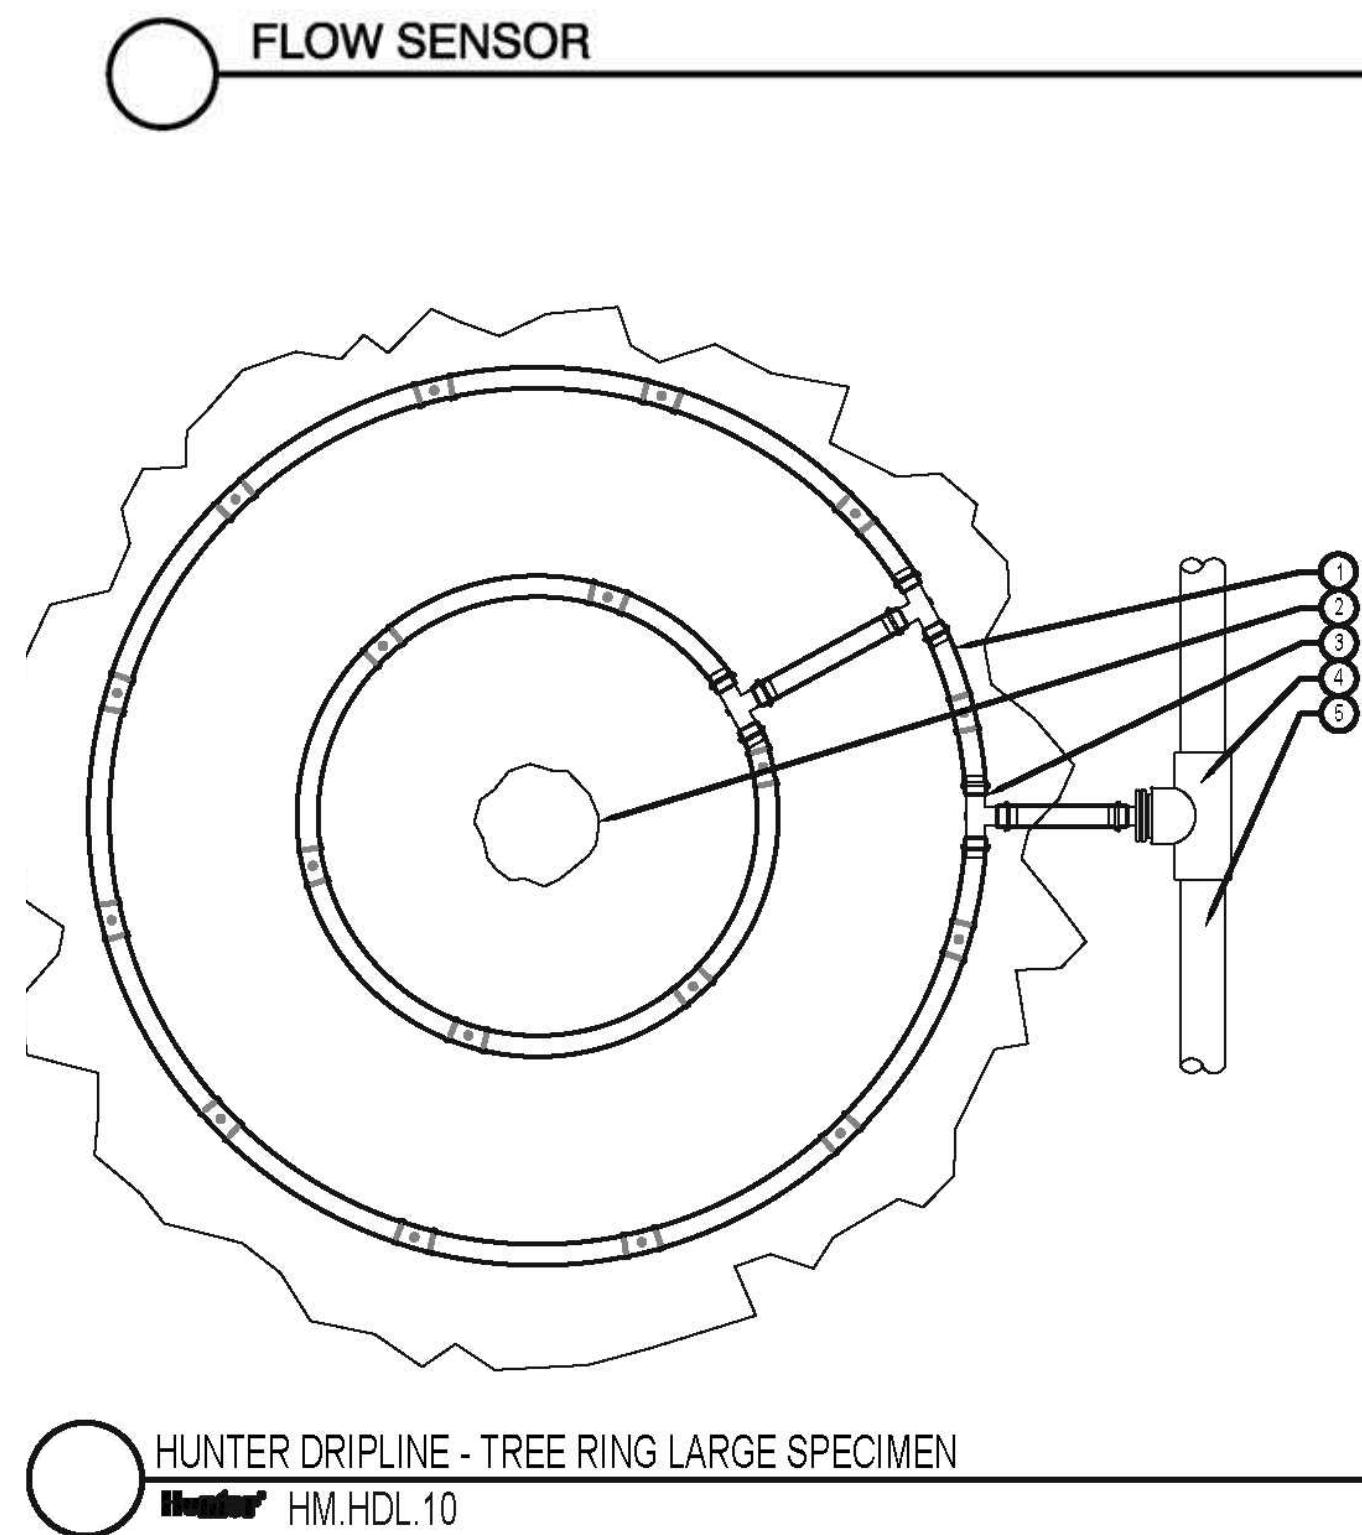
GROUNDCOVER PLANTING DETAIL


HUNTER DRIPLINE - TREE RING LARGE SPECIMEN

HM.HDL.10

NOT TO SCALE

These drawings are instruments of service, issued for a one-time single use by the owner. The entire contents of these drawings is copyright Karen Aitken & Associates. Landscape Architect retains all rights and title. No part may be reproduced in any fashion or medium without the express written approval of the landscape architect. The proper electronic transfer of data shall be the user's responsibility without liability to the landscape architect. Owner shall assume responsibility for compliance with all easements, setback requirements and property lines. Owner shall acquire all necessary permits required to perform work shown on plans. Base information has been provided by the owner. Karen Aitken & Associates assumes no liability for the accuracy of said property line boundaries, fence lines or property corners.

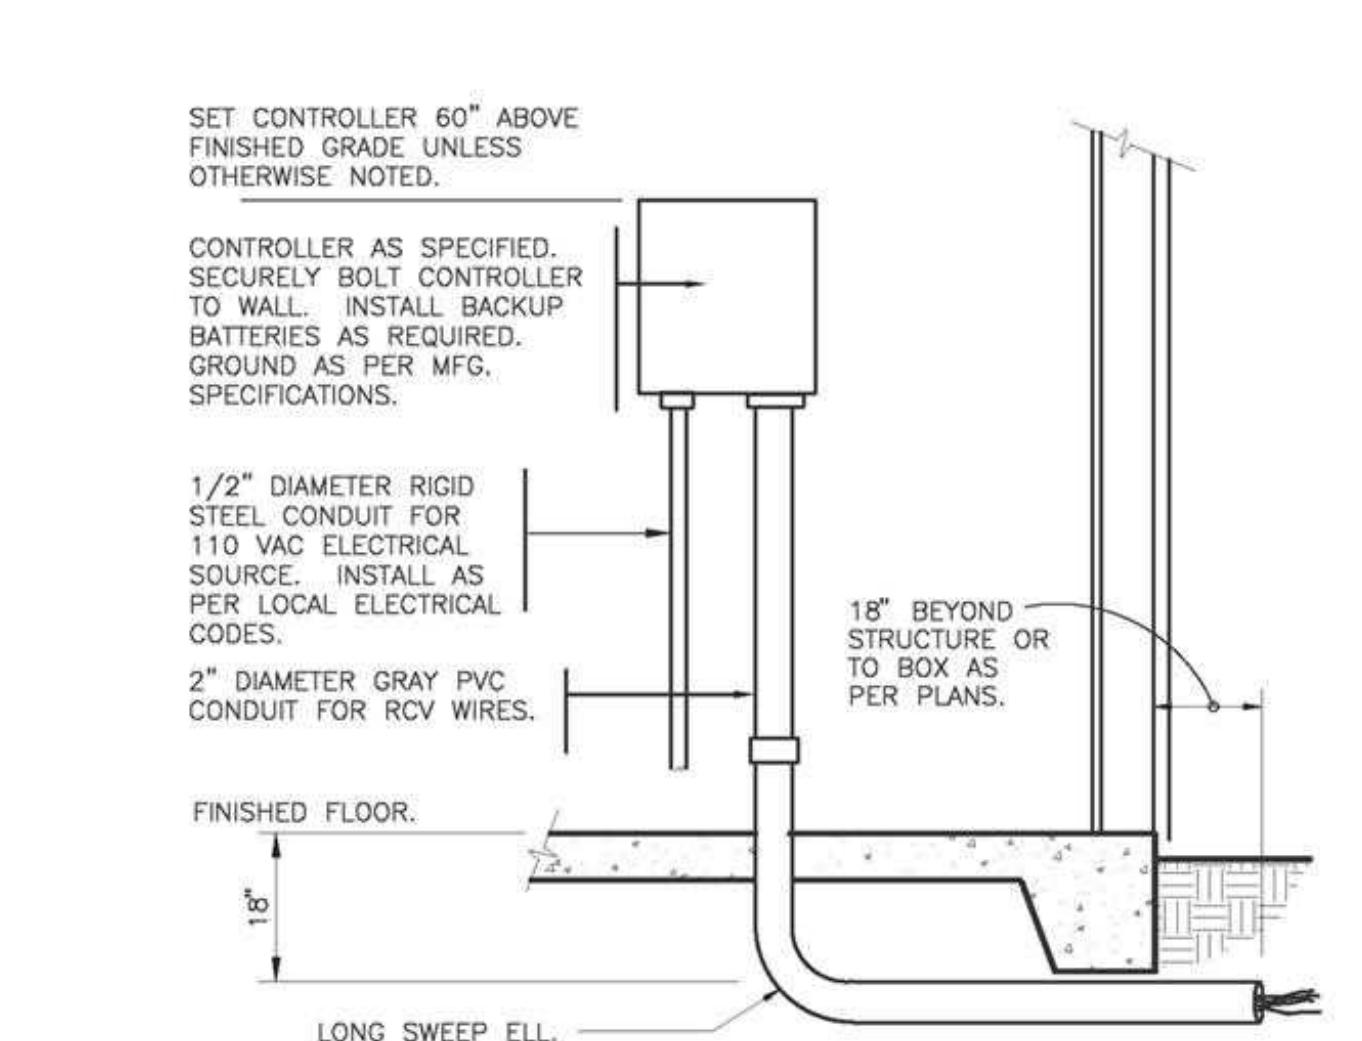
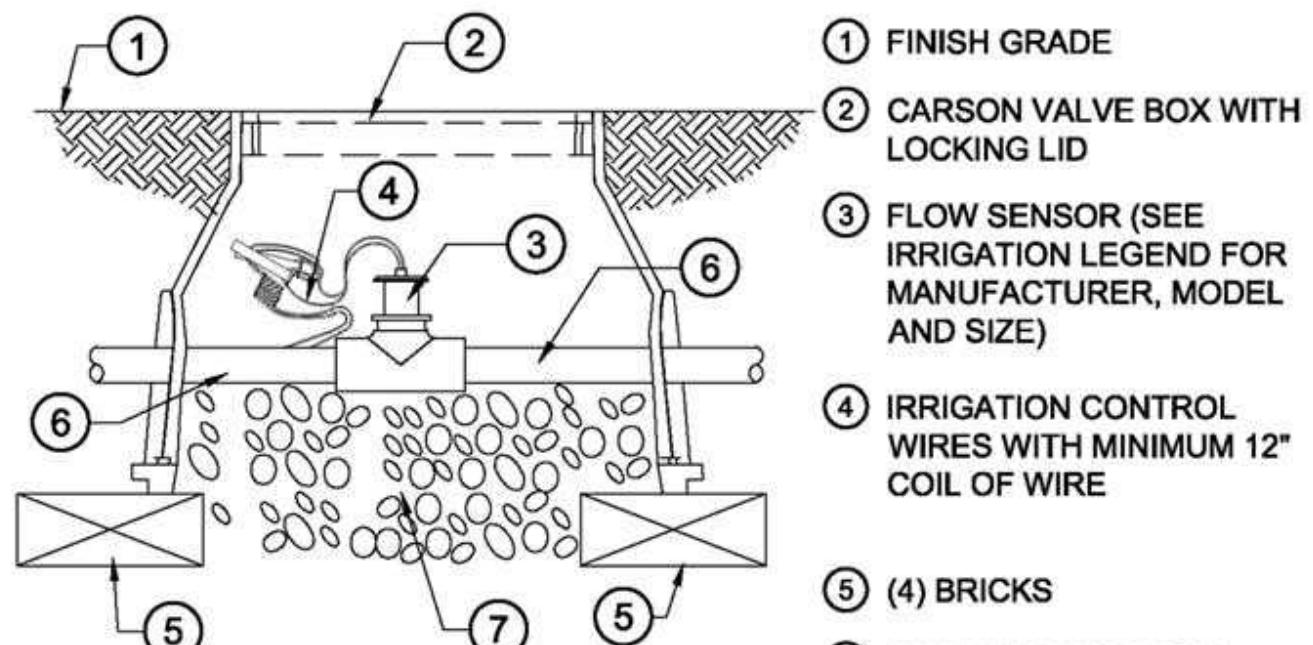

INTERIOR WALL MOUNT CONTROLLER


LEGEND

- ① FINISH GRADE
- ② CARSON VALVE BOX WITH LOCKING LID
- ③ FLOW SENSOR (SEE IRRIGATION LEGEND FOR MANUFACTURER, MODEL AND SIZE)
- ④ IRRIGATION CONTROL WIRES WITH MINIMUM 12" COIL OF WIRE
- ⑤ (4) BRICKS
- ⑥ MAINLINE PIPE FROM MASTER VALVE
- ⑦ 3" MINIMUM DEPTH OF 3/4" WASHED GRAVEL


NOTES:

- 1- FLOW SENSOR WIRE SHALL BE PER THE CONTROLLER MANUFACTURER'S SPECIFICATIONS.
- 2- INSTALL FLOW SENSOR PER MANUFACTURER'S SPECIFICATIONS AND RECOMMENDATIONS.
- 3- ALL WIRE RUNS SHALL BE CONTINUOUS WITHOUT ANY SPLICES. WIRE CONNECTIONS SHALL BE MADE USING DBR/Y-6 CONNECTORS OR APPROVED EQUAL.

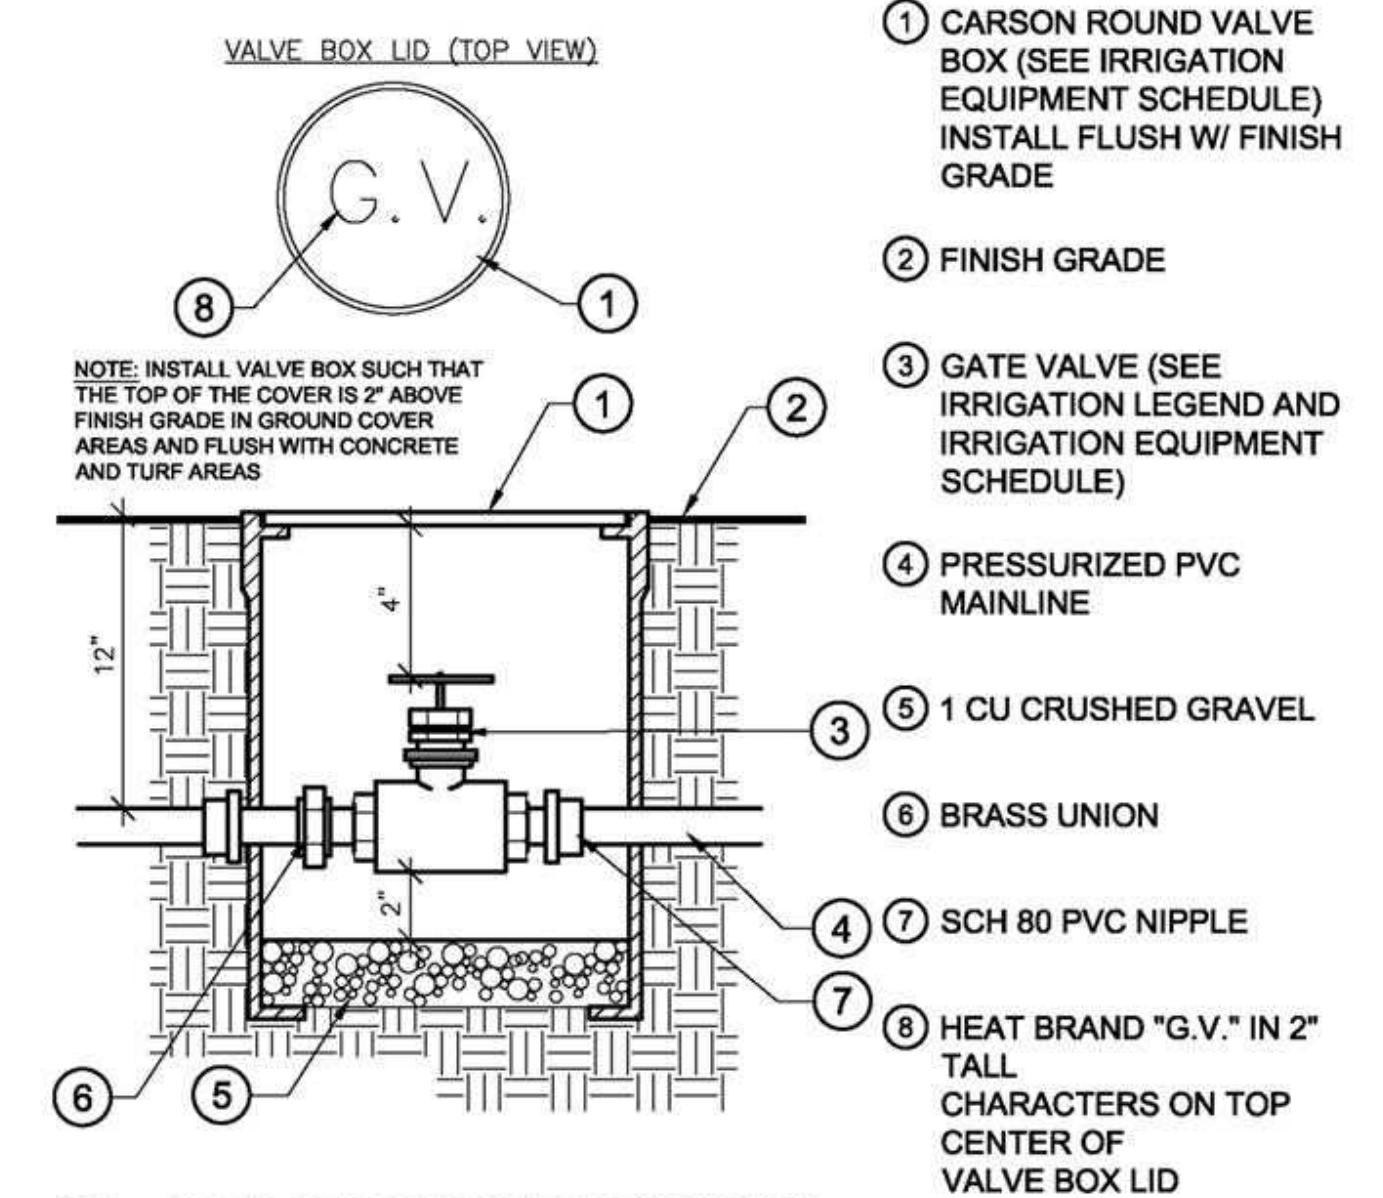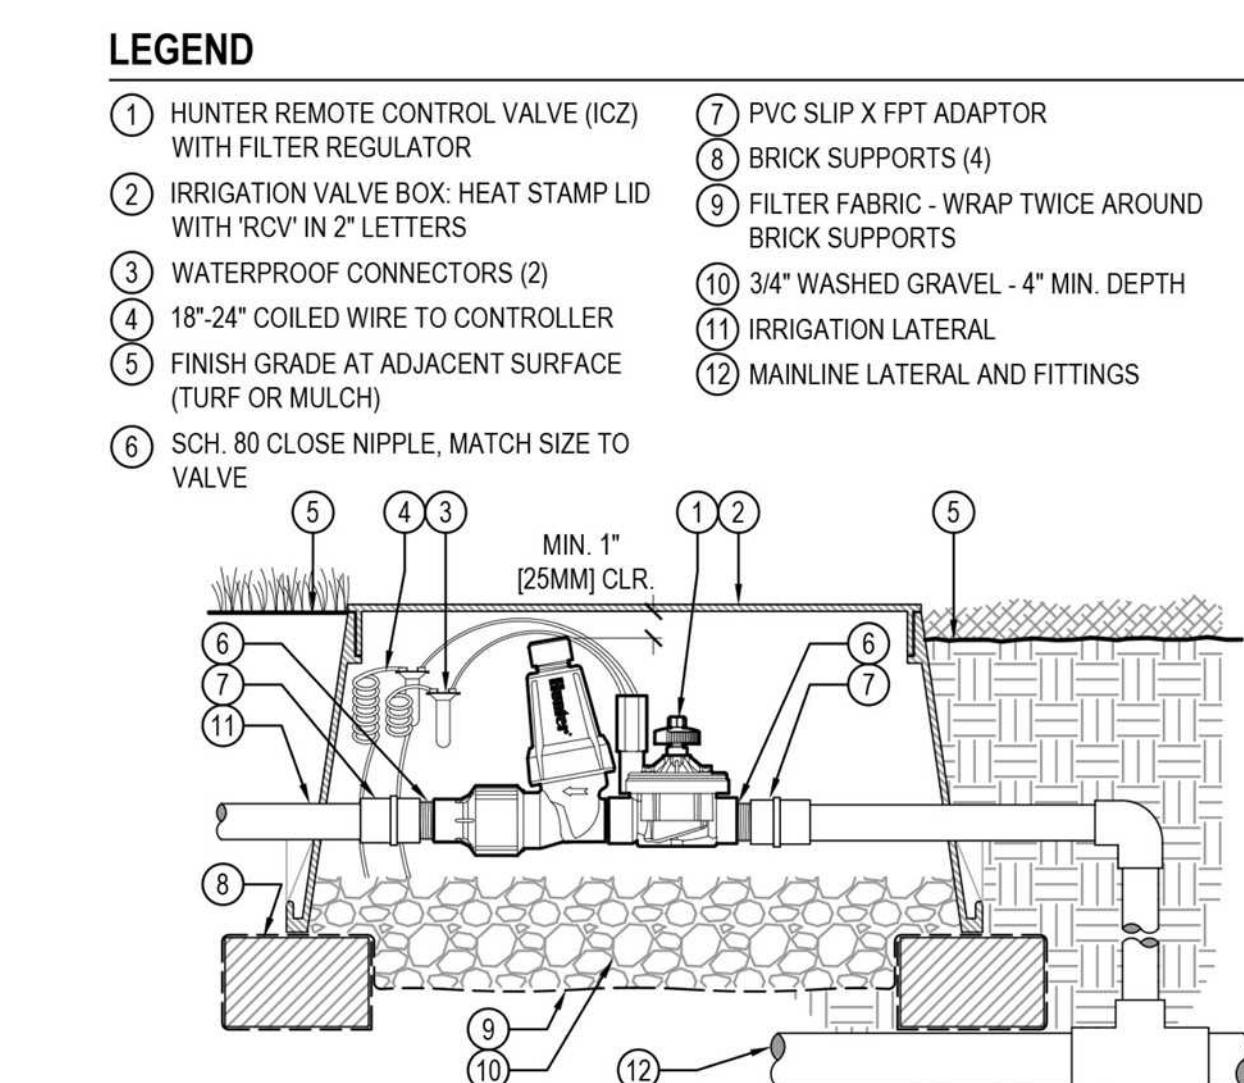
ISOLATION SHUT OFF VALVE

Drip Control Zone Kit (ICZ-101-LF)

Hunter V.ICZ.01

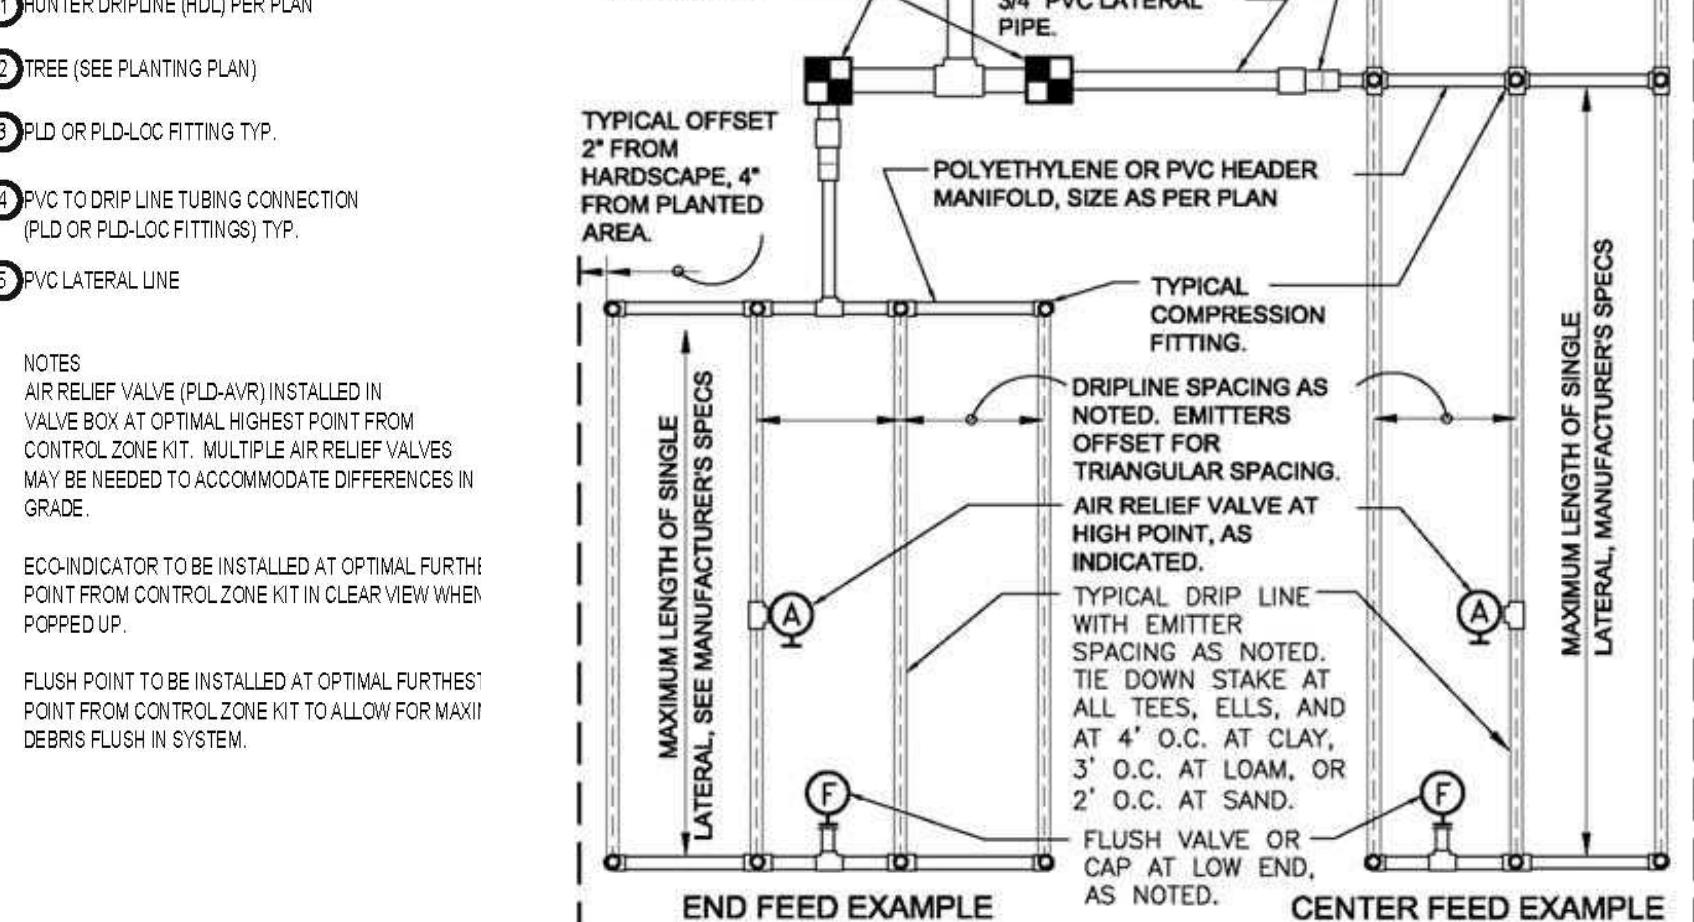NO SCALE


TYPICAL DRIPLINE LAYOUT
MAWA EPPT and ETWU Calculations

Project Name: Tilton Units

Project Location: 330 Tilton Ave. San Mateo, CA.

Total Landscape Area: 968.0 sq. ft.

Date: 10/17/23

MAWA CALCULATION

MAWA = $(Eto)(.62)(0.55 \times LA) + (1-ETAF \times SLA)$

MAWA = Maximum Applied Water Allowance (gallons per year)

Eto = Reference Evapotranspiration (inches per year)

.62 = Conversion Factor (to gallons)

.55 = ET Adjustment Factor (ETAF)

LA = Landscape Area including SLA (square feet)

0.45 = Additional Water Allowance for SLA

SLA = Special Landscape Area (square feet)

Eto =	42.7
Conversion	0.62
ETAF	0.55
LA =	968
SLA =	0

MAWA = $14,094.8 \text{ gallons per year}$
 $1,884.3 \text{ cubic feet per year}$

MAWA with EPPT

MAWA = $(Eto-Eppt)(.62)(0.55 \times LA) + (1-ETAF \times SLA)$

Eppt= 25% of Annual precipitation

Eto = Reference Evapotranspiration

PF = Plant Factor from WUCOLS (Region 2, Water Use: H 0.7 - 0.9, M 0.4 - 0.6, L 0.1 - 0.3, VL < 0.1, All Turf 0.8)

LA = Landscape Area (High, Medium, and Low water use areas)/square feet)

SLA = Special Landscape Area

.62 = Conversion Factor

IE = Irrigation Efficiency (drip spray and bubblers .81, sub surface .81, spray sprinklers .75

ET Adjustment Factor (ETAF), .55 for Residential and .45 for Non Residential

Reference Evapotranspiration (Eto) 42.7 San Mateo, Ca

REGULAR LANDSCAPE AREAS

Hydrozone #/ Plant Description	Irrigation Method	Plant Factor	Irrigation Efficiency (IE)	ETAF (PF/IE)	Landscape Area (sq. ft.)	ETAF x Area	ETWU
1) Med Water Use/ Tree	Drip	0.5	0.81	0.617283951	30.0	18.5	490.3
2) Low Water Use/ Shrubs	Drip	0.3	0.81	0.37037037	614.0	227.4	6,020.4
3) Low Water Use/ Shrubs	Drip	0.3	0.81	0.37037037	242.0	89.6	2,372.9
4) Low Water Use/ Grasses	Drip	0.3	0.81	0.37037037	82.0	30.4	804.0
							Total sf ft. Totals Totals
							968.0 365.9 365.9 9,687.5
							ETWU TOTAL 9,687.5
							MAWA 14,094.8

ETWU CALCULATION

ETWU = $(Eto)(.62)(PF/IE)LA$

ETWU = Estimated Total Water Use per Year (gallons)

Eto = Reference Evapotranspiration

PF = Plant Factor from WUCOLS (Region 2, Water Use: H 0.7 - 0.9, M 0.4 - 0.6, L 0.1 - 0.3, VL < 0.1, All Turf 0.8)

LA = Landscape Area (High, Medium, and Low water use areas)/square feet)

SLA = Special Landscape Area

.62 = Conversion Factor

IE = Irrigation Efficiency (drip spray and bubblers .81, sub surface .81, spray sprinklers .75




ET Adjustment Factor (ETAF), .55 for Residential and .45 for Non Residential

Reference Evapotranspiration (Eto) 42.7 San Mateo, Ca

ETAF CALCULATIONS
Regular Landscape Areas

Total ETAF x Area	365.9
Total Area	968.0
Average ETAF	0.38

Average ETAF for Regular Landscape Areas must be .55 or below for residential areas, and .45 or below for non residential areas.

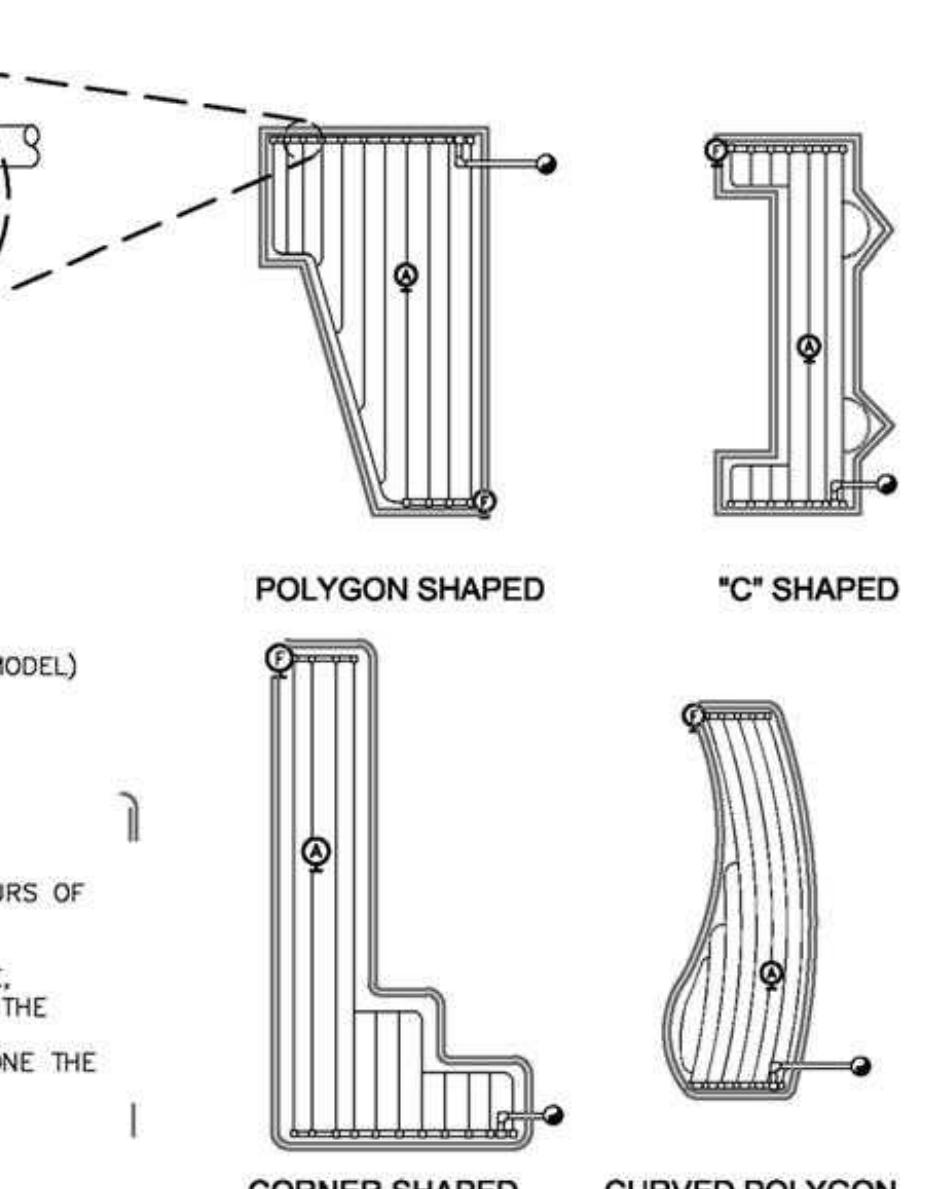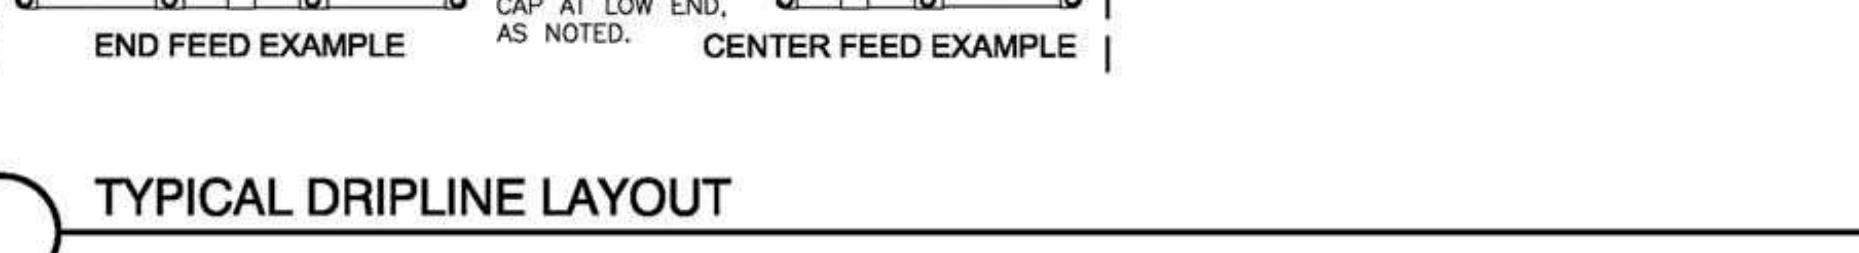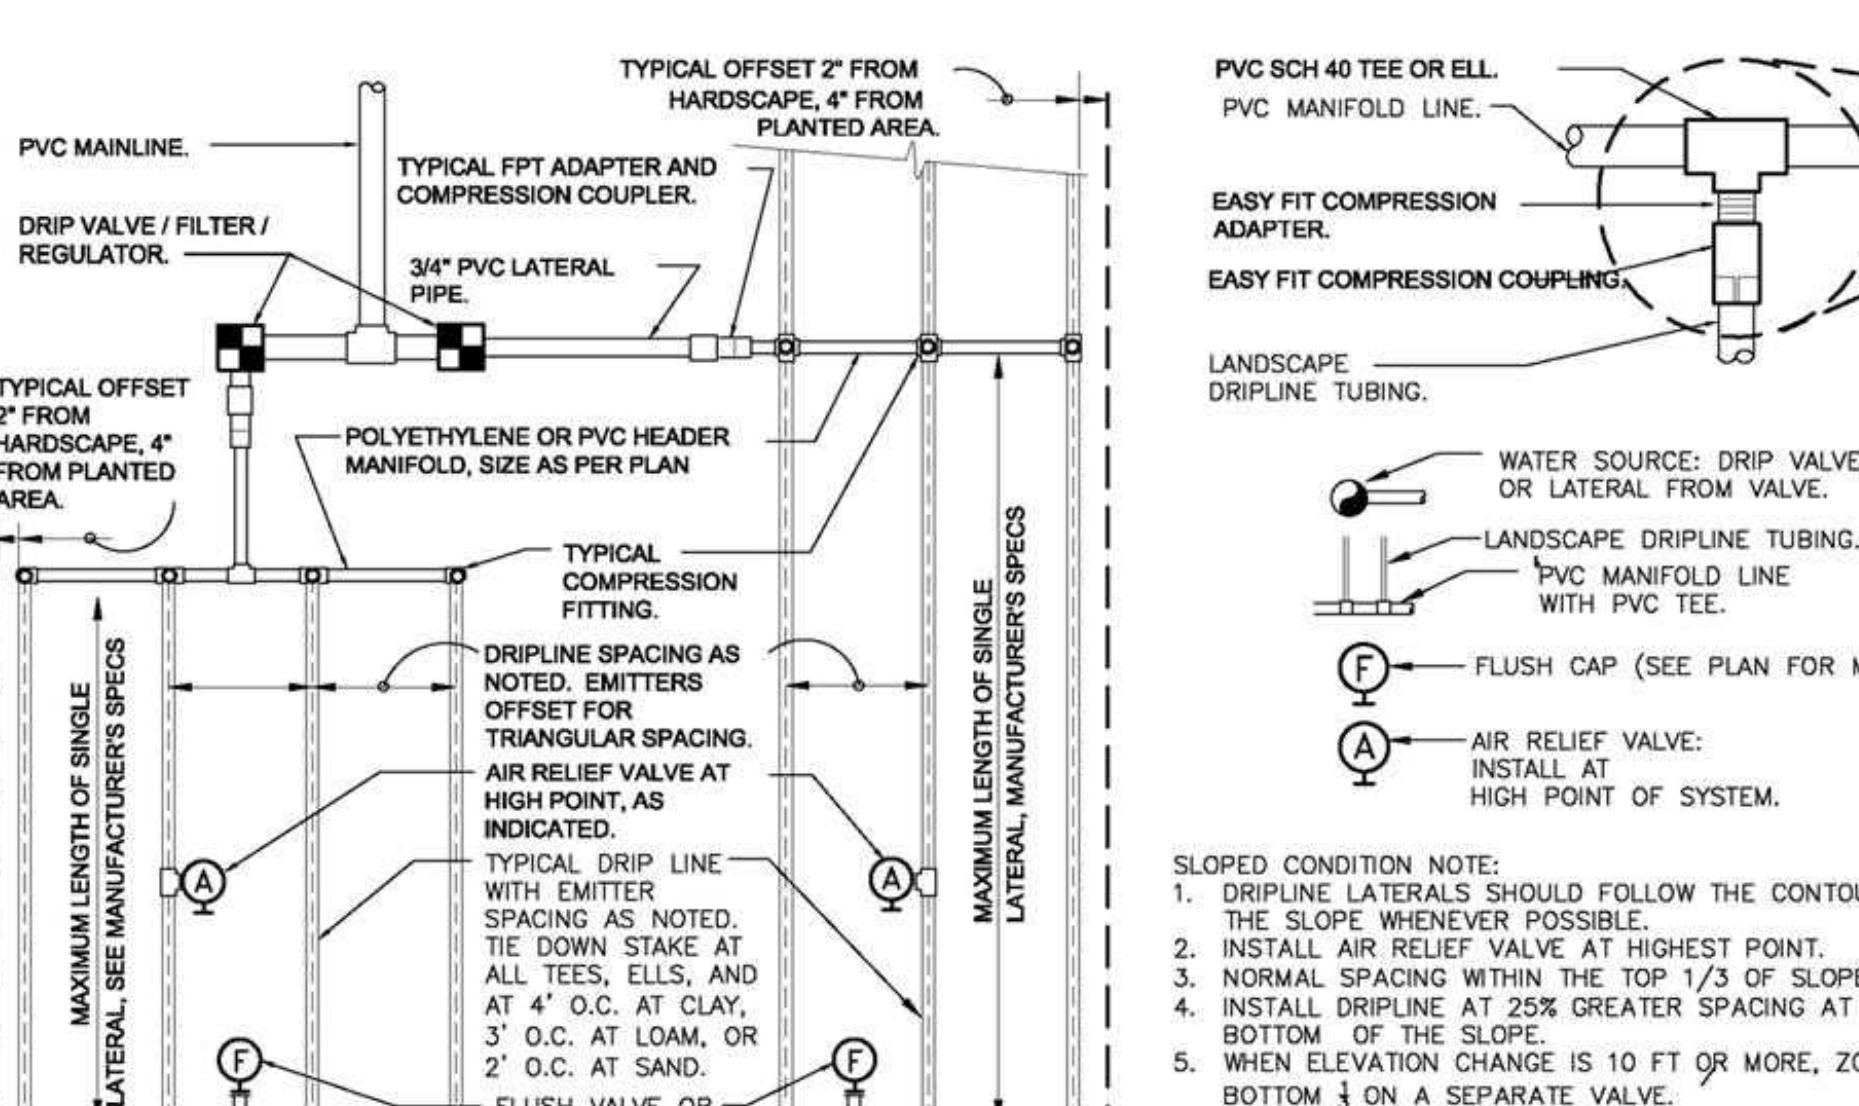

CORNER SHAPED


CURVED POLYGON

Karen Aitken & Associates

EASEMENT NOTE:

(1) EASEMENT DOCUMENT (DOC# 2013-165785) WAS REVIEWED BY THE SURVEYOR.
THE LOCATION OF THIS EASEMENT CANNOT BE PLOTTED ON THE TOPOGRAPHIC SURVEY
MAP DUE TO THE ABSENCE OF A SPECIFIC LEGAL DESCRIPTION OR DELINEATION OF THE
EASEMENT'S LOCATION.

(2) THE GRANTEE OF THIS EASEMENT IS SPRINT COMMUNICATIONS COMPANY. FOR
FURTHER DETAILS OR CONCERN REGARDING THIS EASEMENT, IT IS RECOMMENDED TO
CONTACT THE GRANTEE DIRECTLY.

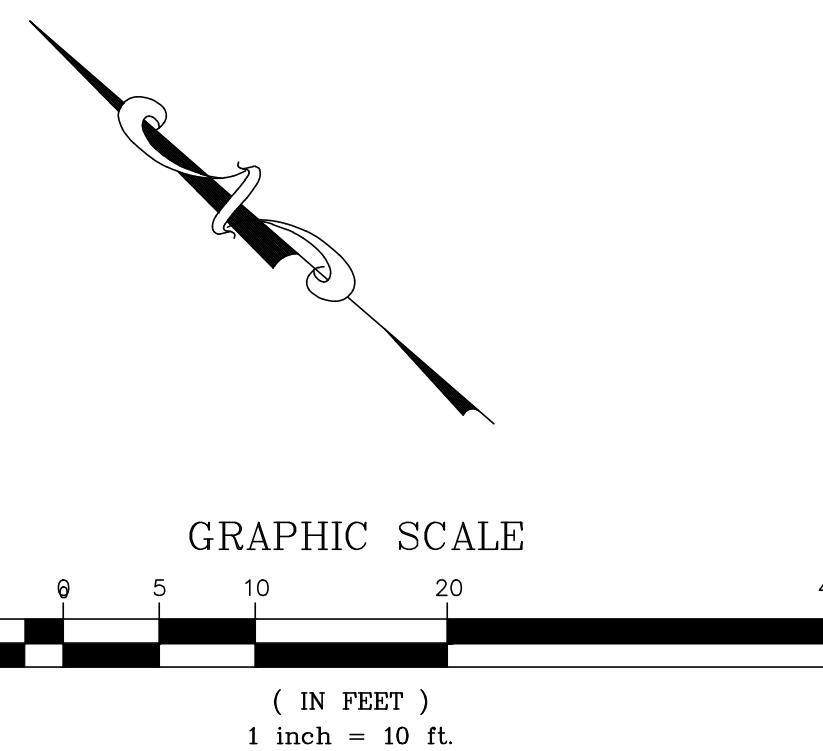

RAILROAD AVENUE

(20' WIDE)

TILTON AVENUE

(50' WIDE)

ANDRIKA PRASAD AND
MOHANKUMARI SHARM
FAMILY TRUST
DOC#: 2013-056940
APN: 032-323-010
(5,600 SQ. FT.)

APN: 032-323-020

APN: 032-323-280

ABBREVIATIONS AND LEGEND

BSBL	BUILDING SETBACK LINE	SM	SANITARY SEWER MANHOLE
CB	CATCH BASIN	SH	STORM DRAIN MANHOLE
CONC	CONCRETE	HY	FIRE HYDRANT
EM	EM	SS	SANITARY SEWER LINE
ELEC	ELECTRIC METER	WL	WATER LINE
FT	FT	OH	OVERHEAD ELECTRICAL LINE
GM	GM	G	GAS LINE
GV	GV	SD	STORM DRAIN LINE
HCR	HCR		
JP	JP		
LP	LP		
PUE	PUBLIC UTILITY EASEMENT		
SSCO	SANITARY SEWER CLEAN OUT		
SLPB	STREETLIGHT PULL BOX		
TC	TOP OF CURB		
TEL	TEL		
UNKN T	UNKNOWN TREE		
WM	WM		
—	BOUNDARY LINE		
—	EXISTING FENCE LINE		
—	FOUND STANDARD CITY MONUMENT		
()	INDICATES REFERENCE MAP NUMBER		

REFERENCE INFORMATION

(1) 21 LLS 83 (2) 14 MAPS 77

NOTE:

- ALL DISTANCES AND DIMENSIONS SHOWN ARE IN FEET AND DECIMALS THEREOF UNLESS OTHERWISE NOTED.
- BUILDING OUTLINE WAS MEASURED AT BUILDING EXTERIOR FINISH WALL SURFACE UNLESS OTHERWISE NOTED.
- ELEVATION DATUM: NAVD 88. ELEVATIONS WERE ESTABLISHED WITH GNSS OBSERVATIONS.
- A PRELIMINARY REPORT WAS NOT PROVIDED FOR CHECKING EASEMENT OF RECORDS. OTHER EASEMENTS MAY EXIST THAT ARE NOT SHOWN ON THIS MAP.

UTILITY NOTE

- THE SURFACE UTILITIES SHOWN ON THIS DRAWING HAVE BEEN LOCATED BY FIELD SURVEY. THE UNDERGROUND UTILITIES SHOWN HAVE BEEN COMPILED FROM RECORDS OF THE VARIOUS AGENCIES. THE SURVEYOR ASSUMES NO RESPONSIBILITY FOR THEIR INDICATED LOCATION, SIZE, OR TYPE. RECORD UTILITY INFORMATION SHOULD BE CONFIRMED BY EXPOSING THE UTILITY.
- SANITARY SEWER CLEAN OUT WAS SEARCHED NOT FOUND ON SITE. SANITARY SEWER LATERAL LOCATION IS NOT DETERMINED AND TO BE VERIFIED IN FIELD.


TOPOGRAPHIC SURVEY


LANDS OF ANDRIKA PRASAD AND
MOHANKUMARI SHARM FAMILY TRUST
DOC#: 2013-056940
APN 032-323-010

(330 TILTON AVENUE)

CITY OF SAN MATEO SAN MATEO COUNTY CALIFORNIA
SCALE: 1"=10' MAY, 2023

Zhen Wang

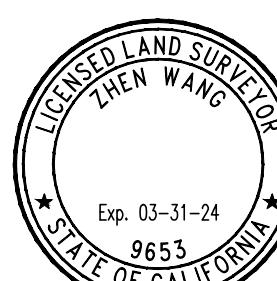

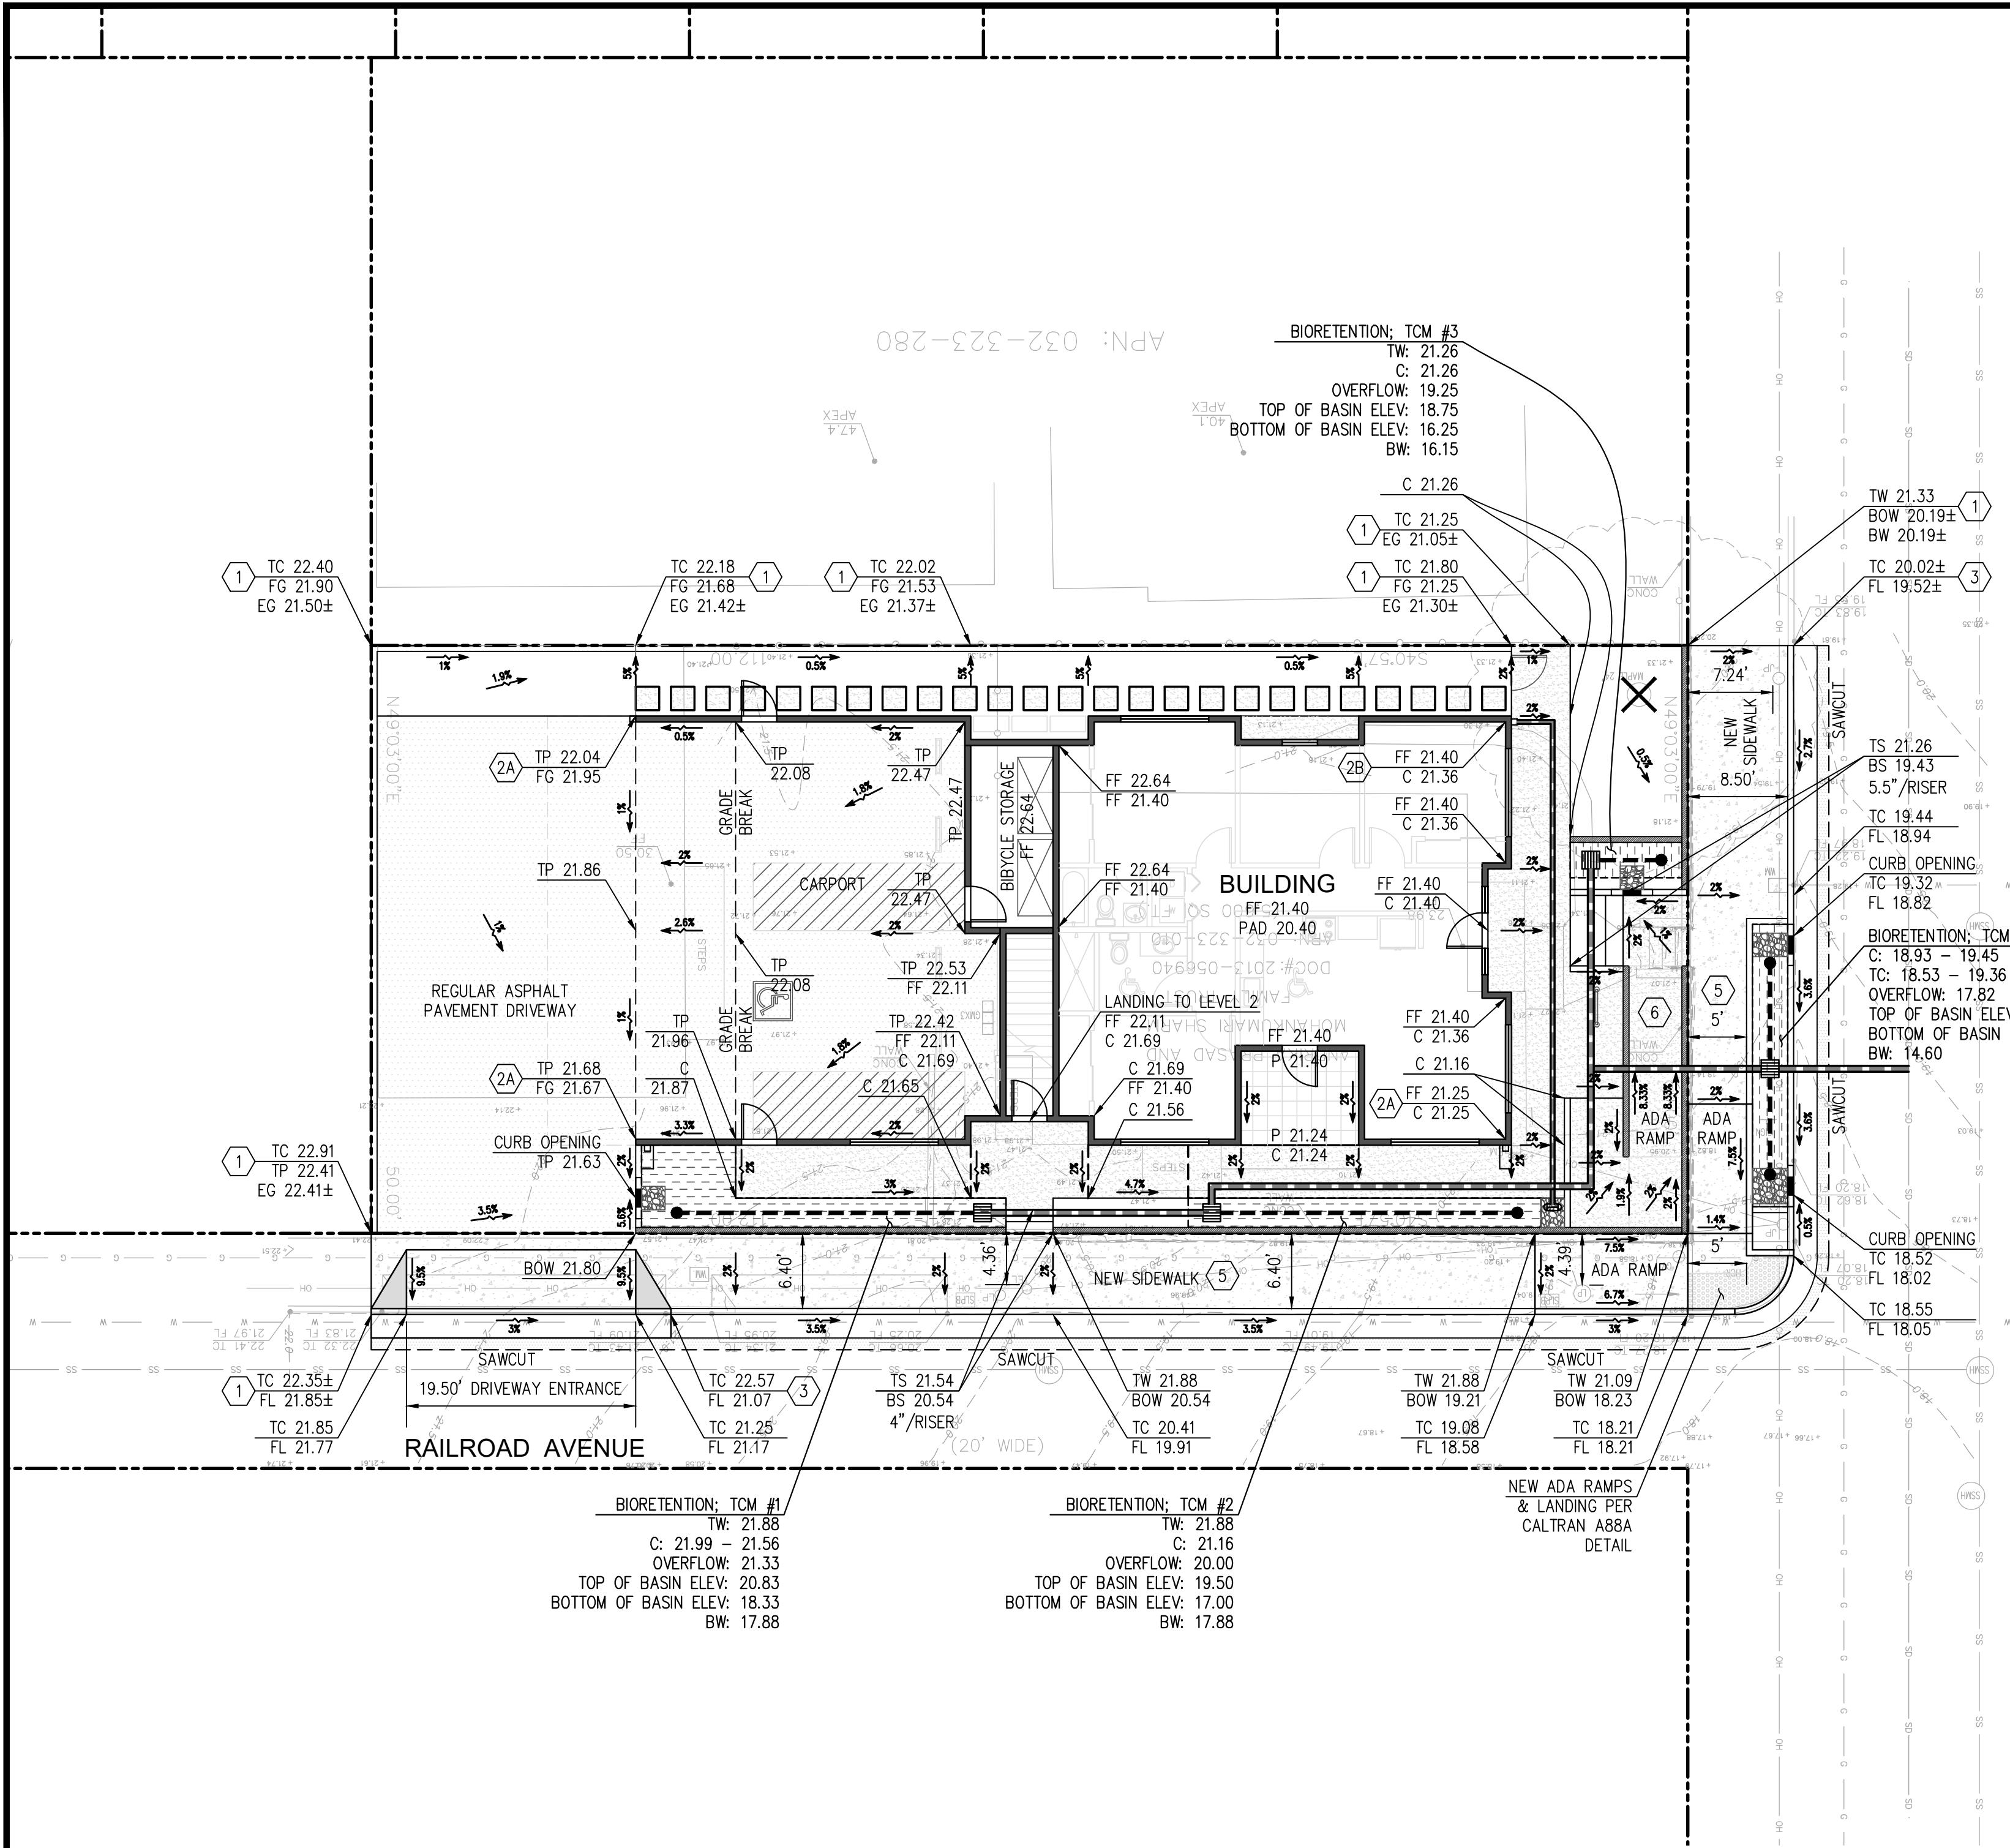

LEGEND

PROPERTY LINE	REGULAR DUTY ASPHALT PAVEMENT
EX. SPOT ELEVATION	
FLOW DIRECTION	PATIO/PORCH PER ARCH. PLANS
GRADE BREAK	CONCRETE Hardscape PER ARCH. PLANS
FLOW LINE	PUBLIC CONCRETE SIDEWALK
STORM DRAIN PIPE	TRUNCATED DOMES
DOWNSPOUT WITH SPLASH BLOCK	ENERGY DISSIPATOR
4" PERFORATED PIPE	BIORETENTION
STORM DRAIN CLEANOUT	
18" WIDE CURB OPENING	EX TREE TO BE REMOVED
STORM DRAIN INLET	

ABBREVIATIONS:

BC = BOTTOM OF CURB	FC = FINISHED GRADE
BOW = BACK OF SIDEWALK	FL = FLOWLINE
BW = BOTTOM OF WALL	FOW = FRONT OF WALK
C = CONCRETE	G = GARAGE
EG = EXISTING GRADE/GROUND	GB = GRADE BREAK
EX = EXISTING	IE = INVERT ELEVATION
FF = FINISHED FLOOR	LG = LINEAL FEET
	P = PORCH/PATIO
	S = SLOPE
	SD = STORM DRAIN
	TC = TOP OF CURB
	TG = TOP OF GRADE
	TP = TOP OF PAVEMENT
	TYP = TYPICAL

GRADING NOTES

- 1 MATCH EXISTING ELEVATION
- 2A DOWNSPOUT WITH CONCRETE SPLASH PAD PER DETAIL 1A
- 2B RAINWATER LEADER PER DETAIL 1D
- 3 BEGIN/END CURB & GUTTER PER CITY OF SAN MATEO STANDARD DETAIL
- 4 BEGIN/END SIDEWALK PER CITY OF SAN MATEO STANDARD DETAIL
- 5 REMOVE EXISTING DRIVEWAY ENTRANCE AND REPLACE WITH NEW SIDEWALK PER CITY OF SAN MATEO STANDARD DETAIL
- 6 ADA ACCESSIBLE RAMP WITH HANDRAIL TO UNIT #1. MAX SLOPE NOT TO EXCEED 8.33%. SEE ARCH PLANS FOR RAMP DETAIL


EARTHWORK VOLUME:

(INCLUDES BUILDING PAD)

EARTHWORK QUANTITIES:	VOLUME (CUBIC YARD)
FILL	30
COMPACITION RATE: 15%	$30 \times 0.15 = 4.5$
TOTAL FILL	35 (ROUND UP)
CUT	120 *
TOTAL EARTHWORK	85 (EXPORT)

CONTRACTOR SHALL ESTIMATE THEIR EARTHWORK QUANTITIES WHEN BIDDING ON THIS PROJECT

* INCLUDES BIORETENTION EXCAVATION

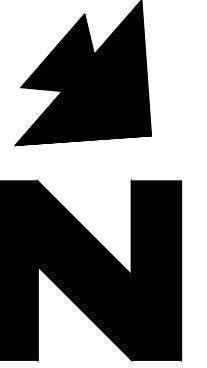

(IN FEET)
1 inch = 10 ft

SITE DESIGN MEASURES:
1. DIRECT RUNOFF FROM ROOFS, SIDEWALKS, PATIOS TO LANDSCAPED AREAS.


SOURCE CONTROL MEASURES:
1. BENEFICIAL LANDSCAPING.

PRE & POST DEVELOPMENT PERVIOUS/IMPERVIOUS AREAS:		
AREA TYPE	EXISTING (SF)	PROPOSED (SF)
ONSITE LOT AREA	5,600	5,600
OFFSITE IMPROVEMENT AREA	1,813	1,813
TOTAL LAND DISTURBANCE	7,413	

ON-SITE		
MAIN BUILDING (ROOF)	1,263	3,234
DETACHED GARAGE	1,002	N/A
PATIO/HARDSCAPE	323	844
DRIVEWAY	906	671
TOTAL IMPERVIOUS AREA	3,494	4,749
NET IMPERVIOUS AREA INCREASE:	1,255	

PERVIOUS PAVERS		
PERVIOUS AREA	2,106	851
TOTAL PERVIOUS AREA	2,106	851

OFF-SITE		
SIDEWALK AND CURB & GUTTER	1,813	1,732
PERVIOUS AREA	0	81



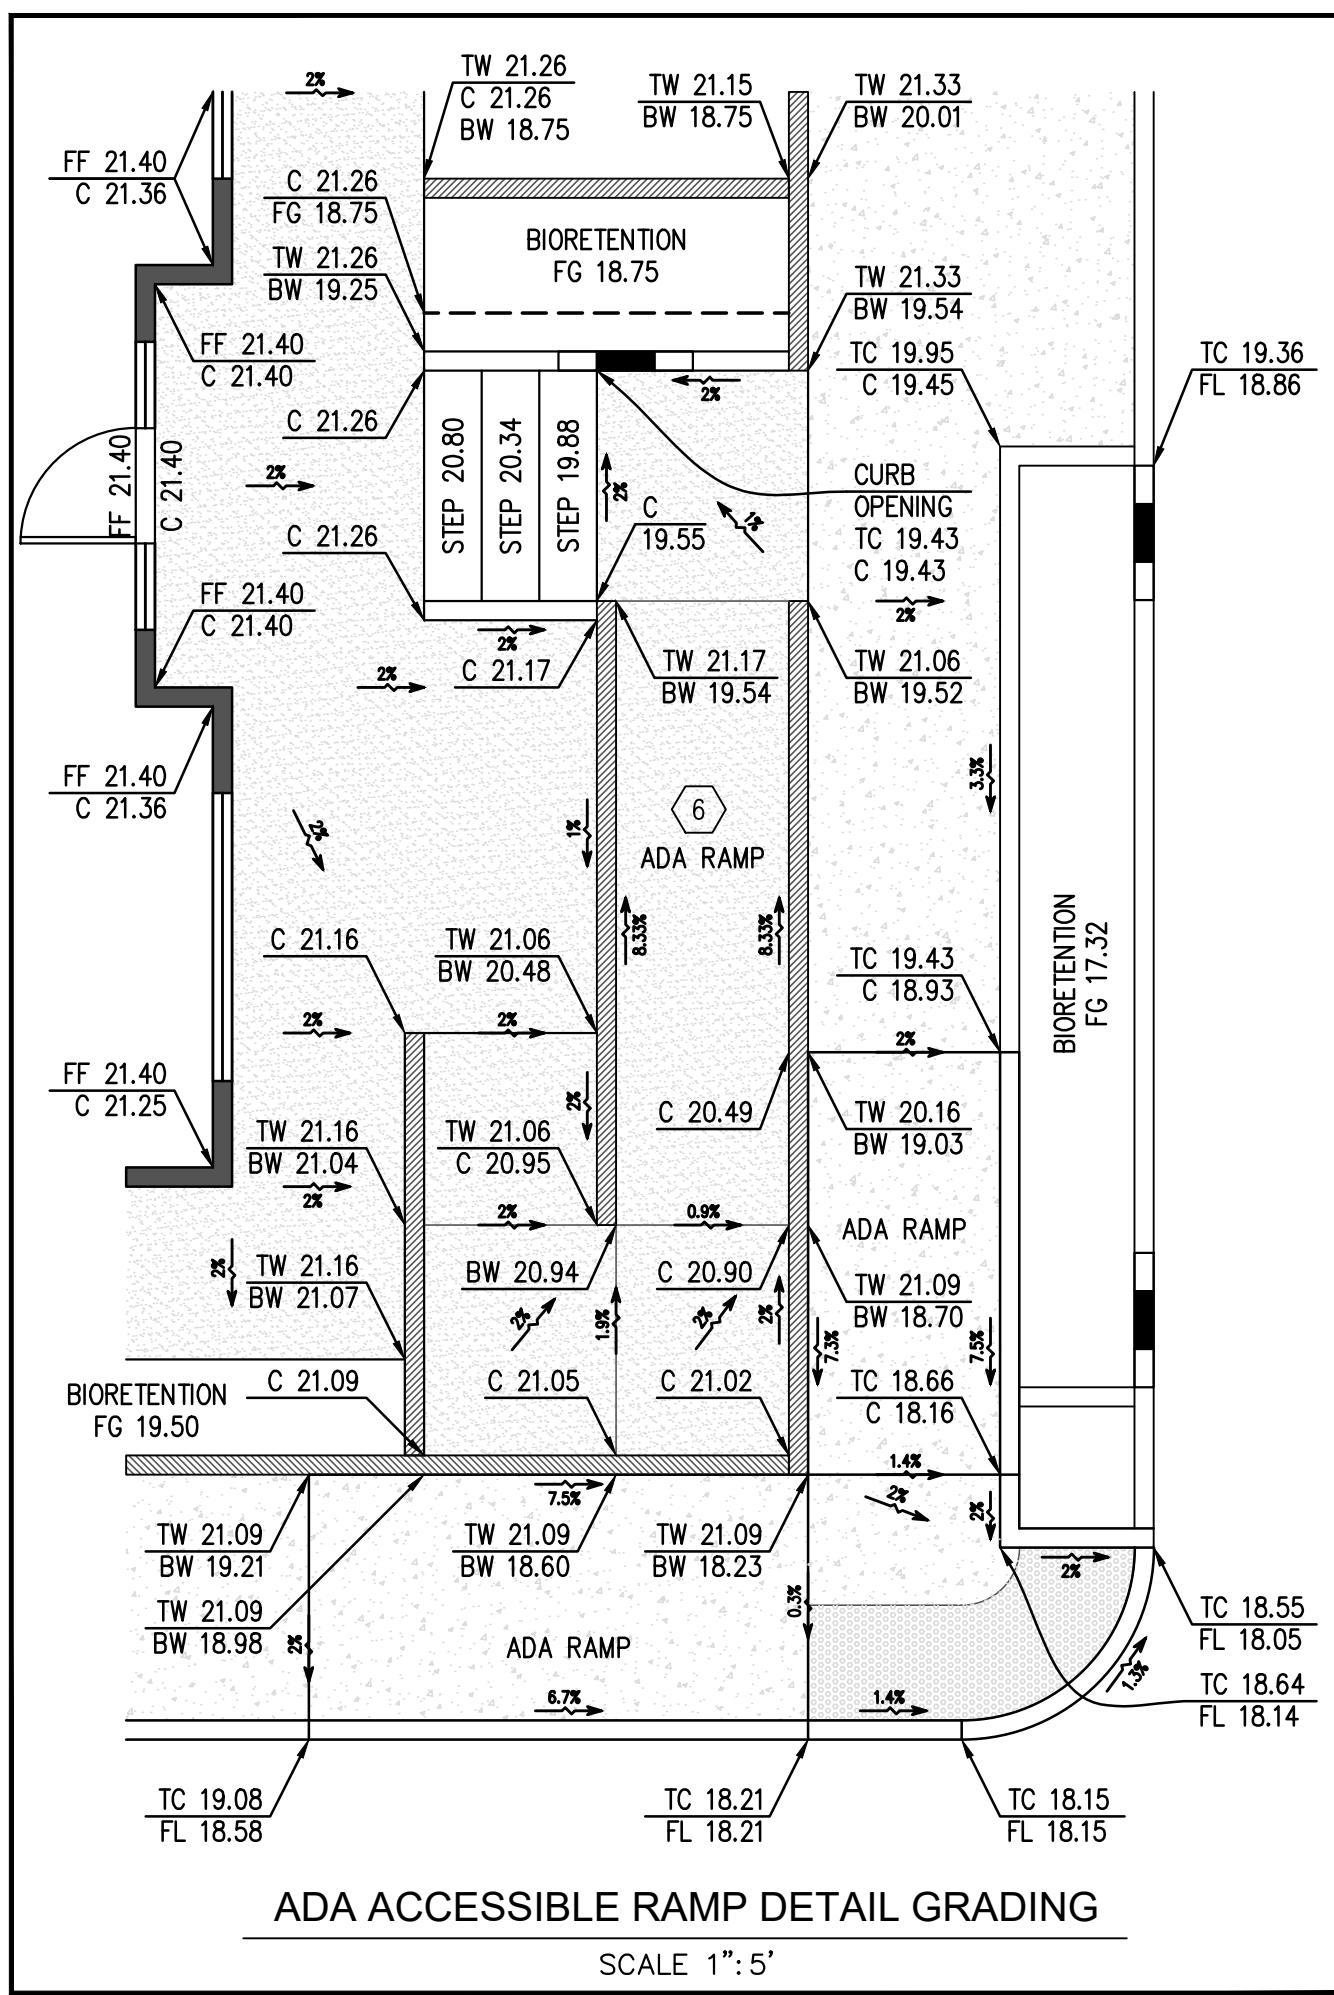


PRELIMINARY GRADING AND DRAINAGE PLAN ANDRIKA PRASAD RESIDENCE 328 TILTON AVENUE SAN MATEO, CA 94401

GREEN CIVIL ENGINEERING, INC
INFO@GREEN-CE.COM
1900 S. NORFOLK ST. SUITE #300
SAN MATEO, CA 94403

REGISTERED PROFESSIONAL CIVIL ENGINEER
NO. 735881
CIVIL STATE OF CALIFORNIA
EXPIRED 12/31/2024
SHEET C1
DATE: 3/21/24
DESIGNED: HCL
DRAWN: BL
REVIEWED: HCL
JOB NO.: 20230022

1 OF 4 SHEETS

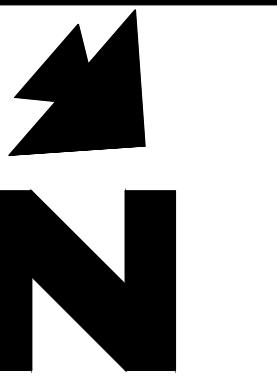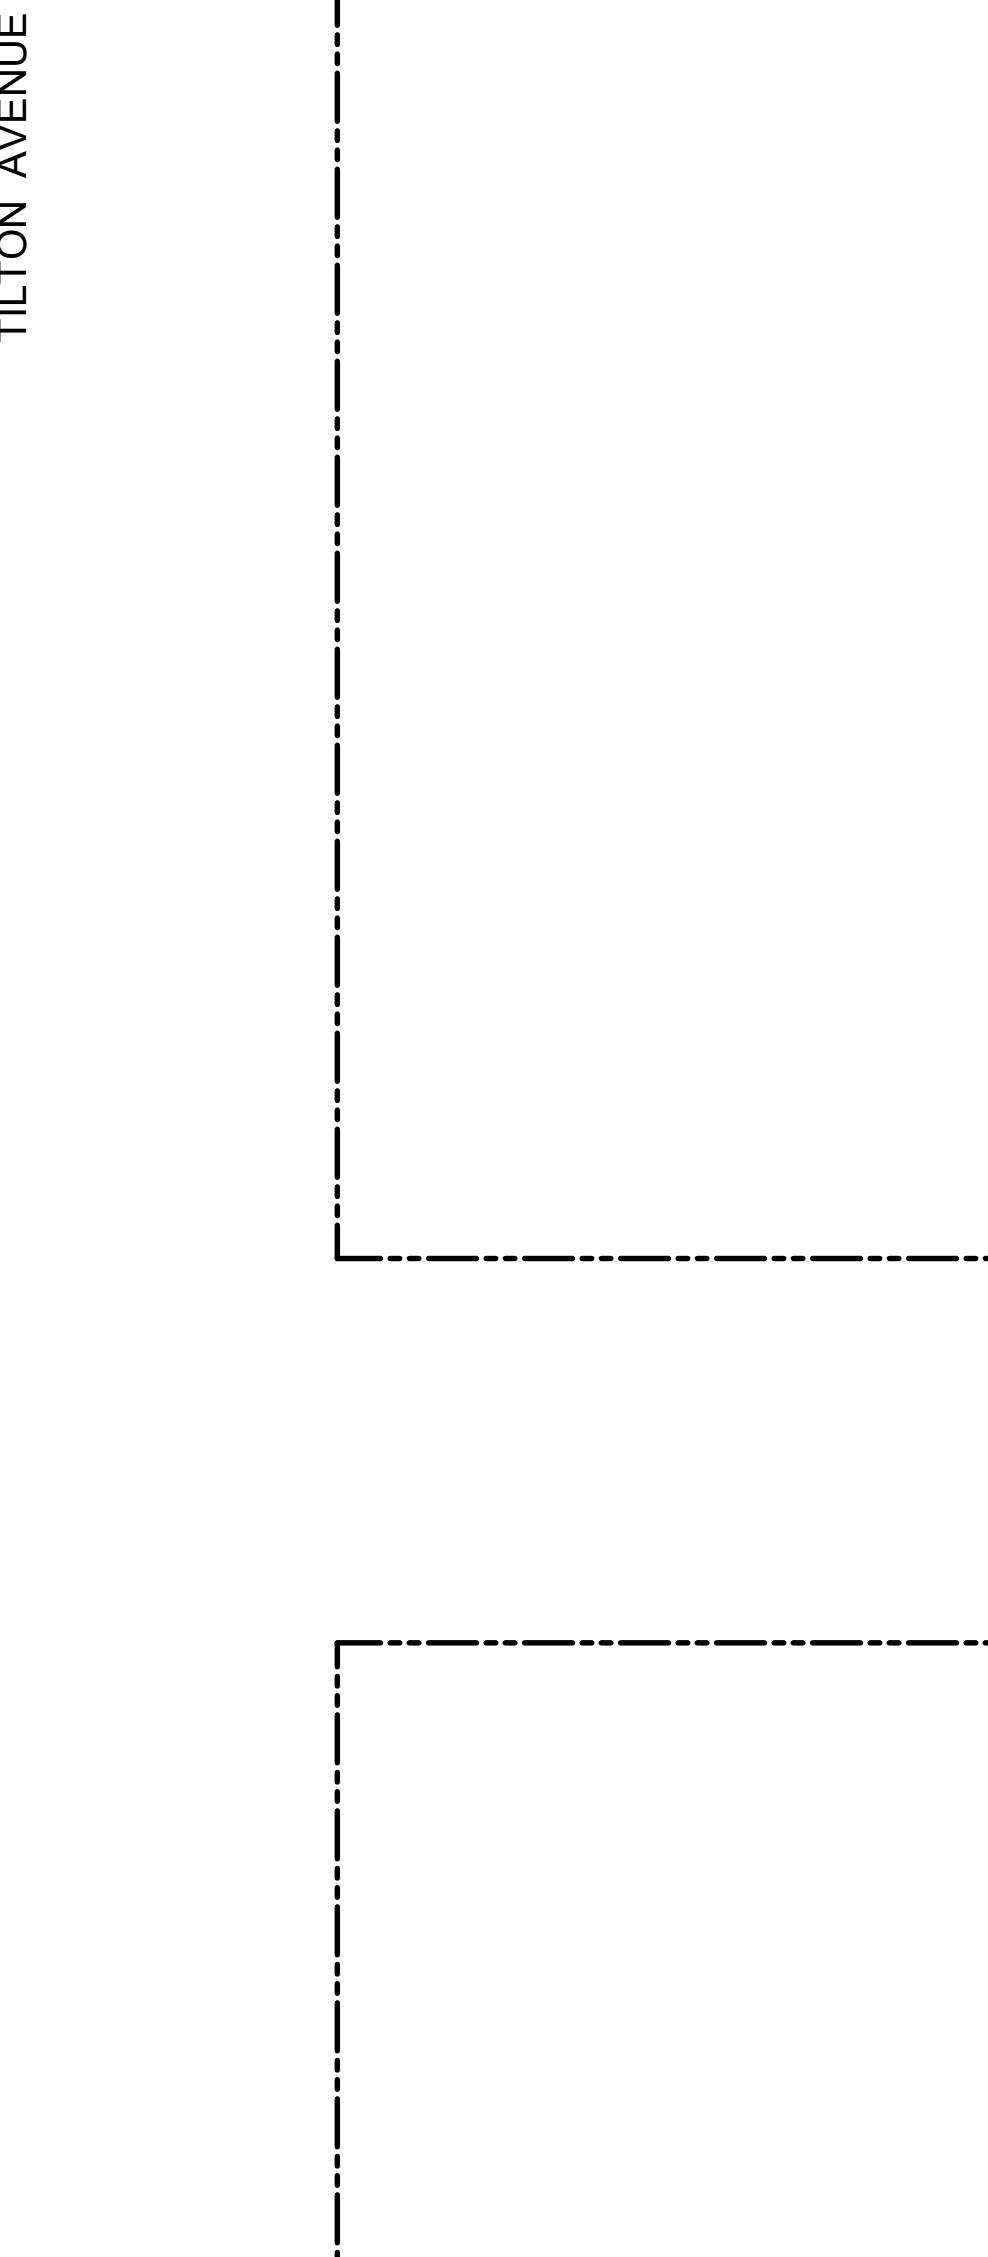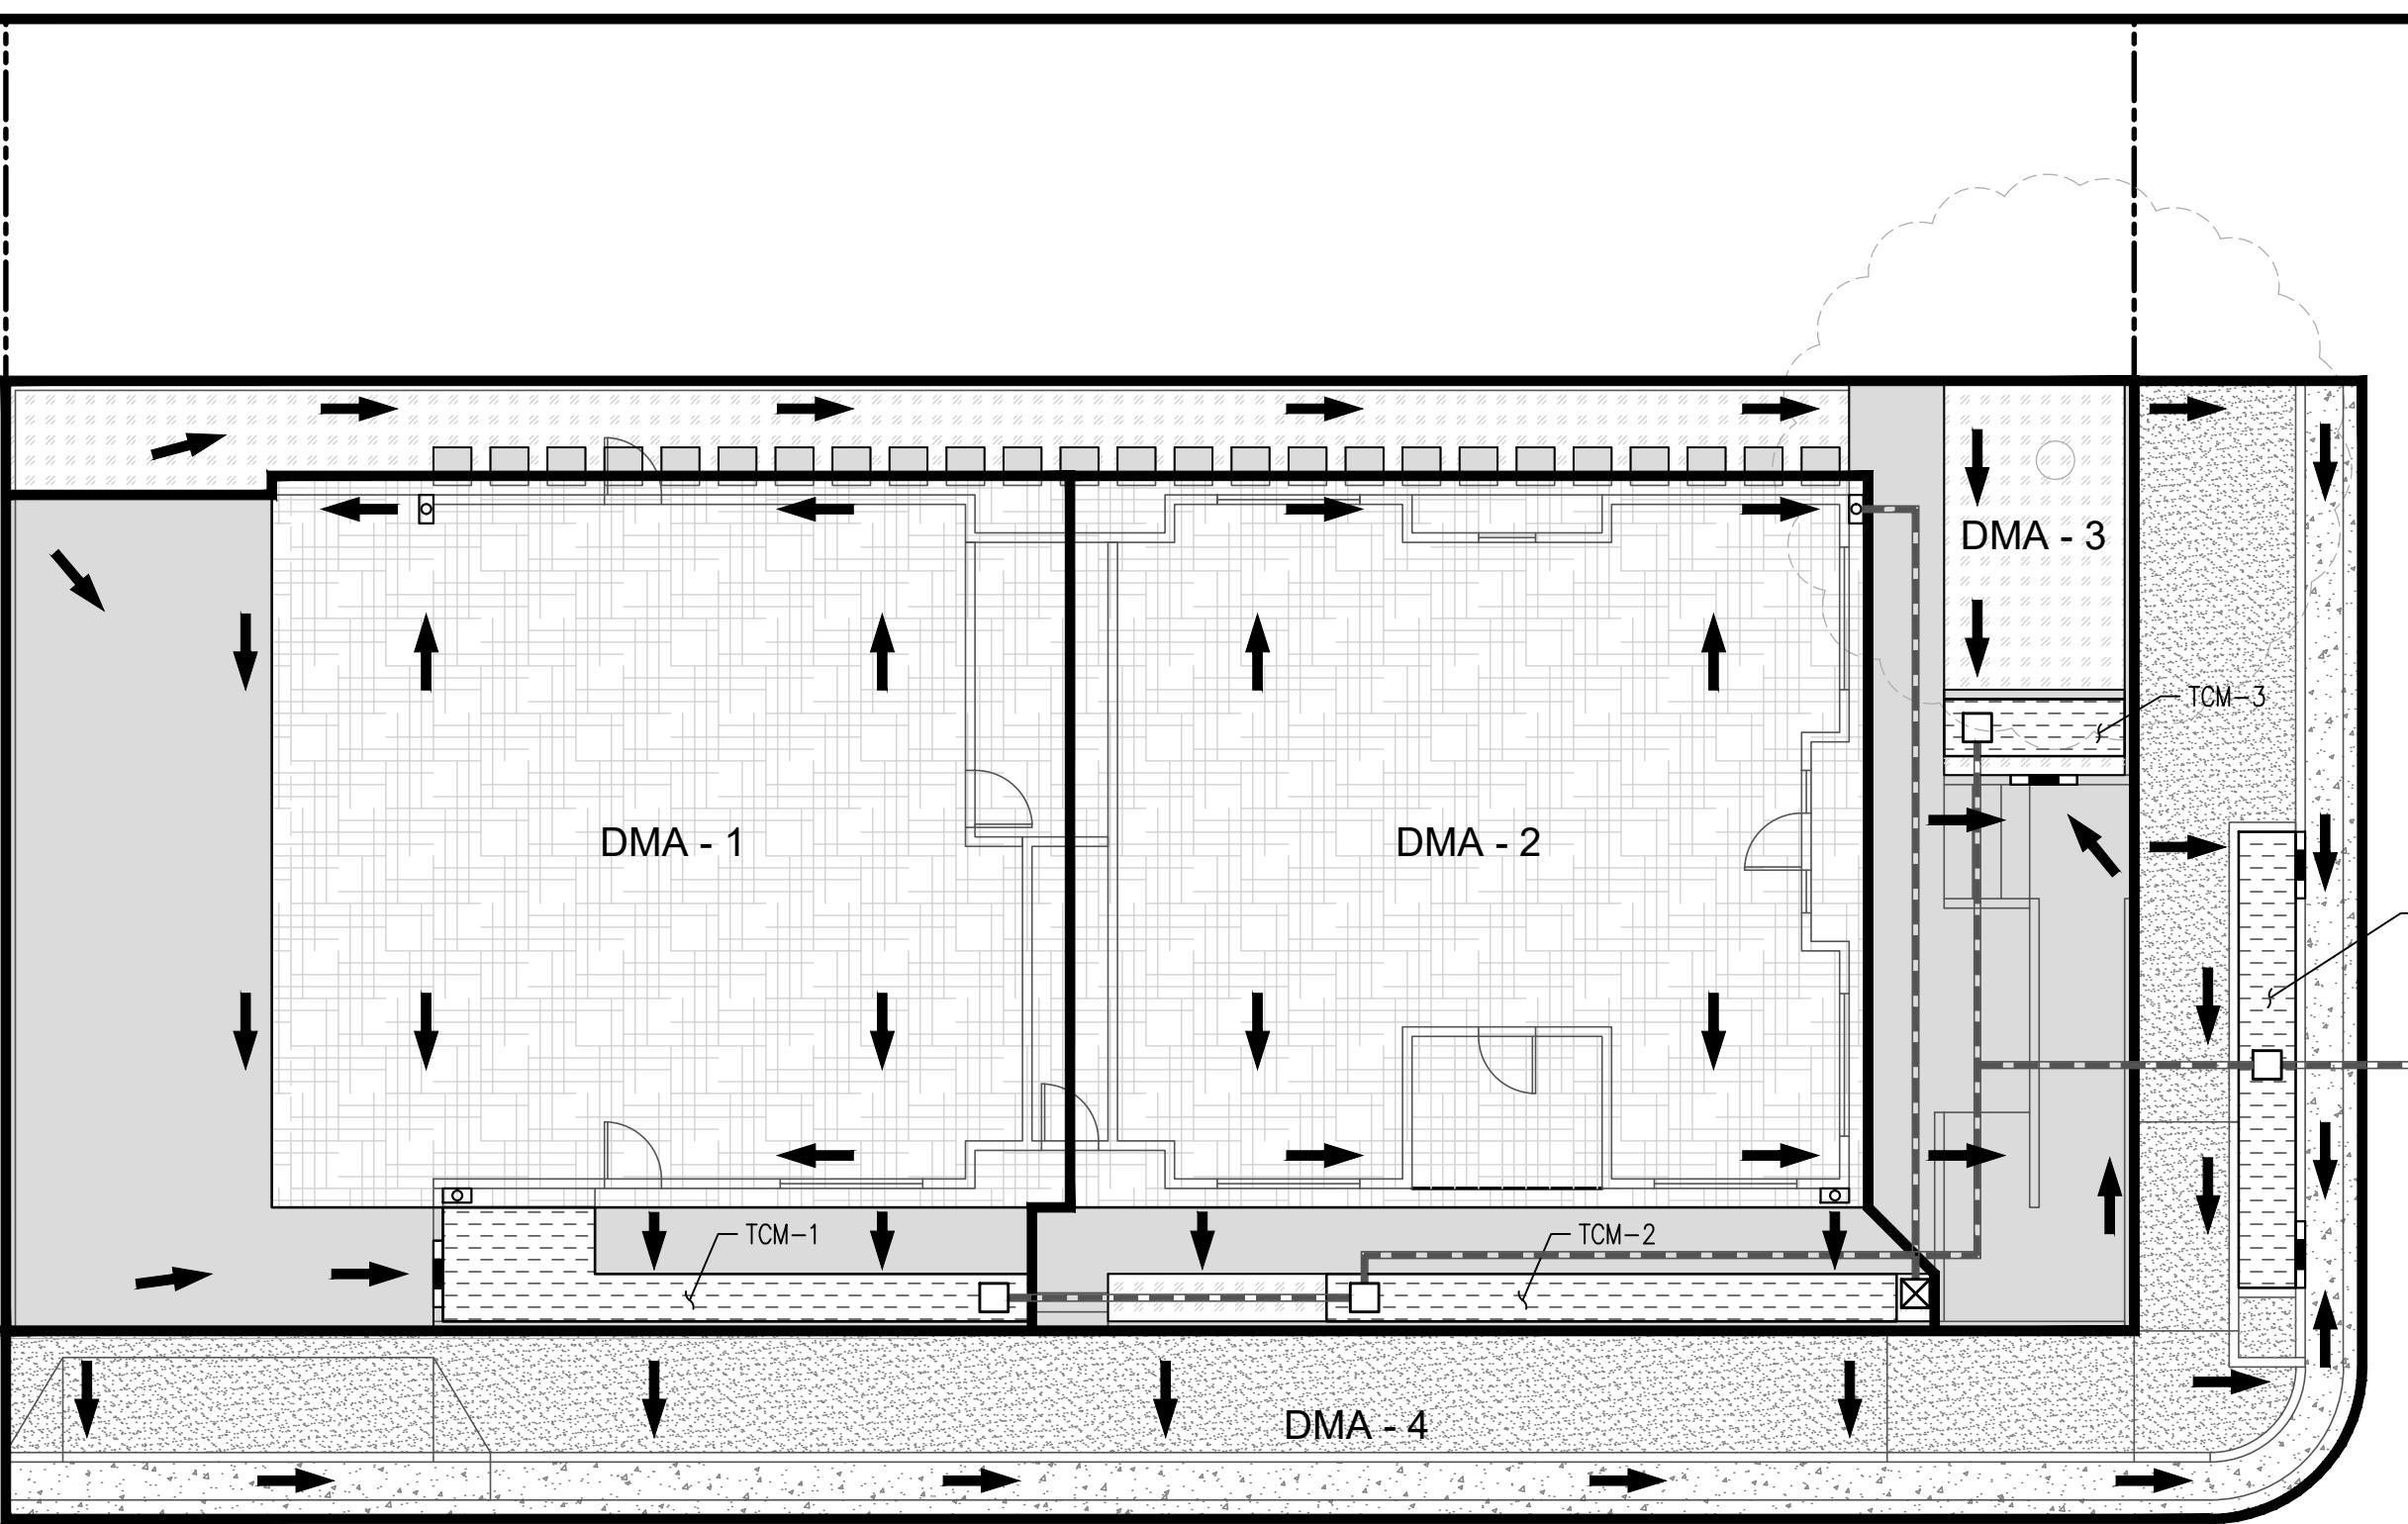


GRAPHIC SCALE
(IN FEET)
1 inch = 10 ft.

LEGEND:

	DESIGNATED TREATMENT CONTROL MEASURE AREA (TCM WITH #)
	ROOF AREA (INCLUDE ROOF EAVE & DOWNSPOUTS)
	ON-SITE IMPERVIOUS ASPHALT OR CONCRETE AREA
	ON-SITE LANDSCAPE AREAS
	OFF-SITE IMPERVIOUS CONCRETE AREA (SIDWALK)
	OFF-SITE IMPERVIOUS CONCRETE AREA (CURB & GUTTER)
	SD COLLECTION SYSTEM
	CURB OPENINGS
	BUILDING DOWNSPOUTS
	SURFACE FLOW DIRECTION
	OVERFLOW CATCH BASIN
	OUTLET PIPE TO BIORETENTION

RAILROAD AVENUE

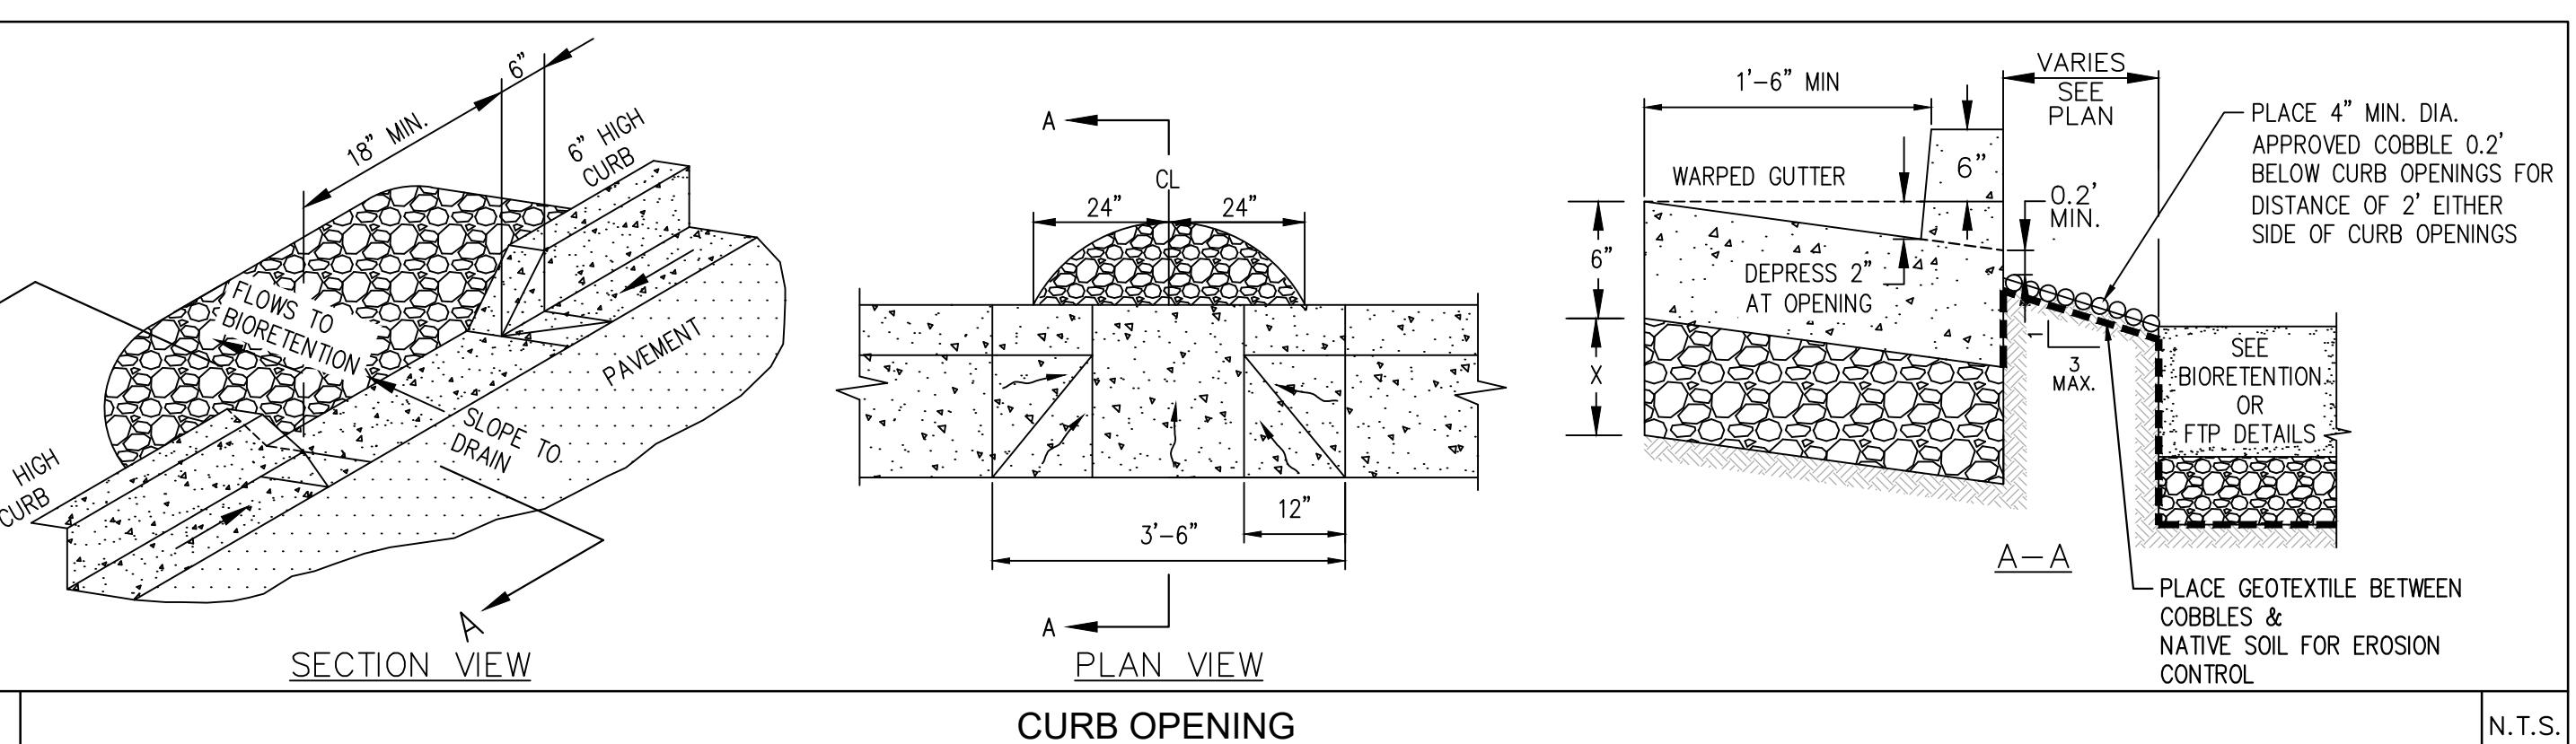

CURB OPENING

N.T.S.

DMA#	TCM#	TREATMENT TYPE	SIZING METHOD	DRAINAGE AREA (SF)	IMPERVIOUS AREA (SF)	PERVIOUS AREA (SF)	% AREA BY TREATED BY LID	BIORETENTION AREA REQUIRED (SF)	BIORETENTION AREA PROVIDED (SF)	BIORETENTION AREA LINED OR UNLINED	OVERFLOW RISER HEIGHT (IN)	STORAGE DEPTH REQUIRED (FT)	STORAGE DEPTH PROVIDED (FT)	LOCATION	CORRESPONDING DETAIL
1	1	BIORETENTION (BELOW GRADE)	FLOW	2,493	2,387	106	33.6%	95.9	106	LINED	6	0.5	0.5	ONSITE	1
2	2	BIORETENTION (BELOW GRADE)	FLOW	1,920	1,811	109	25.9%	72.9	75	LINED	6	0.5	0.5	ONSITE	1
3	3	BIORETENTION (BELOW GRADE)	FLOW	1,187	571	616	16%	25.3	28	LINED	6	0.5	0.5	ONSITE	2
4	4	BIORETENTION (BELOW GRADE)	FLOW	1,813	1,732	81	24.5%	69.6	72	LINED	6	0.5	0.5	OFFSITE	3
						7,413	6,501	912	100%						

3

CURB OPENING

N.T.S.

DOWNSPOUT NOTE:
IN THE EVENT ONLY ONE DOWNSPOUT IS LOCATED WITHIN BIORETENTION, CONTRACTOR SHALL INSTALL A FLOW SPREADER AT THE DOWNSPOUT TO ENSURE PROPER DISTRIBUTION OF STORMWATER OVER THE ENTIRE PLANTER.

NOTES:
1. PLACE 3 INCHES OF COMPOSTED, NON-FLOATABLE MULCH IN AREAS BETWEEN STORMWATER PLANTINGS.
2. PROJECT WILL NOT LOCATE TREES DIRECTLY IN LINE WITH OR NEXT TO STORMWATER INLETS (BUBBLE BOX EMMITTERS, ETC.) AND WILL OFFSET OR RELOCATE TREES WHERE NECESSARY TO MAXIMIZE RUNOFF DISPERAL THROUGHOUT BIORETENTION AREAS

1 BIORETENTION (BELOW GRADE)

N.T.S.

2 BIORETENTION (BELOW GRADE)

N.T.S.

NOTES:
1. PLACE 3 INCHES OF COMPOSTED, NON-FLOATABLE MULCH IN AREAS BETWEEN STORMWATER PLANTINGS.
2. PROJECT WILL NOT LOCATE TREES DIRECTLY IN LINE WITH OR NEXT TO STORMWATER INLETS (BUBBLE BOX EMMITTERS, ETC.) AND WILL OFFSET OR RELOCATE TREES WHERE NECESSARY TO MAXIMIZE RUNOFF DISPERAL THROUGHOUT BIORETENTION AREAS

48" DEEDED CURB; #4 REBAR 12" EACH WAY	WATERPROOF IMPERMEABLE 15 MIL PLASTIC MEMBRANE (ALL SIDES)	48" DEEDED CURB; #4 REBAR 12" EACH WAY	WATERPROOF IMPERMEABLE 15 MIL PLASTIC MEMBRANE (ALL SIDES)	48" DEEDED CURB; #4 REBAR 12" EACH WAY	WATERPROOF IMPERMEABLE 15 MIL PLASTIC MEMBRANE (ALL SIDES)
12" MIN. OF CLASS II PERMEABLE ROCK PER CALTRANS SPECS, ROCK SECTION TO INCREASE WITH SLOPE OF PIPE.	PERFORATED PIPE (SLOPE AT 0.50% MIN) W/ PERFORATIONS DOWN. SEE PLAN FOR LENGTH AND LOCATION.	12" MIN. OF CLASS II PERMEABLE ROCK PER CALTRANS SPECS, ROCK SECTION TO INCREASE WITH SLOPE OF PIPE.	PERFORATED PIPE (SLOPE AT 0.50% MIN) W/ PERFORATIONS DOWN. SEE PLAN FOR LENGTH AND LOCATION.	12" MIN. OF CLASS II PERMEABLE ROCK PER CALTRANS SPECS, ROCK SECTION TO INCREASE WITH SLOPE OF PIPE.	PERFORATED PIPE (SLOPE AT 0.50% MIN) W/ PERFORATIONS DOWN. SEE PLAN FOR LENGTH AND LOCATION.
NOTES: 1. PLACE 3 INCHES OF COMPOSTED, NON-FLOATABLE MULCH IN AREAS BETWEEN STORMWATER PLANTINGS. 2. PROJECT WILL NOT LOCATE TREES DIRECTLY IN LINE WITH OR NEXT TO STORMWATER INLETS (BUBBLE BOX EMMITTERS, ETC.) AND WILL OFFSET OR RELOCATE TREES WHERE NECESSARY TO MAXIMIZE RUNOFF DISPERAL THROUGHOUT BIORETENTION AREAS	NOTES: 1. PLACE 3 INCHES OF COMPOSTED, NON-FLOATABLE MULCH IN AREAS BETWEEN STORMWATER PLANTINGS. 2. PROJECT WILL NOT LOCATE TREES DIRECTLY IN LINE WITH OR NEXT TO STORMWATER INLETS (BUBBLE BOX EMMITTERS, ETC.) AND WILL OFFSET OR RELOCATE TREES WHERE NECESSARY TO MAXIMIZE RUNOFF DISPERAL THROUGHOUT BIORETENTION AREAS
1 TCM-1 2 TCM-2	1 TCM-3 2 TCM-4

1 BIORETENTION (BELOW GRADE)

N.T.S.

NOTES:
1. PLACE 3 INCHES OF COMPOSTED, NON-FLOATABLE MULCH IN AREAS BETWEEN STORMWATER PLANTINGS.
2. PROJECT WILL NOT LOCATE TREES DIRECTLY IN LINE WITH OR NEXT TO STORMWATER INLETS (BUBBLE BOX EMMITTERS, ETC.) AND WILL OFFSET OR RELOCATE TREES WHERE NECESSARY TO MAXIMIZE RUNOFF DISPERAL THROUGHOUT BIORETENTION AREAS

2 BIORETENTION (BELOW GRADE)

N.T.S.

3 BIORETENTION (BELOW GRADE)

N.T.S.

4 BIORETENTION (BELOW GRADE)

N.T.S.

PRELIMINARY
STORMWATER CONTROL PLAN
ANDRIKA PRASAD RESIDENCE
328 TILTON AVENUE
SAN MATEO, CA 94401

GREEN
CIVIL ENGINEERING, INC
INFO@GREEN-CE.COM
1900 S. NORFOLK ST. SUITE #350
SAN MATEO, CA 94403

REGISTERED PROFESSIONAL
CIVIL ENGINEER
NO. 735881
CIVIL
STATE OF CALIFORNIA
EXPIRED 12/31/2024

SCALE
VERTICAL: 1" = AS SHOWN
HORIZONTAL: 1" = AS SHOWN

DATE: 3/21/24
DESIGNED: HCL
DRAWN: BL
REVIEWED: HCL
JOB NO.: 20230022
SHEET
C2.0
2 OF 4 SHEETS

Worksheet for Calculating the Combination Flow and Volume Method

Instructions: After completing Section 1, make a copy of this Excel file for each Drainage Management Area within the project. Enter information specific to the project and DMA in the cells shaded in yellow. Cells shaded in light blue contain formulas and values that will be automatically calculated.

1.0 Project Information
1.1 Project Name: New Multi-Family Units
1.2 Construction ID: PA-2023-011
1.3 Site Address or APN: 328 Tilton Ave, San Mateo
1.4 Tract or Parcel Map No:
1.5 Rainfall Region: 6
1.6 Region Mean Annual Precipitation (MAP) 20.10
1.7 Site Mean Annual Precipitation (MAP) 22

MAP adjustment factor is automatically calculated as: **1.09**

(The "Site Mean Annual Precipitation (MAP)" is multiplied by the MAP adjustment factor, shown in Table 5-3, below.)

Refer to the map in Appendix C of the C3 Technical Guidance to identify the Rainfall Region for the site.

2.0 Calculate Percentage of Impervious Surface for Drainage Management Area (DMA)

2-1 Name of DMA:	1
For items 2-2 and 2-3, enter the areas in square feet for each type of surface within the DMA.	
Type of Surface	Area of surface type within DMA
2-2 Impervious surface	2,387 1.0 2,387
2-3 Pervious surface	106 0.1 11
Total DMA Area (square feet) =	2,493

Total Effective Impervious Area (EIA) **2,398** Square feet

3.0 Calculate Unit Basin Storage Volume in Inches

Table 5-3. Unit Basin Storage Volumes in Inches for 80 Percent Capture Using 48-Hour Drawdowns, based on runoff coefficient			
Region	Station, and Mean Annual Precipitation (Inches)	Runoff Coefficient of 1.0	Runoff Coefficient of 0.8
1	Redwood City, 55.8"	2.00"	1.60"
2	La Honda, 44.8"	0.87"	0.70"
3	Half Moon Bay, 25.52"	0.82"	0.66"
4	Palo Alto, 34.6"	0.64"	0.51"
5	San Jose, 21.07"	0.57"	0.45"
6	San Francisco airport, 20.1"	0.85"	0.72"
7	San Francisco Oceanview, 19.3"	0.72"	0.59"

Unit basin storage volume from Table 5-3: **0.85**

(The coefficient for this method is always 1.0, due to the conversion of any landscaping to effective impervious area.)

Adjusted unit basin storage volume (item 3-1) **0.93** Inches

(The unit basin storage volume [item 3-1] is adjusted by applying the MAP adjustment factor [item 4-8].)

Required Capture Volume (in cubic feet) **186** Cubic feet

(The adjusted unit basin storage volume [item 3-2] is multiplied by the DMA EIA [item 2-4] and converted to cubic feet.)

4.0 Calculate the Duration of the Rain Event

4-1 Rainfall Intensity **0.2** Inches per hour

4-2 Divide item 3-2 by item 4-1 **4.65** Hours of Rain Event Duration

5.0 Preliminary Estimate of Surface Area of Treatment Measure

5-1 40% of DMA EIA (item 2-4)	95,904 Square feet
5-2 Area 5-1 is smaller than item 5-1 (i.e., 3% of DMA EA)	71,928 Square feet
5-3 Volume of treated runoff for area in item 5-2	139.41 Cubic feet (item 5-2 * 5 inches per hour * 1/12 * item 4-2)

6.0 Minimum Adjustment of Depth of Surface Pounding Area

6-1 Subtract item 5-3 from item 5-2 **66.47** Cubic feet (amount of runoff to be stored in ponding area)

6-2 Divide item 6-1 by item 5-2 **0.65** Feet (depth of stored runoff in surface ponding area)

6-3 Convert item 6-2 from feet to inches **7.75** Inches (depth of stored runoff in surface ponding area)

6-4 If ponding depth in item 6-3 meets your target depth (recommend 6"), skip to item 8-1. If not, continue to Step 7-1.

(Note: Overflow outlet elevation should be set based on the calculated ponding depth.)

7.0 Optimize Size of Treatment Measure

7-1 Enter an area larger than item 5-2 **106** Sq.ft. (enter larger area if you need less ponding depth.)

7-2 Volume of treated runoff for area in item 7-1 **205.45** Cubic feet (item 7-1 * 5 inches per hour * 1/12 * item 4-2)

7-3 Subtract item 7-2 from item 3-3 **-19.57** Cubic feet (amount of runoff to be stored in ponding area)

7-4 Divide item 7-3 by item 7-1 **-0.18** Feet (depth of stored runoff in surface ponding area)

7-5 Convert item 7-4 from ft. to inches **2.22** Inches (depth of stored runoff in surface ponding area)

7-6 If the ponding depth in item 7-5 is less than target depth (stop here. If not, repeat Steps 7-1 through 7-5 until you obtain target depth.)

(Note: Overflow outlet elevation should be set based on the calculated ponding depth.)

8.0 Surface Area of Treatment Measure for DMA

8-1 Final surface area of treatment **106** Square feet (either item 5-2 or final amount in item 7-1)

Worksheet for Calculating the Combination Flow and Volume Method

Instructions: After completing Section 1, make a copy of this Excel file for each Drainage Management Area within the project. Enter information specific to the project and DMA in the cells shaded in yellow. Cells shaded in light blue contain formulas and values that will be automatically calculated.

1.0 Project Information
1.1 Project Name: New Multi-Family Units
1.2 Construction ID: PA-2023-011
1.3 Site Address or APN: 328 Tilton Ave, San Mateo
1.4 Tract or Parcel Map No:
1.5 Rainfall Region: 6
1.6 Region Mean Annual Precipitation (MAP) 20.10
1.7 Site Mean Annual Precipitation (MAP) 22

MAP adjustment factor is automatically calculated as: **1.09**

(The "Site Mean Annual Precipitation (MAP)" is multiplied by the MAP adjustment factor, shown in Table 5-3, below.)

Refer to the map in Appendix C of the C3 Technical Guidance to identify the Rainfall Region for the site.

2.0 Calculate Percentage of Impervious Surface for Drainage Management Area (DMA)

2-1 Name of DMA:	1
For items 2-2 and 2-3, enter the areas in square feet for each type of surface within the DMA.	
Type of Surface	Area of surface type within DMA
2-2 Impervious surface	2,387 1.0 2,387
2-3 Pervious surface	106 0.1 11

Total DMA Area (square feet) = **2,493**

Total Effective Impervious Area (EIA) **2,398** Square feet

3.0 Calculate Unit Basin Storage Volume in Inches

Table 5-3. Unit Basin Storage Volumes in Inches for 80 Percent Capture Using 48-Hour Drawdowns, based on runoff coefficient			
Region	Station, and Mean Annual Precipitation (Inches)	Runoff Coefficient of 1.0	Runoff Coefficient of 0.8
1	Redwood City, 55.8"	2.00"	1.60"
2	La Honda, 44.8"	0.87"	0.70"
3	Half Moon Bay, 25.52"	0.82"	0.66"
4	Palo Alto, 34.6"	0.64"	0.51"
5	San Jose, 21.07"	0.57"	0.45"
6	San Francisco airport, 20.1"	0.85"	0.72"
7	San Francisco Oceanview, 19.3"	0.72"	0.59"

Unit basin storage volume from Table 5-3: **0.85**

(The coefficient for this method is always 1.0, due to the conversion of any landscaping to effective impervious area.)

Adjusted unit basin storage volume (item 3-1) **0.93** Inches

(The unit basin storage volume [item 3-1] is adjusted by applying the MAP adjustment factor [item 4-8].)

Required Capture Volume (in cubic feet) **186** Cubic feet

(The adjusted unit basin storage volume [item 3-2] is multiplied by the DMA EA [item 2-4] and converted to cubic feet.)

4.0 Calculate the Duration of the Rain Event

4-1 Rainfall Intensity **0.2** Inches per hour

4-2 Divide item 3-2 by item 4-1 **4.65** Hours of Rain Event Duration

5.0 Preliminary Estimate of Surface Area of Treatment Measure

5-1 40% of DMA EA (item 2-4)	72,876 Square feet
5-2 Area 5-1 is smaller than item 5-1 (i.e., 3% of DMA EA)	54,657 Square feet
5-3 Volume of treated runoff for area in item 5-2	105.94 Cubic feet (item 5-2 * 5 inches per hour * 1/12 * item 4-2)

6.0 Minimum Adjustment of Depth of Surface Pounding Area

6-1 Subtract item 5-3 from item 5-2 **12,213** Cubic feet (amount of runoff to be stored in ponding area)

6-2 Divide item 6-1 by item 5-2 **0.65** Feet (depth of stored runoff in surface ponding area)

6-3 Convert item 6-2 from feet to inches **7.75** Inches (depth of stored runoff in surface ponding area)

6-4 If ponding depth in item 6-3 meets your target depth (recommend 6"), skip to item 8-1. If not, continue to Step 7-1.


(Note: Overflow outlet elevation should be set based on the calculated ponding depth.)

7.0 Optimize Size of Treatment Measure

7-1 Enter an area larger than item 5-2 **106** Sq.ft. (enter larger area if you need less ponding depth.)

7-2 Volume of treated runoff for area in item 7-1 **205.45** Cubic feet (item 7-1 * 5 inches per hour * 1/12 * item 4-2)

7-3 Subtract item 7

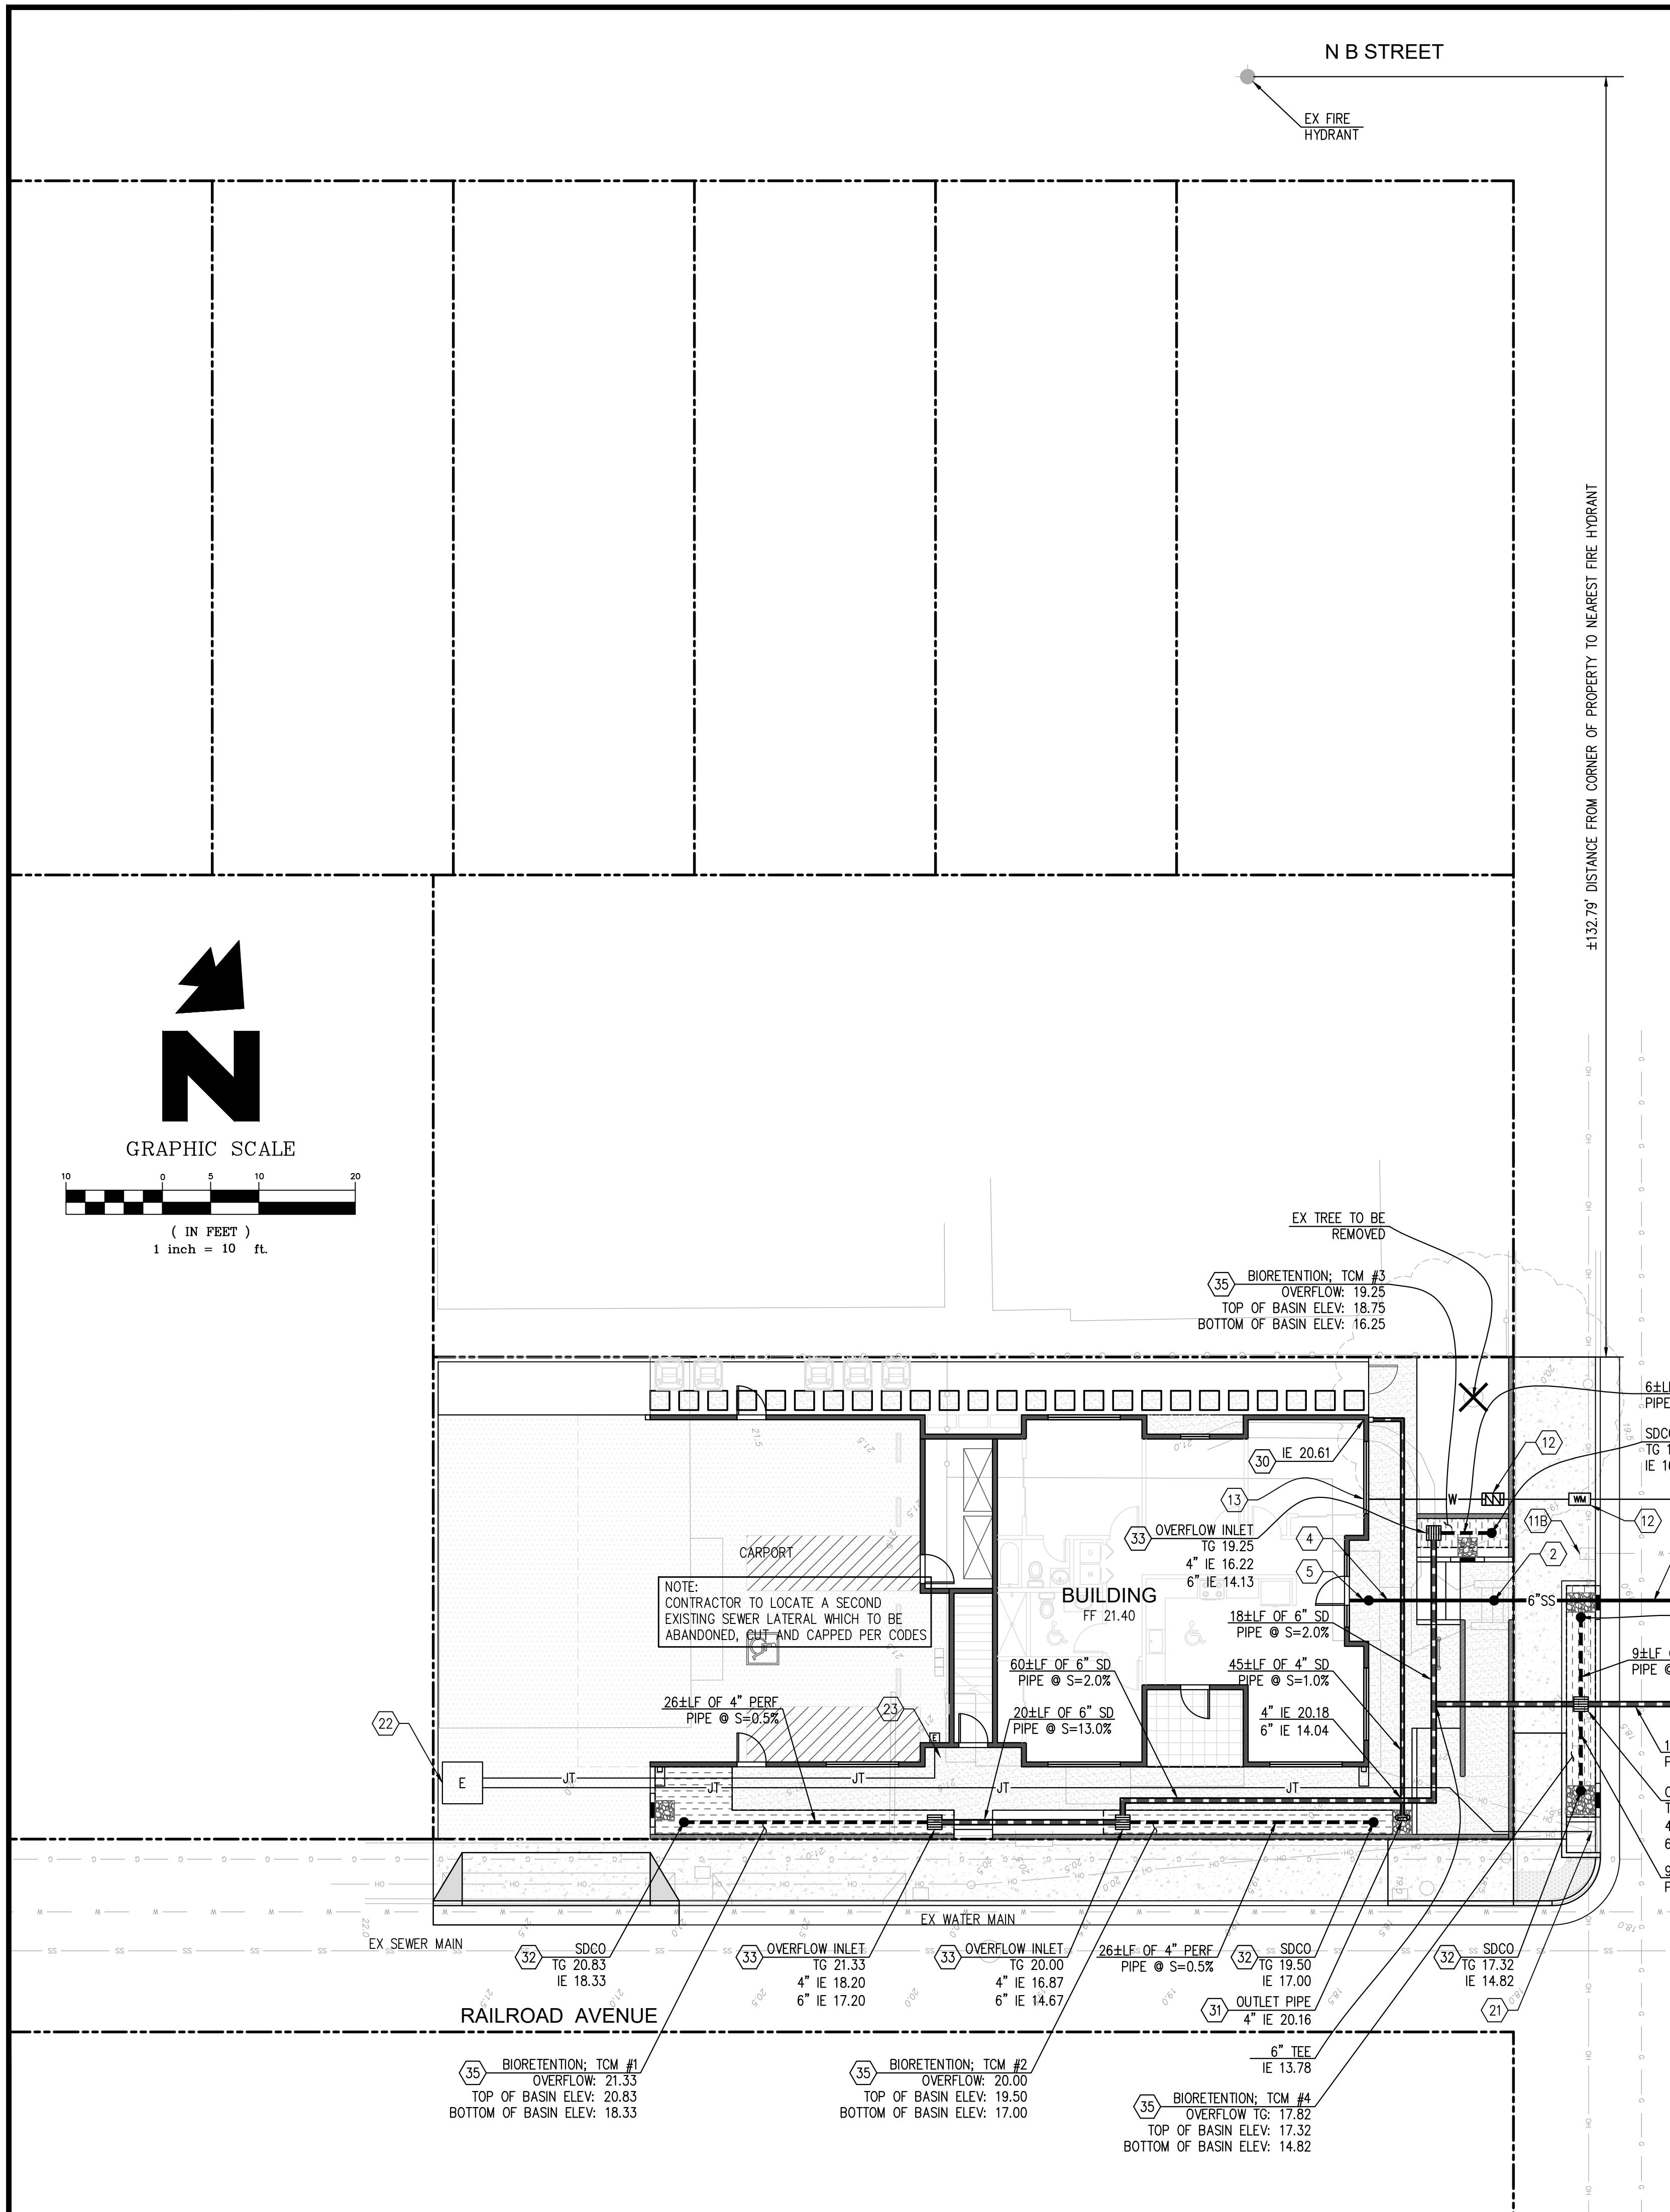

REV.	DATE	DESCRIPTION
△	3/23/24	REVISION PER PLANNING COMMENTS, 12/1/23
△	8/2/24	REVISION PER PLANNING COMMENTS, 4/24/24
△	11/20/24	REVISION PER PLAN CHECK COMMENTS

LEGEND

ABBREVIATIONS:

BC = BOTTOM OF CURB	FG = FINISHED GRADE	S = SLOPE
BOW = BACK OF SIDEWALK	FL = FLOWLINE	SD = STORM DRAIN
BW = BOTTOM OF WALL	G = GARAGE	TC = TOP OF CURB
C = CONCRETE	GB = GRADE BREAK	TG = TOP OF GRATE
EG = EXISTING GRADE/GROUND	IE = INVERT ELEVATION	TP = TOP OF PAVEMENT
EX = EXISTING	LF = LINEAL FEET	TW = TOP OF WALL
FF = FINISHED FLOOR	P = PORCH/PATIO	TYP = TYPICAL

UTILITY NOTES

1. CONNECT NEW 6" SEWER LATERAL TO EXISTING SANITARY SEWER MAIN. MATCH EXISTING INVERT ELEVATION
2. INSTALL SANITARY SEWER CLEANOUT WITHIN 5' OF PROPERTY LINE.
3. REMOVE EXISTING SEWER LATERAL AND REPLACE WITH NEW 6" SANITARY SEWER LATERAL TO NEW BUILDING @ 2% SLOPE MINIMUM
4. SANITARY SEWER CLEANOUT AT 2' OUTSIDE OF BUILDING
5. SANITARY SEWER SERVICE ENTRY TO BUILDING. SEE ARCH PLANS FOR EXACT LOCATION AND LINE CONTINUATION TO BUILDING
6. CONNECT NEW WATER SERVICE LINE TO EXISTING WATER MAIN
7. EXISTING WATER SERVICE LINE TO BE ABANDONED OR REMOVAL PER SAN MATEO WATER COMPANY STANDARD
8. EXISTING WATER METER TO BE REMOVED BY SAN MATEO WATER COMPANY
9. INSTALL NEW WATER METER BY SAN MATEO WATER COMPANY
10. DOMESTIC WATER LINE POINT OF ENTRY. SEE PLUMBING PLANS FOR WATER LINE SIZE AND LINE CONTINUATION
11. BACKFLOW PREVENTOR; APPLICANT SHALL CONTACT CALWATER AND SHALL PROVIDE, DURING BUILDING REVIEW, PROOF OF APPROVAL FROM CALWATER FOR NEW BACKFLOW DEVICES.
12. EXISTING POWER POLE. ELECTRICAL, TELECOMMUNICATION & CABLE TV SERVICE CONNECTIONS. COORDINATE WITH LOCAL UTILITY COMPANIES PRIOR TO BEGINNING OF WORK. SEE JOINT TRENCH COMPOSITE PLANS BY OTHERS
13. NEW ELECTRICAL TRANSFORMER. SEE JOINT TRENCH COMPOSITE PLANS BY OTHERS
14. JOINT TRENCH (ELECTRICAL, TELECOMMUNICATION AND CABLE TV) SERVICES POINT OF ENTRY. SEE JOINT TRENCH COMPOSITE PLANS BY OTHERS
15. RAINLEADER AT DOWNSPOUT
16. PIPE OUTFALL WITH "T" END SECTION WITH NDS ATRIUM GRATES TO BIORETENTION;
17. STORM DRAIN CLEANOUT
18. 18"X18" DROP INLET
19. CONNECT TO EXISTING STORM DRAIN MAIN. MATCH EXISTING INVERT ELEVATION
20. BIORETENTION BASIN WITH LINER

GREEN CIVIL ENGINEERING, INC
INFO@GREEN-CE.COM
1900 S. NORFOLK ST. SUITE #350
SAN MATEO, CA 94403

REGISTERED PROFESSIONAL CIVIL ENGINEER
CIVIL HANG WONG
NO. 735881
Exp. 12/31/2024
STATE OF CALIFORNIA

SCALE

VERTICAL: 1" = AS SHOWN
HORIZONTAL: 1" = AS SHOWN

DATE: 3/21/24
DESIGNED: HCL
DRAWN: BL
REVIEWED: HCL
JOB NO.: 20230022

SHEET C3

4 OF 4 SHEETS